

6/19/74

PERMIT

6/20/74

Final R.T.

P 19925

A 19873

SEWAGE DISPOSAL SYSTEM

MARYLAND STATE DEPARTMENT OF HEALTH

HOWARD COUNTY

INDEXED

ELLCOTT CITY

DISTRICT 5

DATE 5/8/74

File INDEXED

Narathon Builders

IS PERMITTED TO INSTALL ☒ ALTER

ADDRESS 14401 Tarryan Terrace, Silver Spring, Md. PHONE 304-6540

A SEWAGE DISPOSAL SYSTEM LOCATED AT

SUBDIVISION ROAD 4844 Ten Oaks Road LOT

PROPERTY OWNER Robert & Suzanne Hill 6.2799 acres

ADDRESS

SPECIFICATIONS - 4 bedrooms

DRAIN FIELD DEPTH FEET, BOTTOM AREA SQ. FT.

SEEPAGE PITS ABSORBENT SIDE-WALL AREA SQ. FT.

SEPTIC TANK CAPACITY 1,250 GALLONS

FOR GARBAGE GRINDER, INCREASE DISPOSAL AREA 225 & TANK CAPACITY 500.

OTHER Dry well - 500 sq. ft. shortest sidewall area, to begin at 2 ft. below original grade. Maximum depth permitted/dry well is 12 ft. Locate dry well 60 ft. to

left of front left corner of house as seen from property line that is 1082.74 long.

(290 ft. from right side line and 50 ft. from front lot line as seen from line that is 1082.74 ft.).

NOTE: ALL PIPE FROM HOUSE TO DRY WELL MUST BE CAST IRON.

PERMIT VOID AFTER THREE YEARS.

PLANS APPROVED BY Robert V. Torre DATE 4/30/74

NOTE: INSTALL STAND PIPE ON SEPTIC TANK AND DRY WELL.

FILL SEPTIC TANK AND DISTRIBUTION BOX WITH WATER BEFORE CALLING FOR AN INSPECTION. COVER NO WORK UNTIL INSPECTED AND APPROVED.

NEITHER THE HOWARD COUNTY COMMISSIONERS NOR THE HEALTH DEPARTMENT IS RESPONSIBLE FOR THE SUCCESSFUL OPERATION OF ANY SYSTEM.

BLOG. PERMIT SIGNED

AND RETURNED 5-30-77


Serial # Bro 105979
above ground port

19873

A58466-B

19925 A 19873

1/4
7 1/2
336
27
360

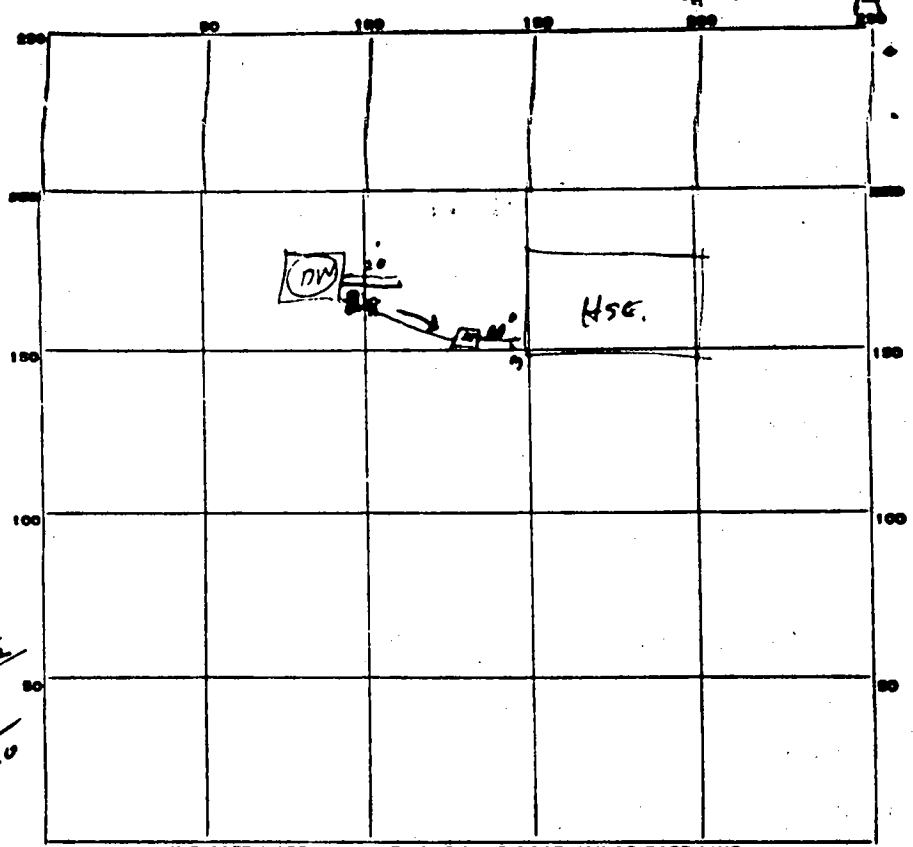

PERMIT CARD Sept

SEPTIC TANK, LEVEL 1350 gal. CLEANOUTS OK

DISTRIBUTION BOX, LEVEL -

TILE FIELD, DEPTH 8 1/2 FT. TRENCH WIDTH 2 FT.

GRAVEL DEPTH Sept IN. TOTAL LENGTH 20 FT.

NUMBER OF TRENCHES 1 Subsided
TOTAL BOTTOM AREA 110 sq ft (one side)

SEEPAGE PITS, outside perimeter 12412 FT. DEPTH BELOW INLET 7 1/2 FT.

ABSORBENT AREA 470 SQ. FT.

REMARKS 6/19/74 1st Set to Discharge 3 FT Below grade R/H
FINISH DITCH, DPT WEL. & TANK & CALL FOR RE-INSPECTION R/H
(light location)

DATE SYSTEM APPROVED 6/20/74 INSPECTOR R. Turner

APPLICATION

HOWARD COUNTY

SERIAL NUMBER

PERMIT APPLICATION

DEPARTMENT OF INSPECTIONS, LICENSES & PERMIT

3430 COURT HOUSE DRIVE, ELLICOTT CITY, MARYLAND 21043

B00105929

BUILDING ADDRESS (HOUSE NO., STREET, TOWN OR AREA)

4844 Ten Oaks Road
Dayton Md 21036

29235

GRADING/SEDIMENT CONTROL ☐ YES ☐ NO

SDP #

DESCRIPTION OF WORK AUTHORIZED

Above Ground Pool
18' x 41' x 52" deep truck filled
Fenced

LOT NO. PARCEL NO. SEC. AREA BLOCK NO. LIBER FOLIO

SUB DIVISION

ZONE

ZONE MAP

ELEC. DIST.

CENSUS TR.

OWNER NAME AND ADDRESS

PHONE NO.

Robert + Suzanne Hill
4844 Ten Oaks Rd

410-331412

OCCUPANT'S NAME AND ADDRESS

PHONE NO.

Robert + Suzanne Hill
4844 Ten Oaks Road

410 531 4838

ARCHITECT OR ENGINEER'S NAME AND ADDRESS

PHONE NO.

CONTRACTOR'S NAME AND ADDRESS

PHONE NO.

Van Dorn Pools
1711 Main St
Pikesville Md

410 526 9770

EXISTING USE

PROPOSED USE

Single Family Dwelling

Above ground Pool

EST. CONSTRUCTION COST

LICENSE NUMBER

PERMIT FEE

\$10000

13041

W/S CODE

FOR OFFICE USE ONLY

Robert + Hill

DISTANCE IN FEET FROM R/W LINE TO FRONT BUILDING LINE

SIDE YARD

(DISTANCE IN FEET FROM SIDE BLDG. LINE TO SIDE PROPERTY LINE)

TO SIDE BUILDING LINE

DISTANCE IN FEET, REAR YD. REQUIRING SET

BACK (CORNER LOT ONLY)

SDP #

Check payable to: DIRECTOR OF FINANCE OF HOWARD COUNTY

CAUTION

To begin construction before a permit placard has been issued and displayed on the job is a violation of the law.

Use and occupancy permit must be applied for two weeks before it will be issued.

IMPORTANT: PLEASE SHOW ZIP CODES AND AREA CODES WHEREVER REQUIRED.

LP-69-591


FUNCTION	DATE	SIGNATURE APPROVAL
ZONING/PLANNING		
SHA		
SEDIMENT/GRADING		
BUILDING OFFICIAL		
WATER & SEWER		
HEALTH DEPT.	5/30/97	A McMiller
FIRE PROTECTION		
STORM WATER MGM		

APPROVED

DATE

Distribution of Copies:
White - Building Official
Green - Planning & ZoningYellow - Engineering
Pink - Health Dept.
Gold - S.H.A.

A

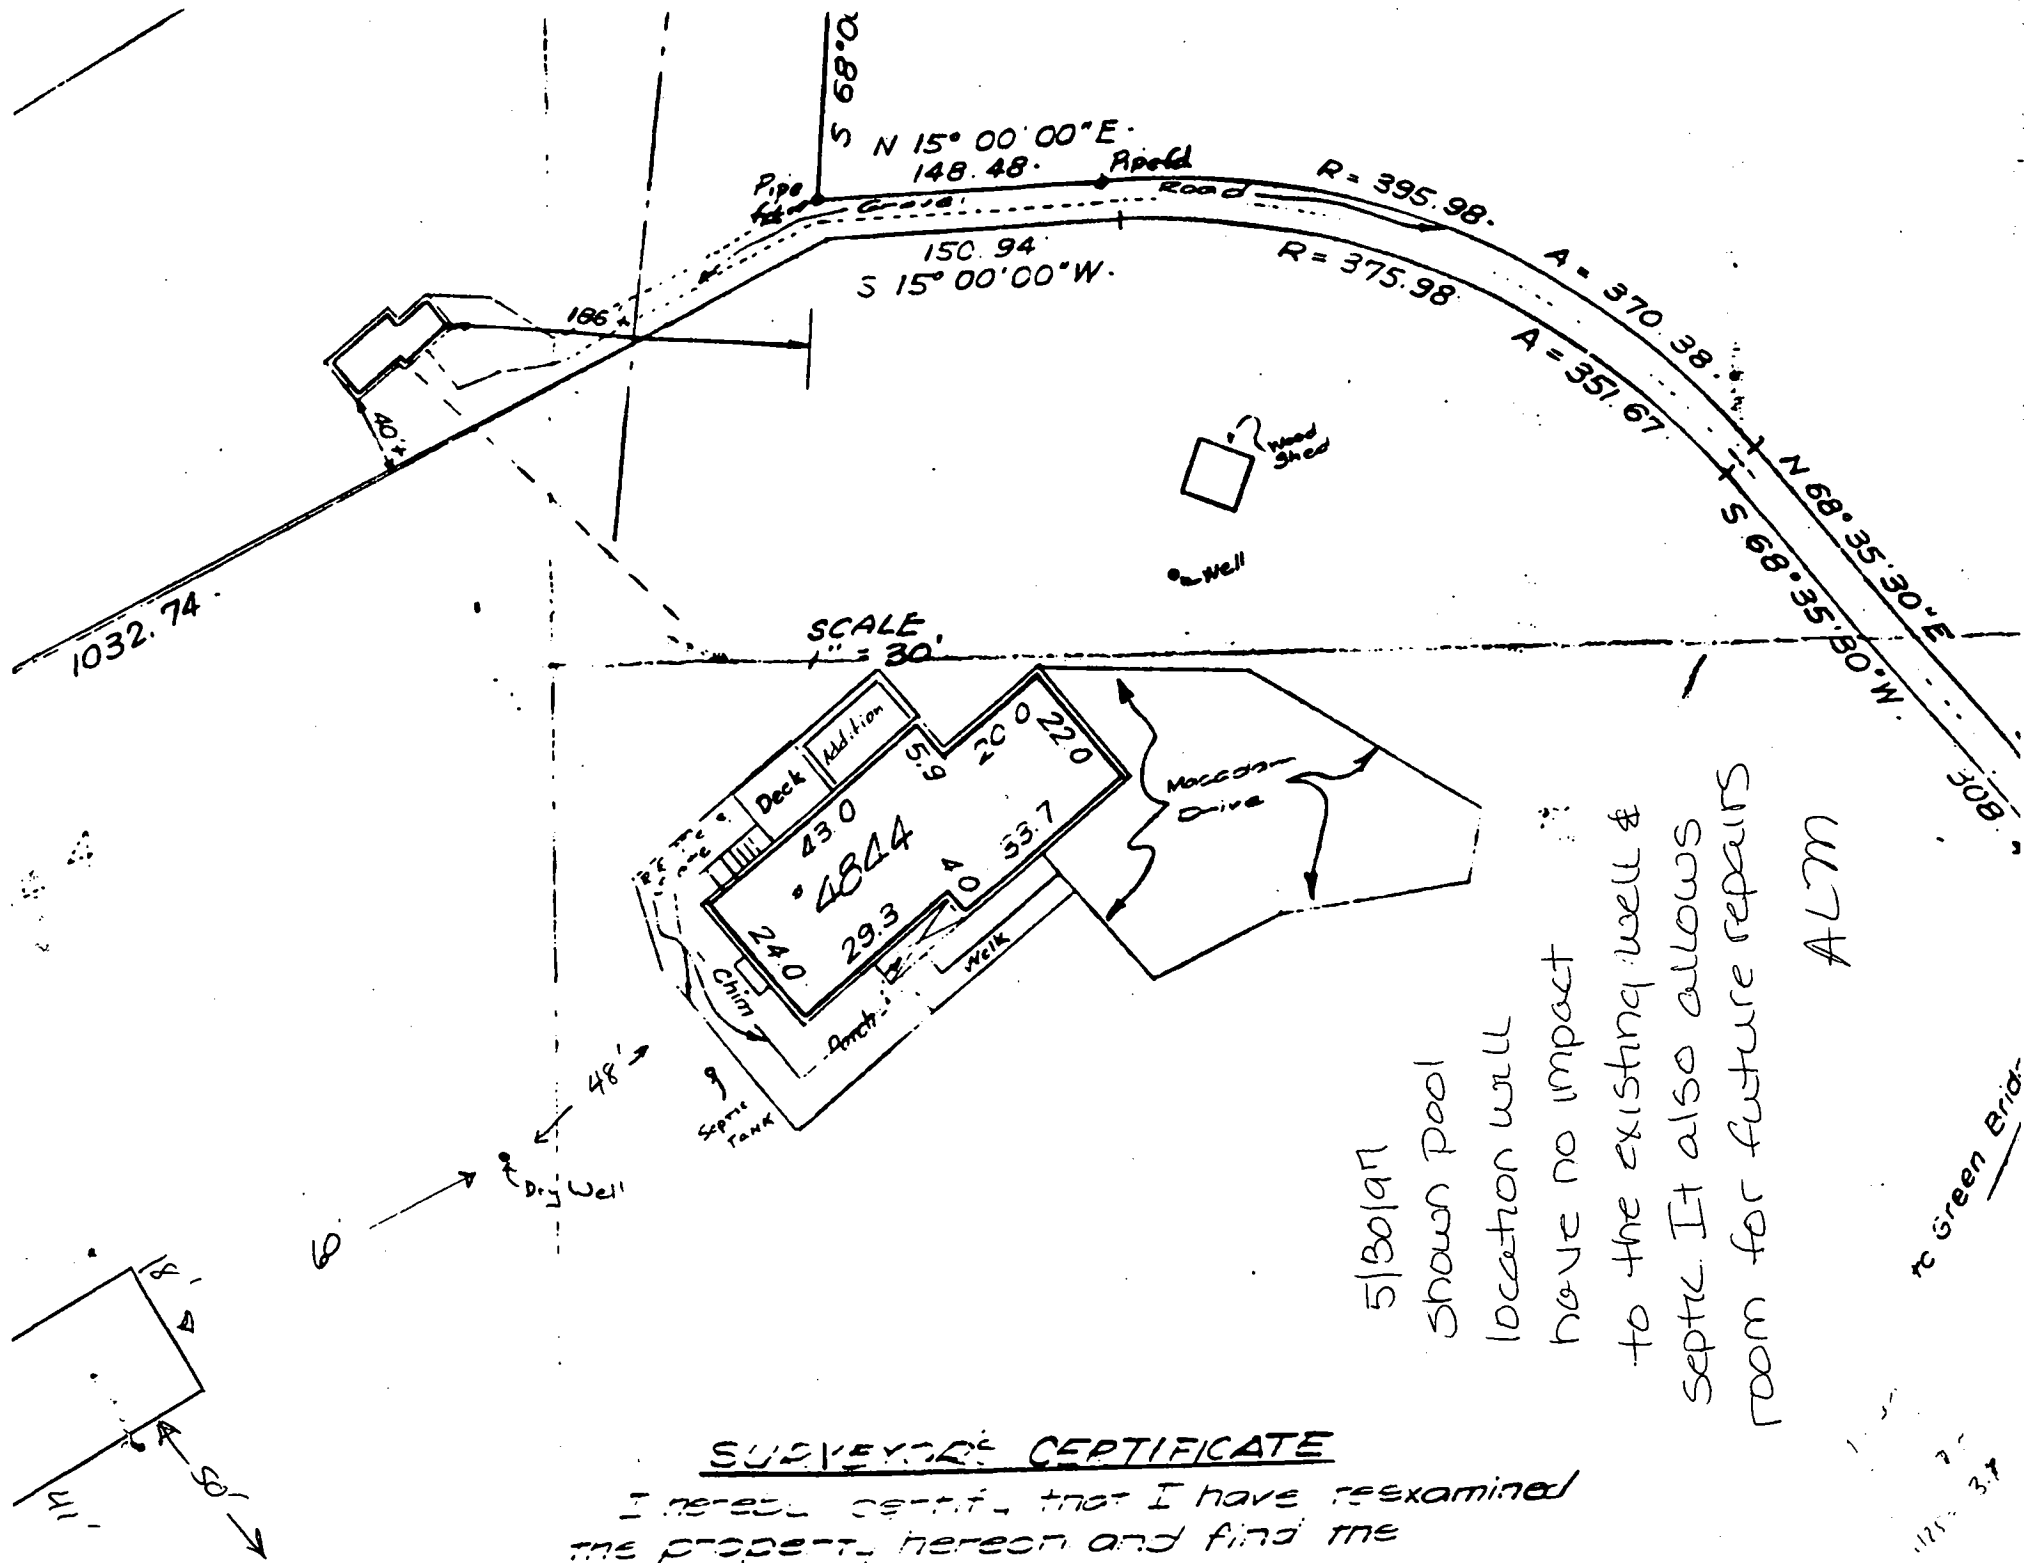

SUPERVISOR'S CERTIFICATE

I hereby certify that I have reexamined the property hereon and find the measurements as shown.