

4608

SEQUENCE NO. (QENV USE ONLY)

STATE OF MARYLAND
WELL COMPLETION REPORT
FILL IN THIS FORM COMPLETELY
PLEASE PRINT OR TYPE

45 DAYS AFTER WELL IS COMPLETED.

COUNTY
NUMBER

PERMIT NO.
FROM "PERMIT TO DRILL WELL"

ST/CD USE ONLY
DATE RECEIVED

DATE WELL COMPLETED

Depth of Well

OWNER

STREET OR RFD

SUBDIVISION

SECTION

LOT

WELL LOG

STATE THE KIND OF FORMATIONS
PENETRATED, THEIR COLOR, DEPTH,
THICKNESS AND IF WATER BEARING

DESCRIPTION (Use
additional sheets if needed)

FEET

Check
if water
bearing

GROUTING RECORD

WELL HAS BEEN GROUTED

TYPE OF GROUTING MATERIAL

CEMENT

BENTONITE CLAY

NO. OF BAGS

NO. OF POUNDS

GALLONS OF WATER

DEPTH OF GROUT SEAL (to nearest foot)

CASING RECORD

OTHER CASING (if used)

SCREEN RECORD

GRAVEL PACK

OEP USE ONLY

TELESCOPE CASING

LOG INDICATOR

OTHER DATA

PUMPING TEST

HOURS PUMPED (nearest hour)

PUMPING RATE (gal. per min.
to nearest gal.)

METHOD USED TO
MEASURE PUMPING RATE

WATER LEVEL (distance from land surface)

BEFORE PUMPING

WHEN PUMPING

TYPE OF PUMP USED (for test)

PUMP INSTALLED

DRILLER WILL INSTALL PUMP

IF DRILLER INSTALLS PUMP, THIS SECTION
MUST BE COMPLETED FOR ALL WELLS
EXCEPT HOME USE

TYPE OF PUMP INSTALLED

PLACE (A,C,J,P,R,S,T,O)

CAPACITY:

GALLONS PER MINUTE

PUMP HORSE POWER

PUMP COLUMN LENGTH

CASING HEIGHT (circle appropriate box
and enter casing height)

LAND SURFACE

LOCATION OF WELL ON LOT

SHOW PERMANENT STRUCTURE SUCH AS
BUILDING, SEPTIC TANKS, AND/OR
LANDMARKS AND INDICATE NOT LESS
THAN TWO DISTANCES
(MEASUREMENTS TO WELL)

<div style="display: flex; justify-content: space-between;"><div>B 1 6159 <small>(THIS NUMBER IS TO BE PUNCHED IN COLS. 3-6 ON ALL CARDS)</small></div><div>SEQUENCE NO. (DP USE ONLY)</div></div>	STATE OF MARYLAND APPLICATION FOR PERMIT TO DRILL WELL please print or type	STATE PERMIT NUMBER 40-88-1994 <small>fill in this form completely</small>
---	---	---

Date Received (APA)
080991

OWNER INFORMATION
8 13
CRANDORFF PEGGY
15 Last Name 34 First Name
4901 TEN OAKS RD
36 Street or RFD 55
DAYTON MO 21036
57 Town 70 State 72 Zip 76

DRILLER INFORMATION
RALPH MAYNE
Driller's Name 77 License No. 80
RALPH MAYNE WELL DRILLING
Firm Name
9120 BROWN CHURCH RD. MT AIRY
Address
Signature Date 8/9/91

WELL INFORMATION
1 2
APPROX. PUMPING RATE (GAL. PER MIN.) 5
8 12
AVERAGE DAILY QUANTITY NEEDED (GAL. PER DAY) 500
14 20

USE FOR WATER (CIRCLE APPROPRIATE BOX)
☒ HOME (SINGLE OR DOUBLE HOUSEHOLD UNIT ONLY)
☐ FARMING (LIVESTOCK WATERING & AGRICULTURAL IRRIGATION)
☐ INDUSTRIAL, COMMERCIAL, STATE AND FEDERAL GOV. OTHER (REQUIRES APPROPRIATION PERMIT)
☐ PUBLIC OR PRIVATE WATER COMPANY (REQUIRES APPROPRIATION PERMIT AND STATE HEALTH DEPARTMENT APPROVAL)
☐ TEST, OBSERVATION, MONITORING (MAY REQUIRE APPROPRIATION PERMIT)

APPROXIMATE DEPTH OF WELL 150 FEET
24 28

APPROXIMATE DIAMETER OF WELL 6" NEAREST INCH

METHOD OF DRILLING (circle one)
BORED (or Augered) JETTED Jetted & DRIVEN
30 AIR-ROTARY AIR-PERCussion ROTARY (Hydraulic Rotary)
37 CABLE REVERSE-ROTARY Drive-POINT
other

REPLACEMENT OR DEEPEMED WELLS
(CIRCLE APPROPRIATE BOX)
☐ THIS WELL WILL NOT REPLACE AN EXISTING WELL
☐ THIS WELL WILL REPLACE A WELL THAT WILL BE ABANDONED AND SEALED
39 ☒ THIS WELL WILL REPLACE A WELL THAT WILL BE USED AS A STANDBY
☐ THIS WELL WILL DEEPEMED AN EXISTING WELL
PERMIT NUMBER OF WELL TO BE REPLACED OR DEEPEMED (IF AVAILABLE) 41 52

Not to be filled in by driller (OEP USE ONLY)
APPROX. PERMIT NUMBER 54 63
FORCE MA WRITE INITIALS IN BOX PERMIT No. 40-88-1994
67 68 70 71 72 73 74 75 76 77 78 79

SPECIAL CONDITIONS
H-854-3882
W-531-2288

LOCATION OF WELL
1 2
HOWARD
8 COUNTY 21
ORNDORFF PROP
23 SUBDIVISION 42
SECTION 44 46 LOT 48 50
DAYTON
52 NEAREST TOWN 71
MILES FROM TOWN (enter 0 if in town) 73 76 77 78

4
1 2
DIRECTION OF WELL FROM TOWN (CIRCLE BOX)
N W 8-9 N E 8-9
W 8 E 8
S W 8-9 S 8 S E 8-9
TOWN
NEAR WHAT ROAD
TEN OAKS RD.
11 30
ON WHICH SIDE OF ROAD (CIRCLE APPROPRIATE BOX)
NORTH N
WEST W 32 EAST E
SOUTH S
34 37
DISTANCE FROM ROAD
ENTER FT or MI 38 39

NOT TO BE FILLED IN BY DRILLER HEALTH DEPARTMENT APPROVAL
Howard RW 47400
COUNTY NAME COUNTY NO.
STATE SIGNATURE DATE ISSUED 08/29/91 Mark E. Tiffin 2/12/92
43 48 CO SIGNATURE EXP. DATE
NORTH GRID 511000 EAST GRID 0805000
50 55 57 63

SHOW MAJOR FEATURES OF BOX & LOCATE WELL WITH AN X
SOURCES OF DRILLING WATER
1. well
2.
3.
WRITE THE BOX NUMBER FROM THE MAP HERE
E 2085
N 5181
DRAW A SKETCH BELOW SHOWING LOCATION OF WELL IN RELATION TO NEARBY TOWNS AND ROADS AND GIVE DISTANCE FROM WELL TO NEAREST ROAD JUNCTION
N
Greenridge Rd.
TEN OAKS RD.
50' well
8/16/91 9:30
130 FT CASING
627 FT OPEN
37 BAGS
4 DRY HOLE DUG
LOCATION
CHANGE
SEE OTHER SIDE
RH
5 WELL
OK

COUNTY

SITE INSPECTION SHEET

OWNER: Peg Orndorff h-854-3882 w-531-2288

DATE REQUESTED: 8-8-91 10-12

PHONE #: Orndorff Sub Lot 4

CONTRACTOR: R Mayne

ADDRESS: 4901 Ten Oaks Road


WELL TAG #: HO-88-1946

Dayton, MD (across from Post Office)

COUNTY #: RW-47400

PROPOSAL: Replacement well to replace hand dug well about 40 feet.

LOCATION DIAGRAM

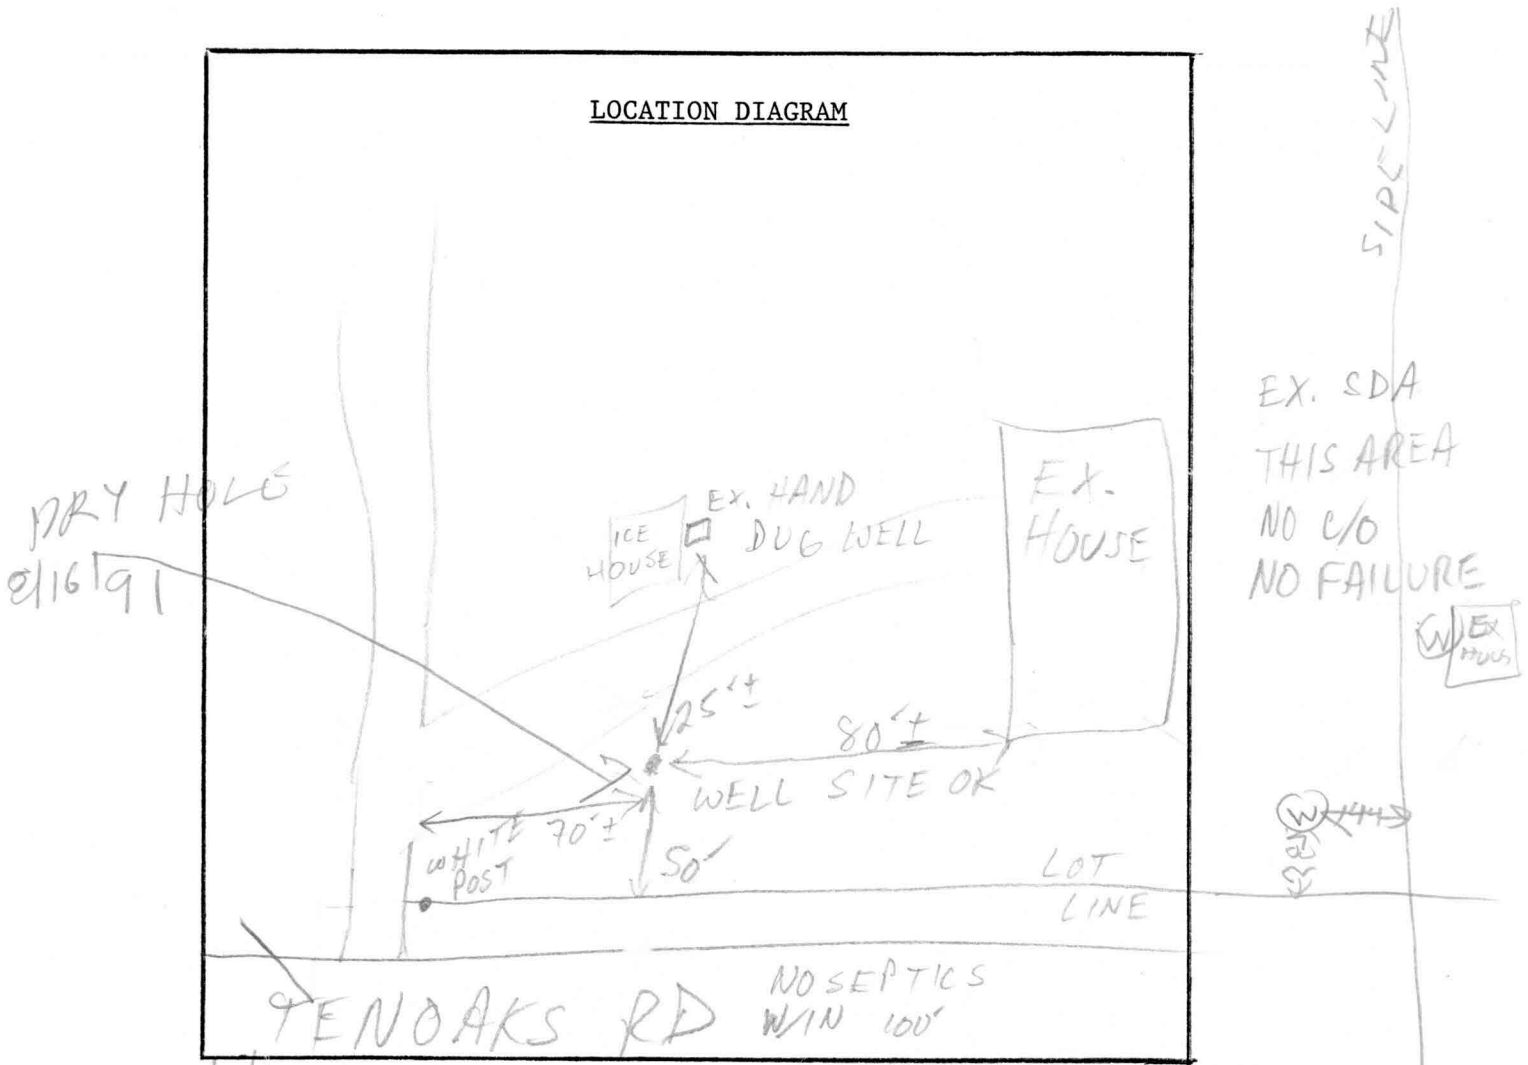

COMMENTS: 8/8/91 WELL SITE OK MR

DATE: 8/8/91

INSPECTOR: M. Rifkin

RECEIVED
HOWARD COUNTY
HEALTH DEPT.

91 AUG -9 PM 2:34

DRY HOLE

ACTUAL WELL
FR SAID OK
TO CHANGE
STE

JOB
HOUSE

EXIST
HOUSE


W EXIST
HOUSE

TEN OAKS RD

POST
OFFICE

EXIST
HOUSE

EXIST
HOUSE

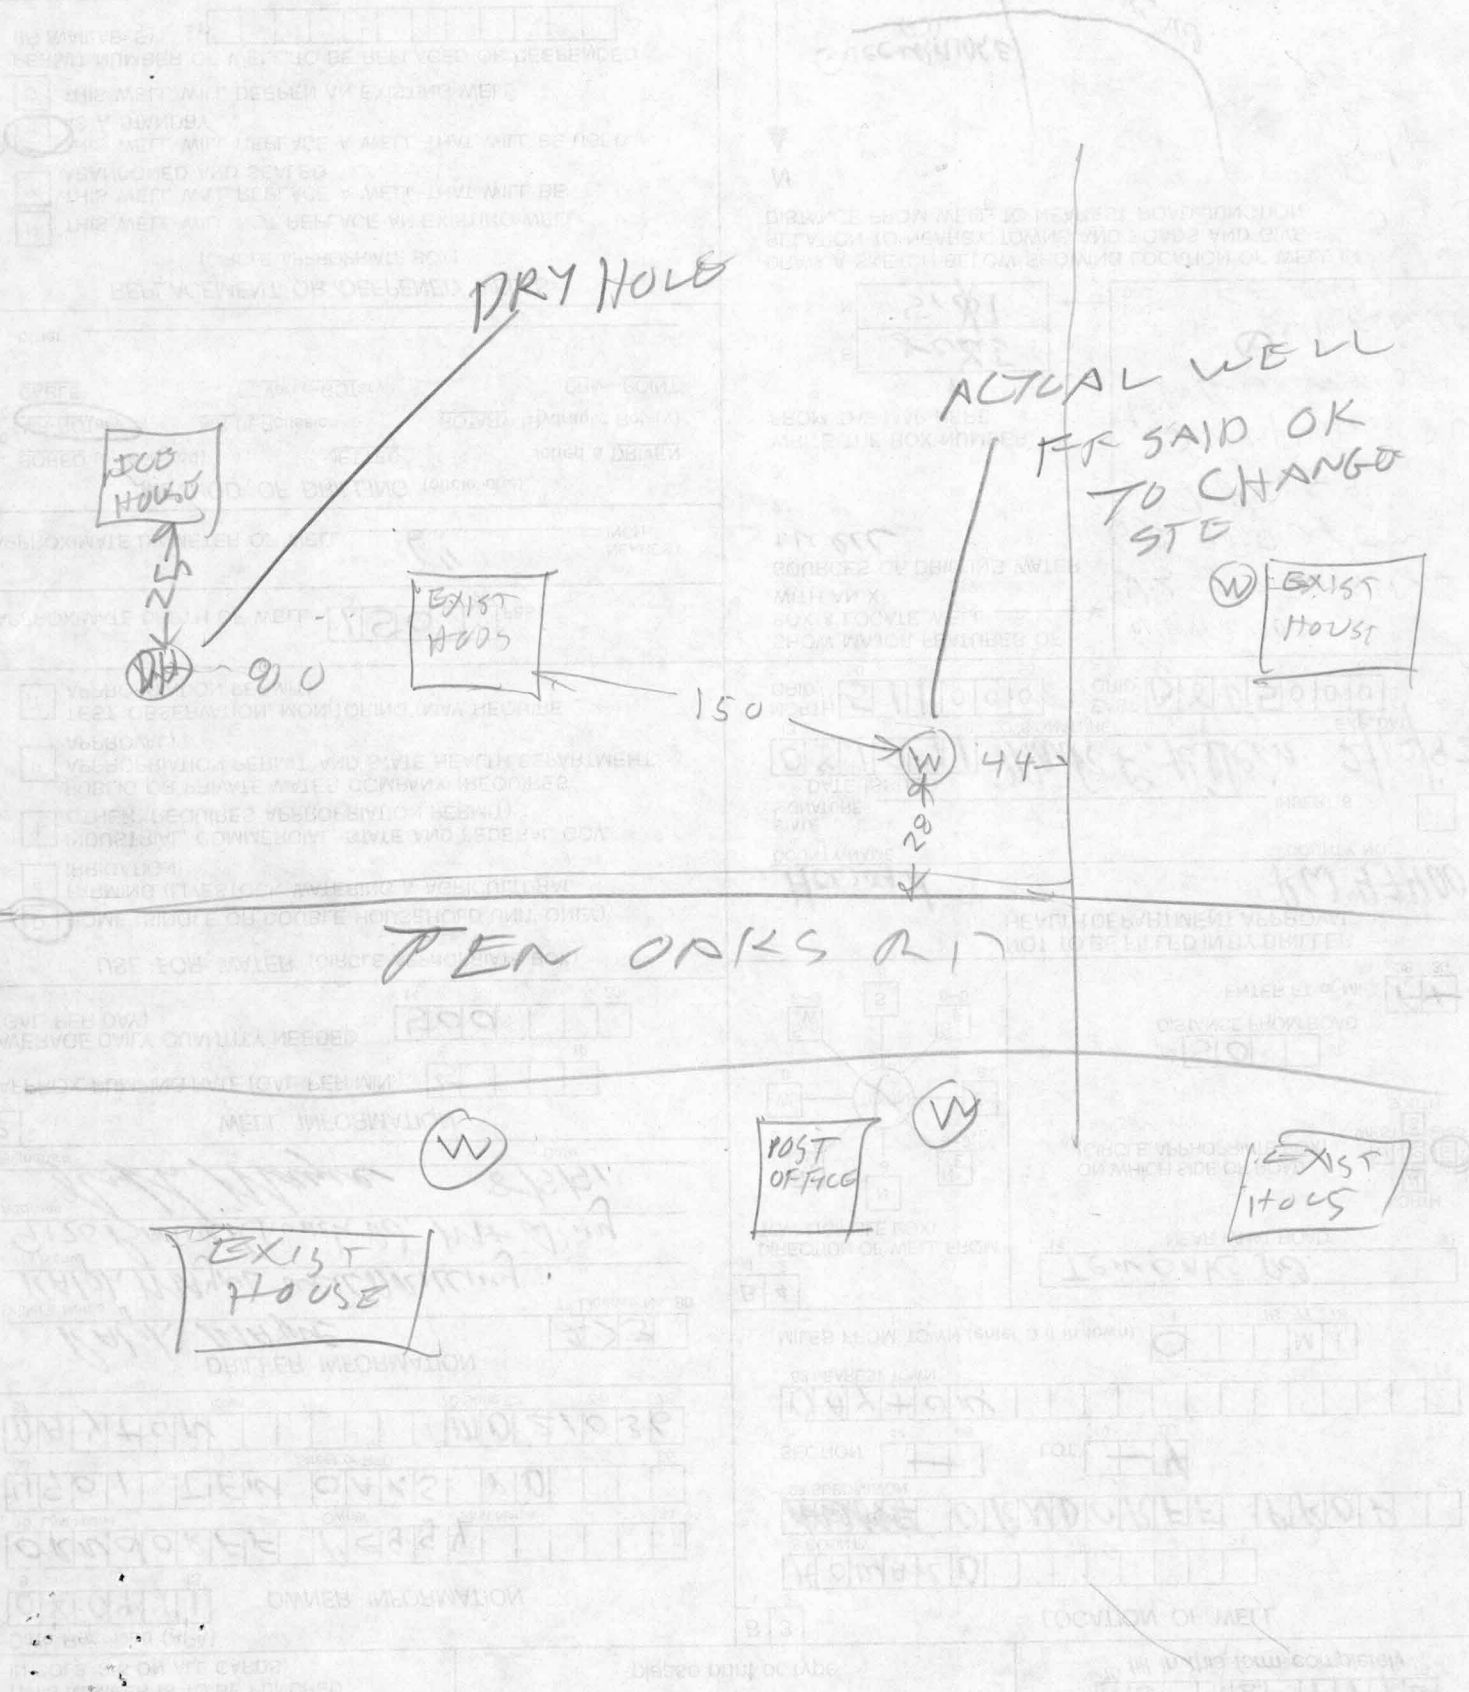


8-14-91,

Orndorff


CRAIG

Ralph Mayne

replacement well

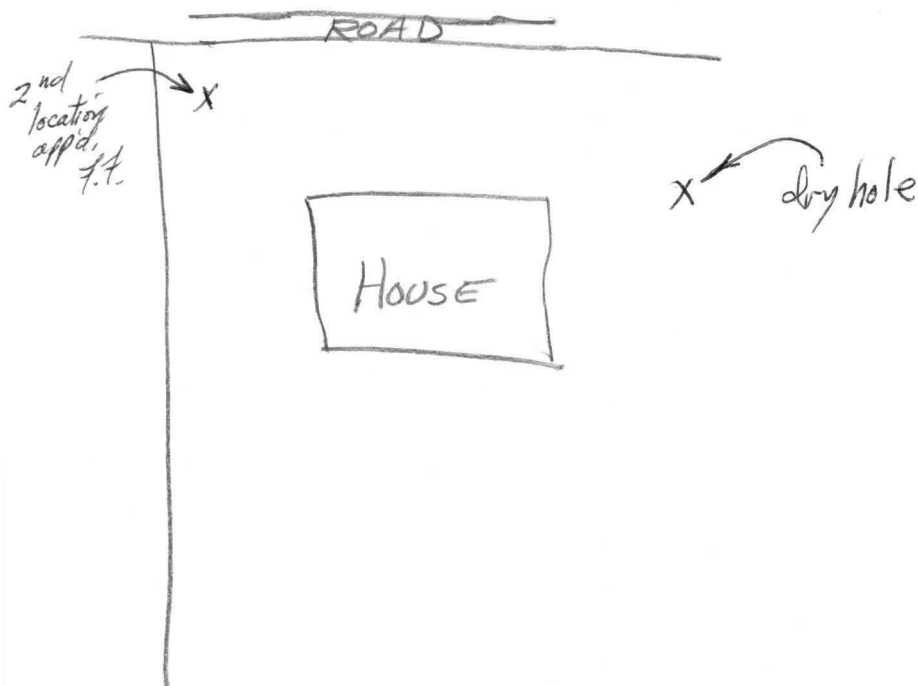

Ralph informed me that location
#2 upgrade & removed from S.S.'s
& house adequately F.F.

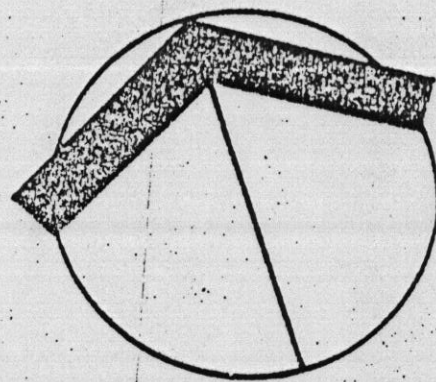

ROAD

60.00'

OAKS

TEN

15.00'

CHOC

These Buildings are
Razed

Existing
Handing Well

Proposed New
Drilled Well

Approx Area of
Existing Septic
System as
Field Located

795.43'

21' 10" N

515

570

505

535

550

Peggy A. Ornament

4901 Ten Oaks Road
Dayton Md. 21036

Home → 854-3882
Work → 531-2288

RECEIVED
HOWARD COUNTY
HEALTH DEPT.
91 AUG -9 PM 2:34

Actual Well

8/16/91

HP 881946