

LAYOUT 4/17/2010 INSP 4 _____
INSP 2 4/22/2010 AM INSP 5 _____
INSP 3 4/22/2010 PM INSP 6 _____

ISSUE DATE: _____

PERMIT

P 532597

APPROVAL DATE: _____

4/22/2010

A _____

Tax ID # 03293289

**ON-SITE SEWAGE DISPOSAL SYSTEM
TANK REPLACEMENT
HOWARD COUNTY HEALTH DEPARTMENT
BUREAU OF ENVIRONMENTAL HEALTH**

Heritage Realty IS PERMITTED TO INSTALL ☒ ALTER ☐

ADDRESS: 15950 North Avenue 482 Lisbon MD 21765 PHONE NUMBER: 443-604-4379

SUBDIVISION: _____ LOT NUMBER: _____

ADDRESS: 11730 Triadelphia Road PROPERTY OWNER: Rose Pickett

SEPTIC TANK CAPACITY (GALLONS): 1500 OUTLET BAFFLE FILTER REQUIRED ☐

PUMP CHAMBER CAPACITY (GALLONS): Traffic COMPARTMENTED TANK REQUIRED ☒

NUMBER OF BEDROOMS: _____ APPLICATION RATE: _____

SQUARE FOOTAGE OF HOUSE: _____

LINEAR FEET OF TRENCH REQUIRED: _____

NOTES:	Do not order the septic tank until after layout inspection and Sanitarian approval. Layout inspection required prior to tank installation. Original septic tank must be properly abandoned before new tank installation. A written variance request is required for tanks deeper than 3 feet. A traffic bearing lid is required for tanks deeper than 4 feet.
--------	--

PLANS APPROVED: _____ DATE: _____

NOTE: PERMIT VOID AFTER 2 YEARS

NOTE: CONTRACTOR RESPONSIBLE FOR SCHEDULING A PRE-CONSTRUCTION INSPECTION FOR ALL INSTALLATIONS

NOTE: WATERTIGHT SEPTIC TANKS REQUIRED


NOTE: ALL PARTS OF SEPTIC SYSTEM SHALL BE 100 FEET FROM ANY WATER WELL

NOTE: MANHOLE RISERS REQUIRED ON ALL SEPTIC TANKS AND PUMP CHAMBERS

**NEITHER THE HOWARD COUNTY COUNCIL OR THE HEALTH DEPARTMENT IS
RESPONSIBLE FOR THE SUCCESSFUL OPERATION OF ANY SYSTEM
PERMITTEE RESPONSIBLE FOR OBTAINING FINAL APPROVAL ON THIS PERMIT
CALL 410-313-1771 FOR INSPECTION OF SEPTIC SYSTEM**

NOT TO SCALE

Dry well Depth 4.5'-5.5'

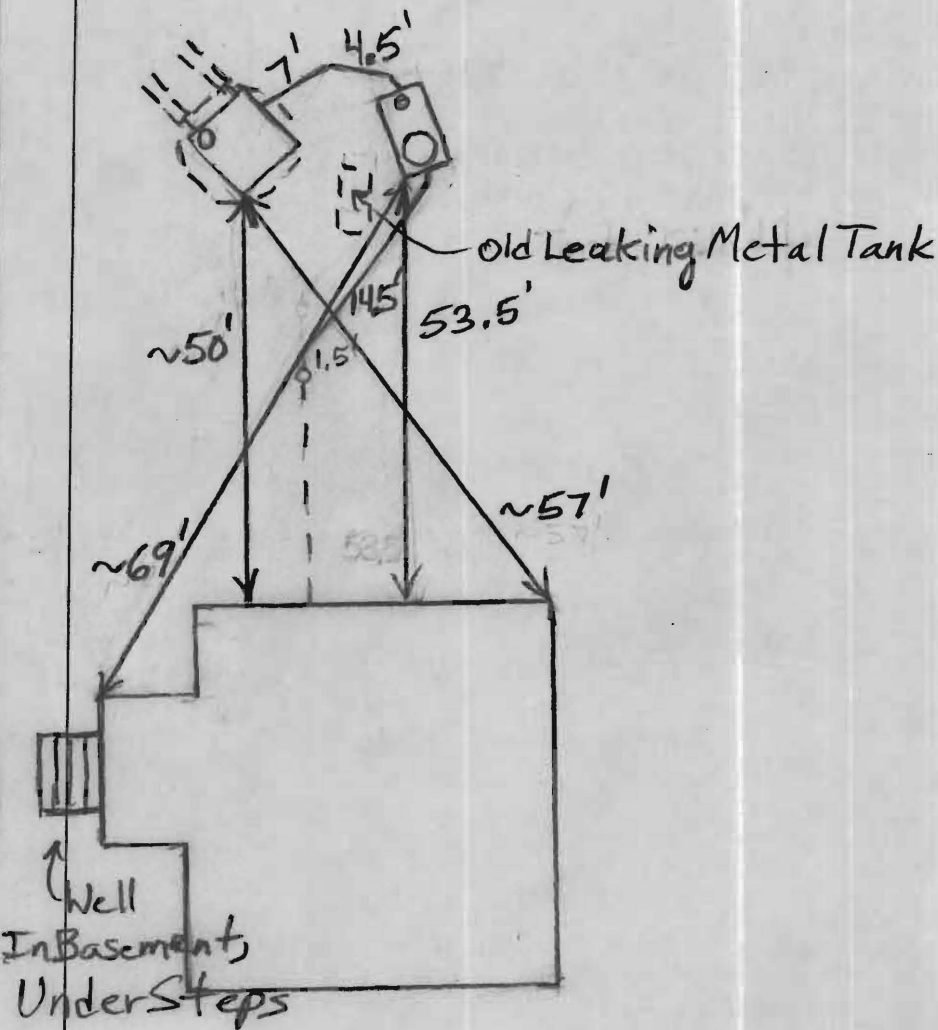

TRENCH/DRAINFIELD DATA

WIDTH _____ INLET _____ BOTTOM _____

NUMBER OF TRENCHES 2

TOTAL LENGTH _____

ABSORPTION AREA _____

DISTRIBUTION BOX LEVEL _____

DISTRIBUTION BOX BAFFLE _____

DISTRIBUTION BOX PORT _____

SEPTIC TANK DATA

SEPTIC TANK 1 LEVEL Yes

MANUFACTURER Babylon

CAPACITY 1500 GAL

SEAM LOC Top (Traffic)

TANK LID DEPTH 5-5.5'

BAFFLES Yes

BAFFLE FILTER No

MANHOLE LOC Front

6" PORT LOC Rear

WATERTIGHT TEST No

SLOTTED Yes

PUMP/SEPTIC TANK LEVEL N/A

MANUFACTURER _____

CAPACITY _____ GAL

SEAM LOC _____

TANK LID DEPTH _____

BAFFLES _____

BAFFLE FILTER _____

MANHOLE LOC _____

6" PORT LOC _____

WATERTIGHT TEST _____

SLOTTED _____

PRE-CONSTRUCTION

4/19/2010 Install
new traffic bearing
tank closer to
property line than
older tank.

Reconnect to drywell. Put 6" cleanout that extends to bottom of drywell with perforations in part of pipe that is in drywell. Fill drywell with stone. Check on condition of trench and drywell when exposed. (B) 4/22/2010 Drywell filled with gravel. New tank set and reconnected to drywell. Repair finished. (B)

FINAL INSPECTOR

B. Baker

DATE OF APPROVAL

4/22/2010

