

APPLICATION

A 26458

P _____

SEWAGE DISPOSAL TESTING

STATE OF MARYLAND - DEPARTMENT OF HEALTH AND MENTAL HYGIENE

HOWARD COUNTY HEALTH DEPARTMENT
ENVIRONMENTAL HEALTH SERVICESP.O. BOX 476, ELLICOTT CITY, MARYLAND 21043
TELEPHONE: 465-5000, EXT. 356DISTRICT 3rdDATE 7/20/77

8/5/77

9:30 A.M.

3 holes
15 ft. apart

1000 Gal Tank

1250 Gal Tank

Dry Well - 360 sqft sidewalk area 3 BR
490 sqft sidewalk area 4 BRDry Well inlet to be 4 FT deep below original grade
11 " 11 BOTTOM 11 14 11 11 11 11Place Dry Well 21 FT from the edge of
Triadelphia Rd and 70 ft from
the Front Left corner of HouseI HEREBY APPLY FOR THE NECESSARY TEST IN ORDER TO CONSTRUCT (OR RECONSTRUCT) A SEWAGE
DISPOSAL SYSTEMPROPERTY OWNER Mrs. G. E. Easton (Contract Purchaser - John Davis
house from Triadelphia Rd Box 368 Ohio Avenue
Hanover, Md. 21076ADDRESS 12100 Triadelphia Road, Ellicott City, Md. PHONE 286-3571

PROPERTY LOCATION:

SUBDIVISION _____ LOT NO. _____

ROAD AND DESCRIPTION 12100 Triadelphia Road - Existing house presently has three
bedrooms in it. Do not know what purchasers intend to do.SIZE OF LOT 1 1/4 acres TYPE BLDG. 3 or 4 bedrooms
NUMBER OF BEDROOMS

IF NOT SINGLE RESIDENCE DESCRIBE _____


THE SYSTEM INSTALLED UNDER THIS APPLICATION IS ACCEPTABLE ONLY UNTIL PUBLIC
FACILITIES BECOME AVAILABLE.SIGNATURE OF APPLICANT Mrs. G. E. Easton (Marie M. Medfield - agent)APPROVED BY Raymond Rodger FOR Dry Well DATE 8/22/77
(KIND OF SYSTEM)REJECTED BY _____ FOR _____ DATE _____
(KIND OF SYSTEM)

HOLD PENDING FURTHER TESTS _____ DATE _____

REASONS FOR REJECTION OR HOLDING 8/5/77 Per OK but LetterNeeded stating That the well on the Lewis & Belski
property is over 75 FT from Per Test holes on Easton Prop
8/24/77 Letter written stating that Neighbor well
not too close

THIS IS NOT A PERMIT

Beliski & Leaver Prop
ADJ. WELL
EXIST HOUSE

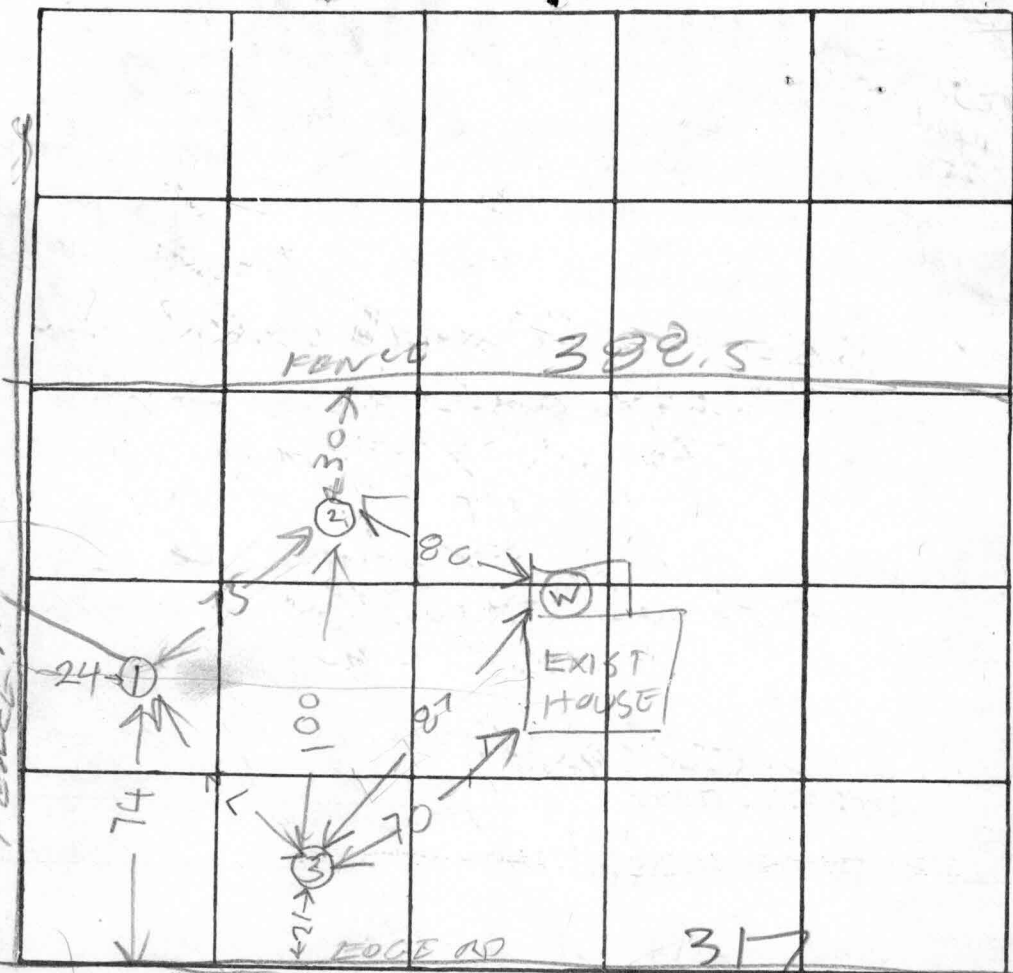

INDICATE NORTH - NAME ADJOINING ROADWAY AS BASE LINE

TRIDELPHIA RD FORT 144

HOLE ELEVATION

DATE	TEST NO.	DEPTH	PRE-WET		TEST - 1" DROP		TIME
			START	STOP	START	STOP	
8/5/77	1D	14	936	939	939	944	5
	1S	7	937	939	939	944	5
	2D	13 1/2	942	944	944	946	2
	2S	5	944	945	945	948	3
	3D	14	955	958	958	1003	5
8/5/77	3S	4	956	957	957	1000	3

NEXT HIGH

LOWEST

HIGH

REMARKS

Must Check Location of Water Well on Beliski & Leaver Prop

TYPE OF SOIL

TESTED BY

R. Hodges

MARIE WIEDE FOLD REAL ESTATE

ALSO PRESENT:

DAVIS BUYER
SANDRA R...

40
21
0

47