

PERMIT

SEWAGE DISPOSAL SYSTEM

MARYLAND STATE DEPARTMENT OF HEALTH

HOWARD COUNTY

ELLICOTT CITY

DISTRICT 3rd

DATE 9/13/77

INDEXED

Statewide Plumbing and Heating

IS PERMITTED TO INSTALL ☒ ALTER

ADDRESS 2843 Louisiana Avenue, Baltimore, Md. 21227 PHONE 636-1700

A SEWAGE DISPOSAL SYSTEM LOCATED AT _____

SUBDIVISION _____ ROAD 12100 Triadelphia Road LOT _____

PROPERTY OWNER Donald A. Davis

ADDRESS Box 368 Ohio Avenue, Hanover, Md. 21076

SPECIFICATIONS 3 bedrooms

DRAIN FIELD _____ DEPTH _____ FEET, BOTTOM AREA _____ SQ. FT.

SEEPAGE PITS _____ ABSORBENT SIDE-WALL AREA _____ SQ. FT.

SEPTIC TANK CAPACITY 1000 GALLONS

FOR GARBAGE GRINDER, INCREASE DISPOSAL AREA 22% & TANK CAPACITY 50%.

OTHER DRY WELL - 360 sq. ft. sidewall area. Dry well inlet to be 4 ft. below original grade and dry well bottom to be 14 ft. deep below original grade. Place dry well 21 ft. from the edge of Triadelphia Road and 70 ft. from the front left corner of house as seen when facing the house from Triadelphia Road.

NOTE: ALL PIPE FROM HOUSE TO DISPOSAL AREA MUST BE CAST IRON.
PERMIT VOID AFTER THREE YEARS.

NOTE: INSTALL STAND PIPE ON SEPTIC TANK AND DRY WELL. STAND PIPES MUST BE 6 INCHES IN DIAMETER. CAST IRON, CONCRETE OR TERRA COTTA ACCEPTED.

PLANS APPROVED BY Raymond Hodges


DATE 8/22/77

FILL SEPTIC TANK AND DISTRIBUTION BOX WITH WATER BEFORE CALLING FOR AN INSPECTION. COVER NO WORK UNTIL INSPECTED AND APPROVED.

NEITHER THE HOWARD COUNTY COMMISSIONERS NOR THE HEALTH DEPARTMENT IS RESPONSIBLE FOR THE SUCCESSFUL OPERATION OF ANY SYSTEM.

44157

A 26458

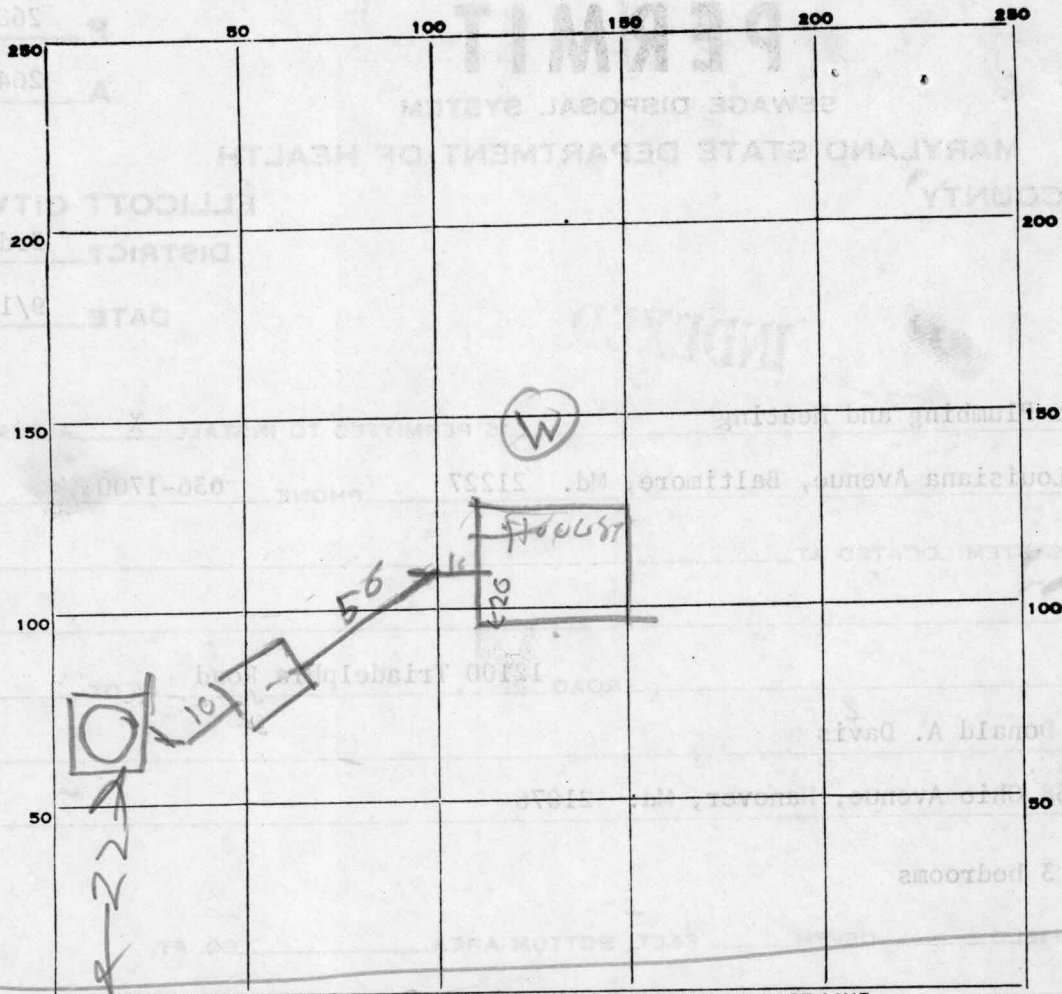

INDICATE NORTH. NAME ADJOINING ROADWAY AS BASE LINE.

TRIDEL PHIA RS

PERMIT CARD _____

SEPTIC TANK, LEVEL OK 1200

CLEANOUTS

DISTRIBUTION BOX, LEVEL _____

TILE FIELD, DEPTH _____ FT. TRENCH WIDTH _____ FT.

GRAVEL DEPTH _____ IN. TOTAL LENGTH _____ FT.

NUMBER OF TRENCHES _____

TOTAL BOTTOM AREA _____

SEEPAGE PITS, INSIDE DIAMETER _____ FT.

DEPTH BELOW INLET _____ FT.

ABSORBENT AREA

550 SQ. FT.

REMARKS

9/19/77 DW inlet 3 FT below grade

DATE SYSTEM APPROVED

INSPECTOR

9/19/77

Raymond Hodges