

9/10/01 CD 9/11/01 12-1PM
11:00 1/29/02 Septic pump 11AM
ISSUE DATE: 7/31/2001

APPROVAL DATE: 1/29/02

PERMIT

INDEXED

ON-SITE SEWAGE DISPOSAL SYSTEM HOWARD COUNTY HEALTH DEPARTMENT BUREAU OF ENVIRONMENTAL HEALTH

03-318192

P 515964-B

A 59879

Fogles Septic Clean, Inc

IS PERMITTED TO INSTALL ☒ ALTER ☐

ADDRESS: 580 Obrecht Road, Sykesville

PHONE NUMBER: 410-795-5670

SUBDIVISION: Woodmark, Section 13

LOT NUMBER: 9

ADDRESS: 12465 Triadelphia Road

PROPERTY OWNER: Benchmark Homes, Inc

SEPTIC TANK CAPACITY (GALLONS): 1250

PUMP CHAMBER CAPACITY (GALLONS): N/A

NUMBER OF BEDROOMS: 4

SQUARE FEET PER BEDROOM: 180

LINEAR FEET OF TRENCH REQUIRED: 120 LF
To be determined

min 120' trench
12' CTC

TRENCHES:	Trench to be 2.0 feet wide. Inlet 2.0 feet below original grade. Bottom maximum depth 8.0 feet below original grade. Effective area begins at 2.0 feet below original grade. 6.0 feet of stone below distribution pipe.
LOCATION:	
PURPOSE:	Trench length and location to be determined during layout. A minimum of 120 feet of trench is required.

PLANS APPROVED: Brian Baker

DATE: 4/25/01

NOTE: PERMIT VOID AFTER 2 YEARS

NOTE: CONTRACTOR RESPONSIBLE FOR SCHEDULING A PRE-CONSTRUCTION INSPECTION FOR ALL INSTALLATIONS

NOTE: WATERTIGHT SEPTIC TANKS REQUIRED


NOTE: ALL PARTS OF SEPTIC SYSTEM SHALL BE 100 FEET FROM ANY WATER WELL

NOTE: MANHOLE RISERS REQUIRED ON ALL SEPTIC TANKS AND PUMP CHAMBERS

NEITHER THE HOWARD COUNTY COUNCIL NOR THE HEALTH DEPARTMENT IS
RESPONSIBLE FOR THE SUCCESSFUL OPERATION OF ANY SYSTEM
PERMITTEE RESPONSIBLE FOR OBTAINING FINAL APPROVAL ON THIS PERMIT
CALL 410-313-2640 FOR INSPECTION OF SEPTIC SYSTEM

P 515964-B

NOT TO SCALE

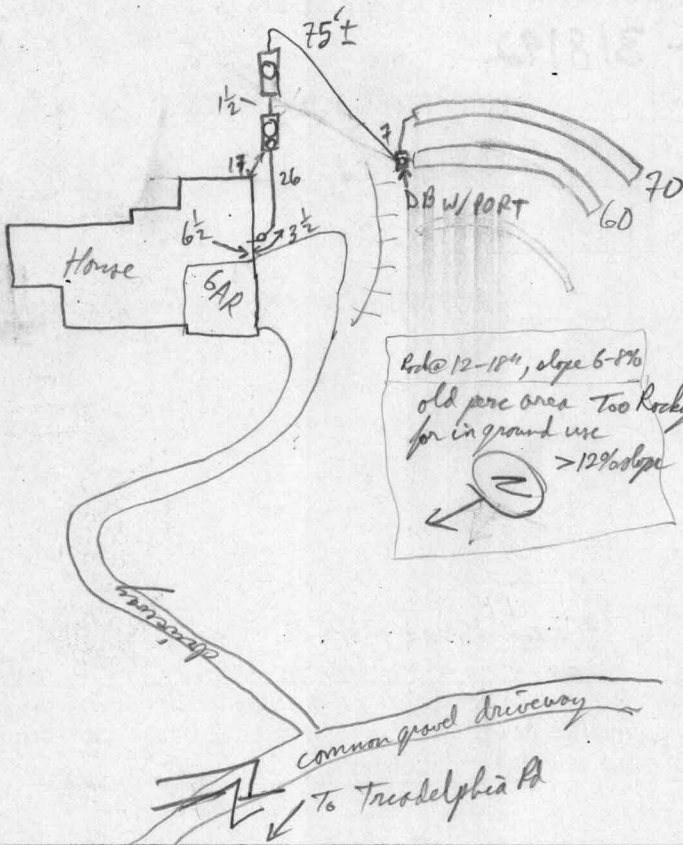

TRENCH DATA

TRENCH WIDTH 2'
 TRENCH INLET DEPTH 2'
 TRENCH BOTTOM DEPTH 8'
 DEPTH OF STONE 6'
 NUMBER OF TRENCHES 2 (x 60 LFS)
 TOTAL TRENCH LENGTH 130'
 ABSORBENT AREA 780 ft²
 DISTRIBUTION BOX LEVEL ☒
 BAFFLE IN DISTRIBUTION BOX ☒

SEPTIC TANK DATA

SEPTIC TANK 1250 TS GALLONS
 MANHOLE RISER ☒
 6 INCH INSPECTION PORT ☒

PUMP CHAMBER DATA

PUMP CHAMBER GALLONS 1250 TS
 MANHOLE RISER ☒
 ALARM ☒
 PUMP PERFORMANCE TEST ☒

PRE-CONSTRUCTION INSPECTION: _____

INSPECTION COMMENTS: First trench open + 2/3 gravel filled - OK to cover when finished.
call for final inspection tomorrow. R/P 9/10/01
9/12/01 OK TO COVER ALL WORK; HOLD FOR PUMP INSP (MR)
1/29/02 Pump and alarm working. (BB)

INSPECTOR B. Baker DATE SYSTEM APPROVED 1/29/02