

APPLICATION

SEWAGE DISPOSAL TESTING

A 15769

P

MARYLAND STATE DEPARTMENT OF HEALTH

HOWARD COUNTY *Septic tank for 3 persons 1000 gals*

ELLICOTT CITY

DISTRICT 3

DATE 3/12/71

Dry well to be 300 sq ft at top of sidewalk area follow the inlet pipe. Inlet pipe to be 3 1/2 ft below original grade. Maximum depth of dry well to be 12 ft deep. follow original grade. locate system 39 ft from right side line and 42 ft from rear lot line as lot is seen standing on Triadelphia Rd facing lot.

TO: THE COUNTY HEALTH OFFICER
ELLICOTT CITY, MARYLAND

I, HEREBY, APPLY FOR THE NECESSARY TESTS IN ORDER TO CONSTRUCT (OR RECONSTRUCT) A SEWAGE DISPOSAL SYSTEM.

PROPERTY OWNER George P. Garratt, Jr.

ADDRESS Forsyth Road, Sykesville, Maryland

PHONE 442-2262

PROPERTY LOCATION:

SUBDIVISION

LOT NO.

ROAD AND DESCRIPTION Triadelphia Road

OCCUPANT

PHONE

PERSON TO CONSTRUCT SYSTEM

ADDRESS

PHONE

SIZE OF LOT 1.260 acres

TYPE BLOC

3

NUMBER OF BEDROOMS

IF NOT SINGLE RESIDENCE DESCRIBE

(Single Family Dwllg.)

SIGNATURE OF APPLICANT

Paul T. Shriver

301-431-0088

APPROVED BY

James T. Wright

FOR

Dry well

DATE

3/16/71

REJECTED BY

FOR


DATE

HOLD PENDING FURTHER TESTS

DATE

REASONS FOR REJECTION OR HOLDING

THIS IS NOT A PERMIT

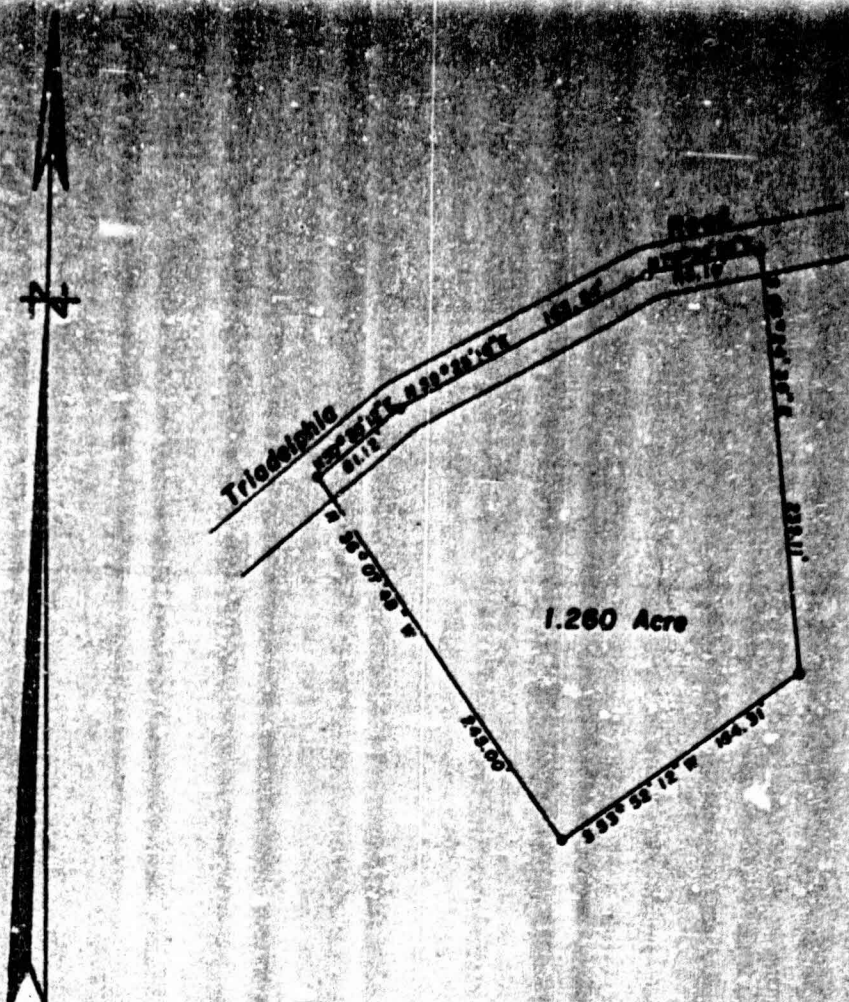


PLAT OF SURVEY
FOR
GEORGE P. GARRATT JR
THIRD ELECTION DISTRICT OF HOWARD COUNTY
ELLCOTT CITY, MARYLAND
SCALE: 1 IN. = 100 FT.
FEBRUARY 17, 1971

Claude M. Skinner Jr.
Claude M. Skinner Jr. Reg. Engineer & Land Surveyor No. 2237



A15769

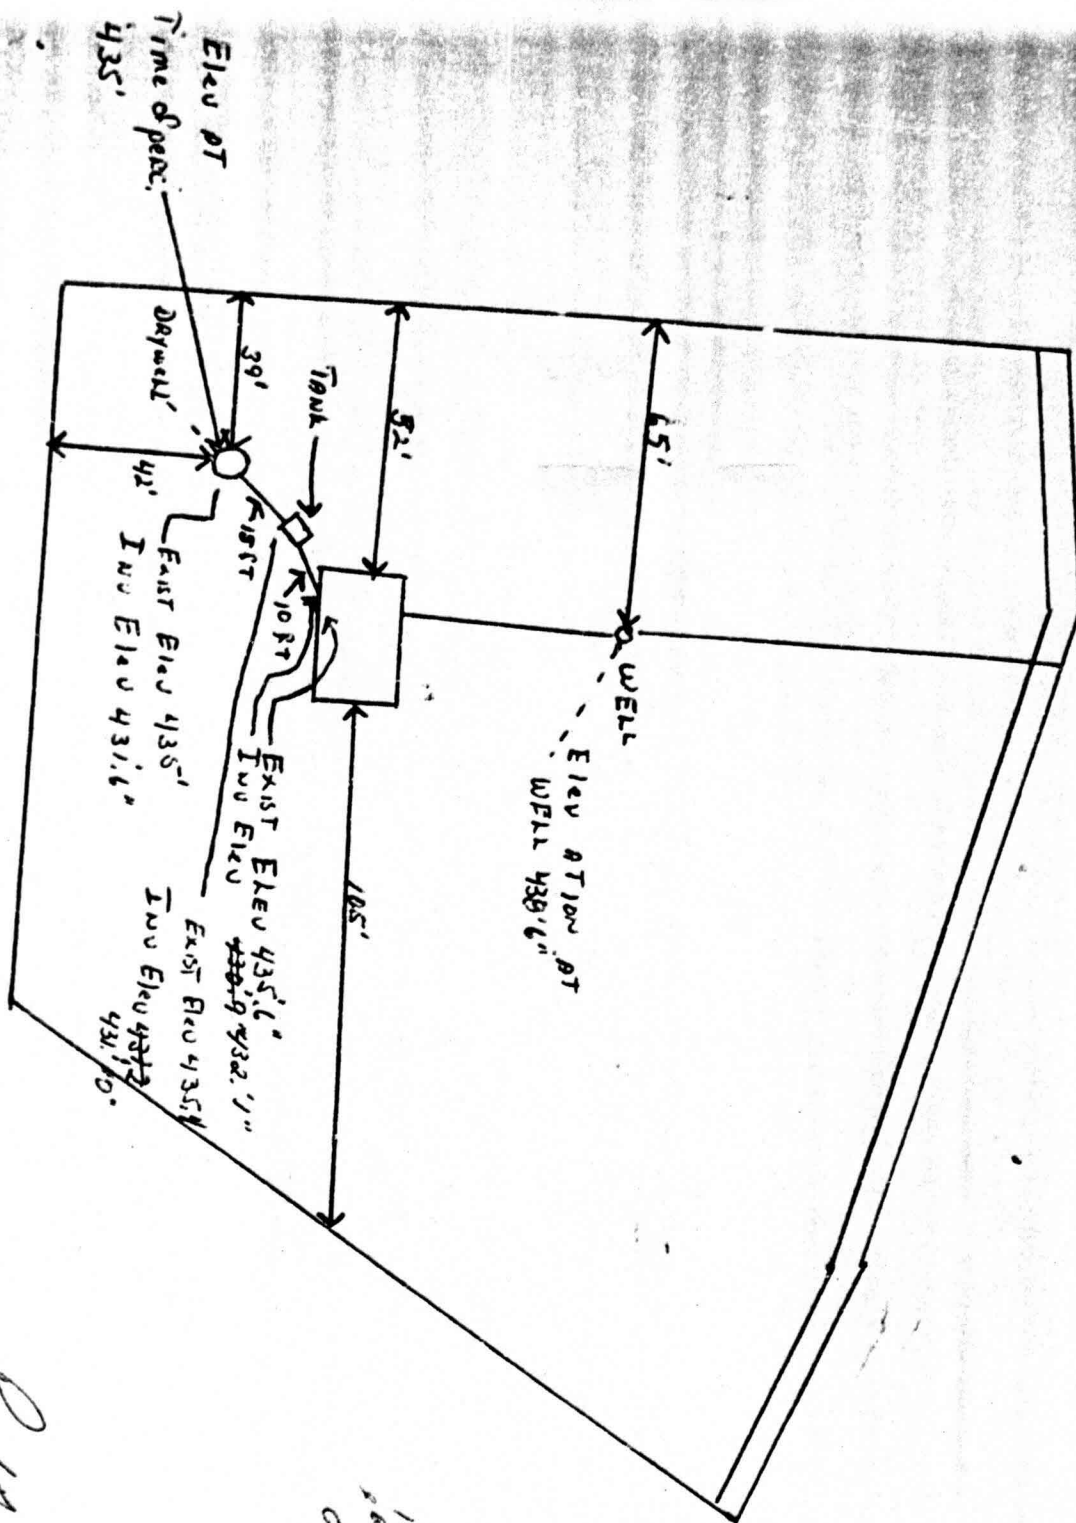

11-29-78
OK

Paul J. Johnson