

10/16/73

PERMIT

SEWAGE DISPOSAL SYSTEM

MARYLAND STATE DEPARTMENT OF HEALTH

HOWARD COUNTY

INDEXED

File

P. 18846

A 15769

ELLICOTT CITY

DISTRICT 3

DATE 8/6/73

Paul T. Shrieves

IS PERMITTED TO INSTALL ☒ ALTER

ADDRESS 501 Southampton Driver, Silver Springs, Md. PHONE 431-0086

A SEWAGE DISPOSAL SYSTEM LOCATED AT

SUBDIVISION

12625 ROAD Triadelphia Rd. - LOT

PROPERTY OWNER ~~same as above~~ Markush 300 ft. past Lakeway Drive

ADDRESS

SPECIFICATIONS - 3 bedrooms

DRAIN FIELD DEPTH FEET, BOTTOM AREA SQ. FT.

SEEPAGE PITS ABSORBENT SIDE-WALL AREA SQ. FT.

SEPTIC TANK CAPACITY 1,000 GALLONS

FOR GARBAGE GRINDER, INCREASE DISPOSAL AREA 22% & TANK CAPACITY 50%.

OTHER Dry well to be 300 sq. ft. of absorbent sidewall area below the inlet pipe.

Inlet pipe to begin 3/4 ft. below original grade. Maximum depth of dry well to be 12 ft.

deep, below original grade. Locate system 39 ft. from right side line and 42 ft. from rear

lot line as lot is seen standing on Triadelphia Rd., facing lot.

NOTE: ALL PIPE FROM HOUSE TO DRY WELL MUST BE CAST IRON.

PERMIT VOID AFTER THREE YEARS.


NOTE: INSTALL STAND PIPE ON SEPTIC TANK AND DRY WELL.

PLANS APPROVED BY James T. Wright DATE 3/16/71

FILL SEPTIC TANK AND DISTRIBUTION BOX WITH WATER BEFORE CALLING FOR AN INSPECTION. COVER NO WORK UNTIL INSPECTED AND APPROVED.

NEITHER THE HOWARD COUNTY COMMISSIONERS NOR THE HEALTH DEPARTMENT IS RESPONSIBLE FOR THE SUCCESSFUL OPERATION OF ANY SYSTEM.

A 15769

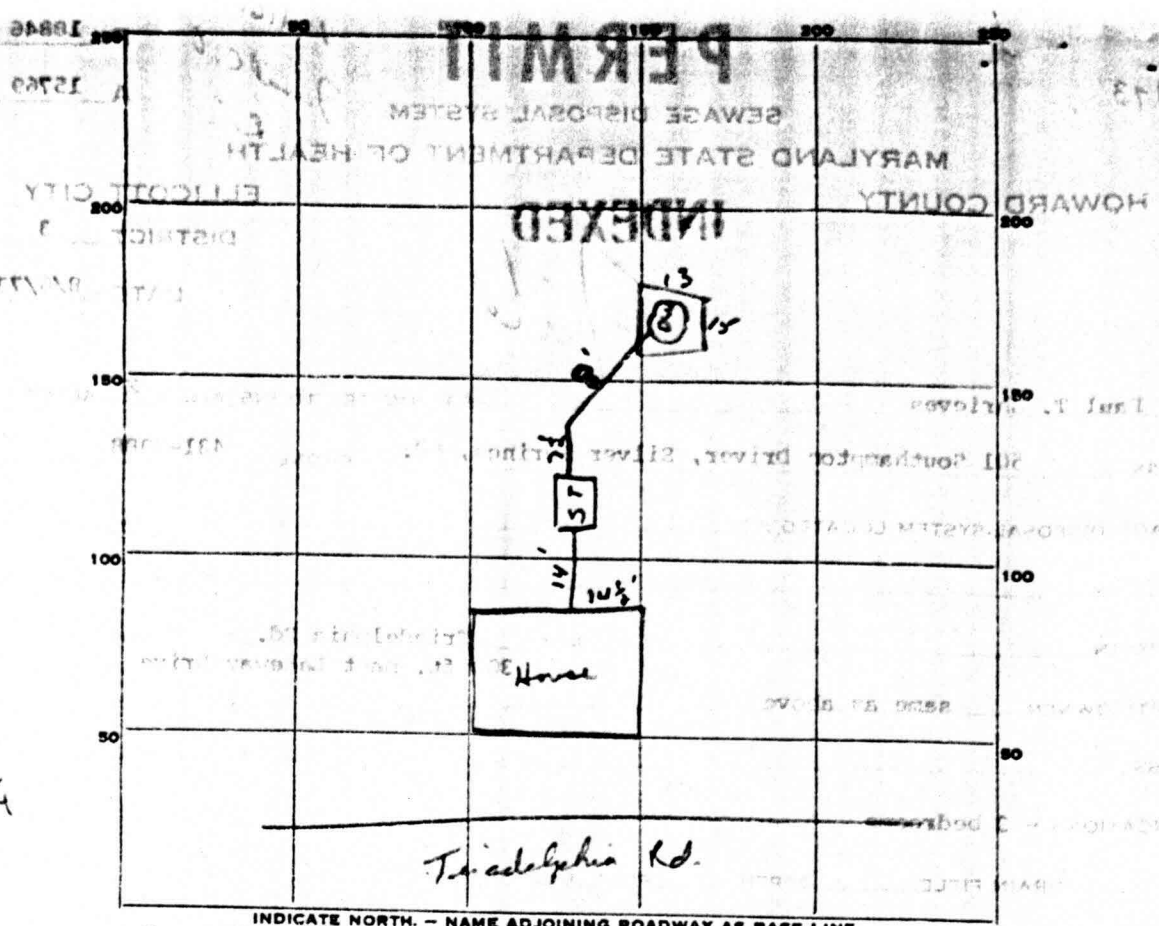

PERMIT CARD

Signed

SEPTIC TANK, LEVEL

1000 gal.

CLEANOUTS

OK

DISTRIBUTION BOX, LEVEL

TILE FIELD, DEPTH

FT.

TRENCH WIDTH

FT.

GRAVEL DEPTH

IN.

TOTAL LENGTH

FT.

NUMBER OF TRENCHES

TOTAL BOTTOM AREA

SEEPAGE PITS, INSIDE DIAMETER

13 x 15

FT.

DEPTH BELOW INLET

FT.

ABSORBENT AREA

504

SQ. FT.

REMARKS

DATE SYSTEM APPROVED

16/16/73

INSPECTOR

R. Tom