

APPLICATION

SEWAGE DISPOSAL TESTING

A 06576
P _____

MARYLAND STATE DEPARTMENT OF HEALTH

HOWARD COUNTY

ELLICOTT CITY

DISTRICT 3rd

DATE 4-11-63

325 sq. ft. of tile field located in area 125 ft. from the front property line and 30 ft. off the left side. Property line as determined when facing the lot from Triadelphia Road. Maintain one inch fall for every 30 ft. of tile.

750 gal. septic tank.

TO: THE COUNTY HEALTH OFFICER
ELLICOTT CITY, MARYLAND

I, HEREBY, APPLY FOR THE NECESSARY TESTS IN ORDER TO CONSTRUCT (OR RECONSTRUCT) A SEWAGE DISPOSAL SYSTEM.

PROPERTY OWNER Remus Burgess

ADDRESS 401- Triadelphia Rd. PHONE _____

PROPERTY LOCATION:

SUBDIVISION _____ LOT NO. _____

ROAD AND DESCRIPTION Triadelphia Road 3600 ft. north of Folly quarters Road on Northwest side of Triadelphia Road

OCCUPANT _____ PHONE _____

PERSON TO CONSTRUCT SYSTEM _____

ADDRESS _____ PHONE _____

SIZE OF LOT 180 by 235 TYPE BLDG. 3

NUMBER OF BEDROOMS

IF NOT SINGLE RESIDENCE DESCRIBE _____

SIGNATURE OF APPLICANT *James L. Hurd*

APPROVED BY *Henry W. [Signature]* FOR Tile field DATE 5-24-63

(KIND OF SYSTEM)


REJECTED BY _____ FOR _____ DATE _____

(KIND OF SYSTEM)

HOLD PENDING FURTHER TESTS _____ DATE _____

REASONS FOR REJECTION OR HOLDING _____

THIS IS NOT A PERMIT

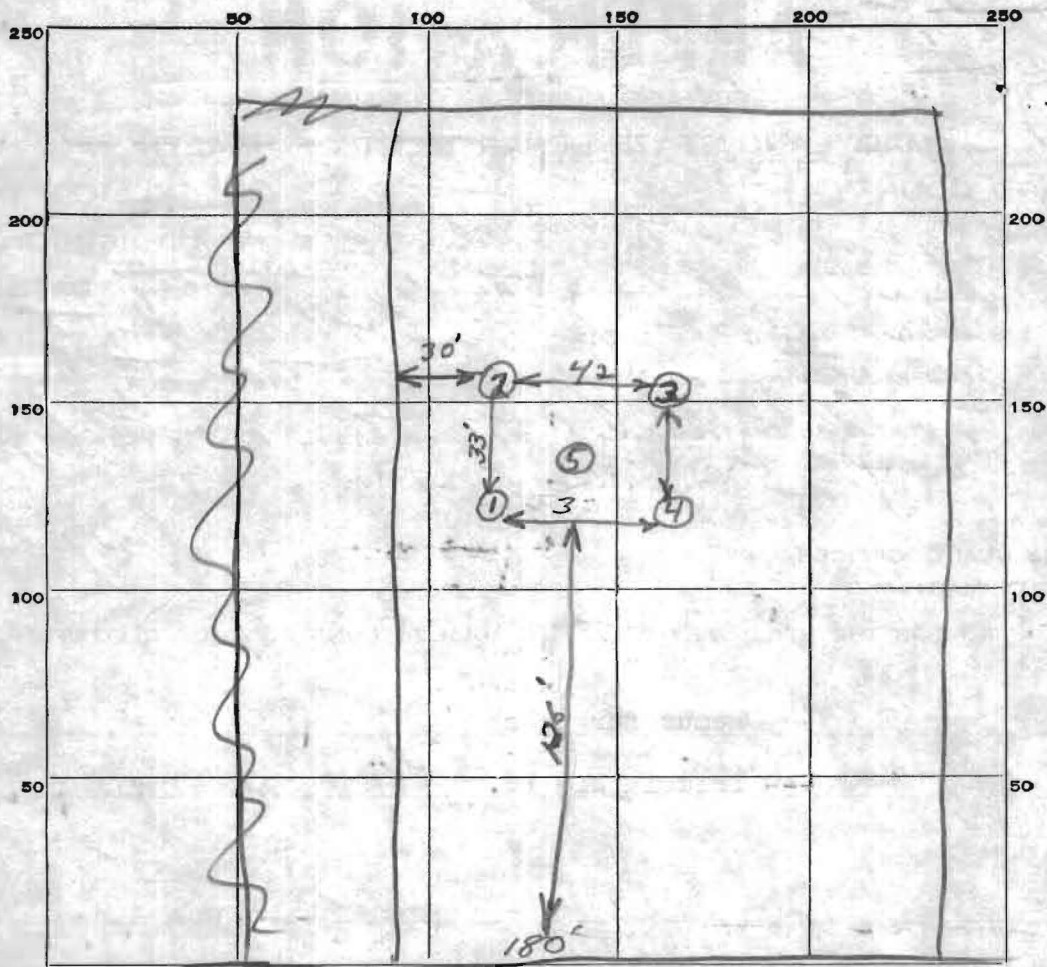

INDICATE NORTH. - NAME ADJOINING ROADWAY AS BASE LINE.

Tridelphia Road

DATE	TEST NO.	DEPTH	PRE-WET		TEST - 1" DROP		TIME
			START	STOP	START	STOP	
5-29-63	1	3 FT	9:59	10:04	10:04	10:13	9 min
	2		10:01	10:04	10:04	10:12	8 min
	3		10:04	10:06	10:04	10:12	8 min
	4		10:06	10:10	10:10	10:18	8 min
	5	8	good soil all way down				

SOIL AUGER FINDING

TESTED BY

REMARKS

ALSO PRESENT

LOT NO.

325 sq. Ft. of file

5-29-63

Bill Warren