

10/15/63

PERMIT

SEWAGE DISPOSAL SYSTEM

P 07280
47924
A 06576

MARYLAND STATE DEPARTMENT OF HEALTH

HOWARD COUNTY

ELLICOTT CITY

DISTRICT 3

DATE 8-12-63

INDEXED

INDEXED

John A. Williams. IS PERMITTED TO INSTALL ☒ ALTER ☐
ADDRESS 3800 W. Bay Ave Balt 25 PHONE EL 5-4187

A SEWAGE DISPOSAL SYSTEM LOCATED AT Tridelphia Rd - 360 ft north of
Tolly Quarter Rd on right

SUBDIVISION ROAD 13160 Tridelphia Rd. LOT

PROPERTY OWNER Remus Burgess

ADDRESS

SPECIFICATIONS

DRAIN FIELD ☒ DEPTH FEET, BOTTOM AREA 325 SQ. FT.

SEEPAGE PITS ABSORBENT SIDE-WALL AREA SQ. FT.

SEPTIC TANK CAPACITY 750 GALLONS

FOR GARBAGE GRINDER, INCREASE DISPOSAL AREA 22% & TANK CAPACITY 50%.

OTHER Maintain 1 inch fall for every 30 ft of tile

Locate tile field 125 ft from front property line and 30 ft
off left sideline as determined when facing lot from Tridelphia Rd.


PLANS APPROVED BY J. E. Hennigan DATE 5-29-63

FILL SEPTIC TANK AND DISTRIBUTION BOX WITH WATER BEFORE CALLING FOR AN INSPECTION. COVER NO WORK UNTIL INSPECTED AND APPROVED.

NEITHER THE HOWARD COUNTY COMMISSIONERS NOR THE HEALTH DEPARTMENT IS RESPONSIBLE FOR THE SUCCESSFUL OPERATION OF ANY SYSTEM.

BUDG. PERMIT SIGNED
AND RETURNED 10/10/69
Serial #30256
Cnelose Patis

A-06576
47924

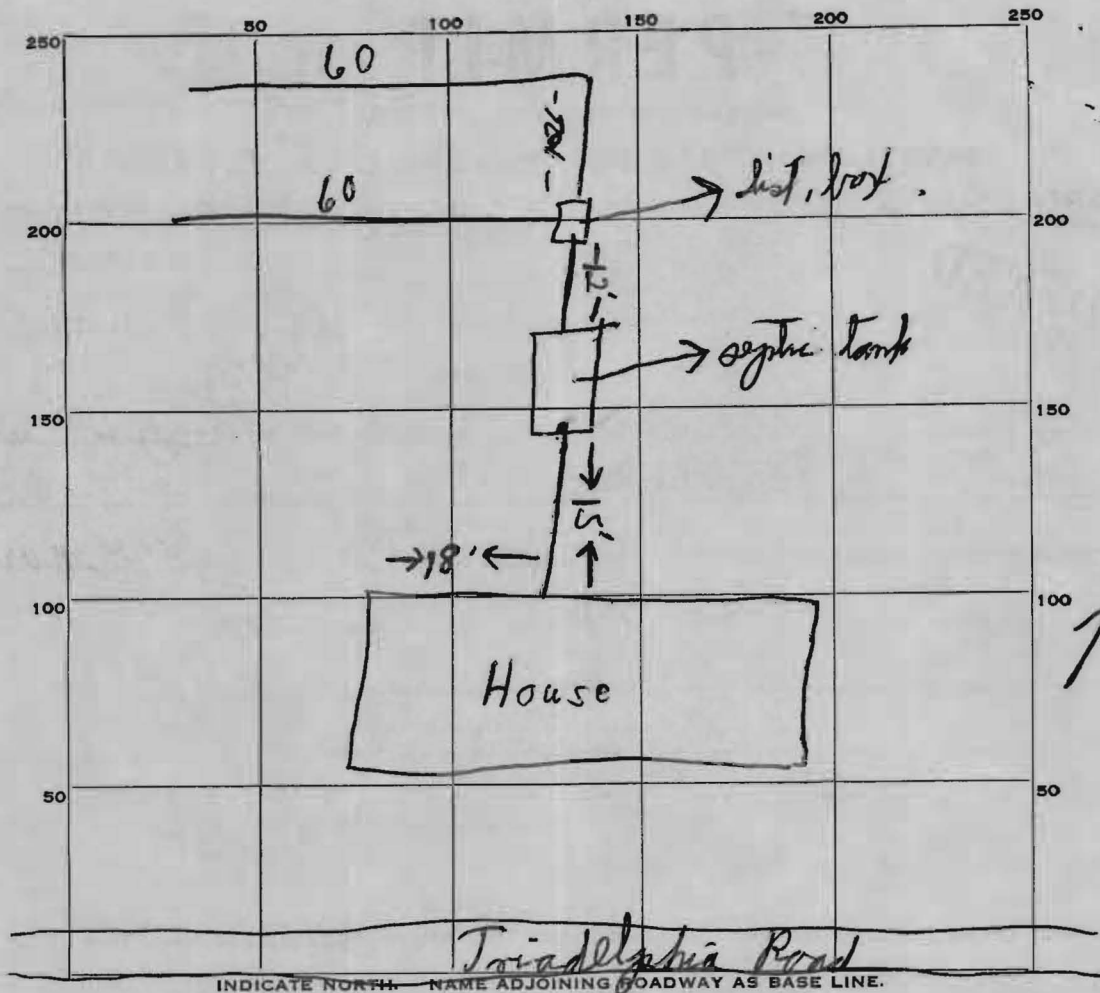

PERMIT CARD ☒

SEPTIC TANK, LEVEL ☒

CLEANOUTS yes

DISTRIBUTION BOX, LEVEL ☒

TILE FIELD, DEPTH 4' FT. TRENCH WIDTH 3' FT.

GRAVEL DEPTH 12" IN. TOTAL LENGTH 120' FT.

NUMBER OF TRENCHES 2 TOTAL BOTTOM AREA 3601

SEEPAGE PITS, INSIDE DIAMETER _____ FT. DEPTH BELOW INLET _____ FT.

ABSORBENT AREA _____ SQ. FT.

REMARKS _____

DATE SYSTEM APPROVED

10/15/63

INSPECTOR

P.W.