

HOWARD COUNTY PERMIT APPLICATION

PERMIT NUMBER

B10007810

Building Address 14581 T. Trudolph Rd
Calverley Md 21737

Suite/Apt. #: _____ SDP/WP/Petition #: _____

Census Tract _____ Subdivision Wards II

Section _____ Area _____ Lot 13

Tax Map 07 Parcel 114 Grid 5

Zoning _____ Map Coordinates _____ Lot size _____

Existing Use SF3

Proposed Use SF3

Estimated Construction Cost \$ 8000

Description of Work Install a 300 gal propane

1 tank

Occupant or Tenant _____

Contact Name _____

Address _____

City _____ State _____ Zip Code _____

Phone _____ Fax _____

Property Owner's Name NVR Inc.

Address 6085 Marshake Dr

City Elkridge State md Zip Code 21075

Home Phone _____ Work Phone _____

Applicant's Name & Mailing Address, (if other than stated hereon):

Jerome Clancy 7081 Marshake Way

Phone 410-340-1227 Fax Elkridge Md 21075

Contractor Company Valley National gas

Contact Person William Greening

Address 7201 Mont

City Jessup State md Zip Code 20794

License No. 67793

Phone 410-709-1114 Fax _____

Engineer or Architect Company _____

Contact Person _____

Address _____

City _____ State _____ Zip Code _____

Phone _____ Fax _____

BUILDING DESCRIPTION - COMMERCIAL

Building Characteristics

Height: _____

No. of stories: _____

Gross area, sq. ft. per floor: _____

Use group: _____

Construction type:

☐ Reinforced Concrete

☐ Structural Steel

☐ Masonry

☐ Wood Frame

☐ State Certified Modular

Utilities

Water Supply:

☐ Public

☐ Private

Sewage Disposal:

☐ Public

☐ Private

Electric Yes ☐ No ☐

Gas Yes ☐ No ☐

Heating System:

Electric ☐ Oil ☐

Natural Gas ☐

Propane Gas ☐

Sprinkler system: N/A ☐

☐ Full

☐ Partial

☐ Other Suppression

☐ # of Heads

BUILDING DESCRIPTION - RESIDENTIAL

Building Characteristics

SF Dwelling ☐ SF Townhouse ☐

Depth _____ Width _____

1st floor: _____

2nd floor: _____

Basement: _____

Finished Basement ☐ Unfinished Basement ☐

Crawl space ☐ Slab on Grade ☐

No. of Bedrooms _____

Height: _____

Multi-family dwellings:

No. of efficiency units: _____

No. of 1 BR units: _____

No. of 2 BR units: _____

No. of 3 BR units: _____

Other Structure: _____

Dimensions: _____

Footings: _____

Roof Height: _____

☐ State Certified Modular

☐ Manufactured Home

Utilities

Water Supply:

☐ Public

☒ Private

Sewage Disposal:

☐ Public

☒ Private

Electric Yes ☐ No ☐

Gas Yes ☐ No ☐

Heating System:

Electric ☐ Oil ☐

Natural Gas ☐

Propane Gas ☐

Sprinkler system: N/A ☐

☐ NFPA #13D

☐ NFPA #13R

☐ Other:

THE UNDERSIGNED HEREBY CERTIFIES AND AGREES AS FOLLOWS: (1) THAT HE/SHE IS AUTHORIZED TO MAKE THIS APPLICATION; (2) THAT THE INFORMATION IS CORRECT; (3) THAT HE/SHE WILL COMPLY WITH ALL REGULATIONS OF HOWARD COUNTY WHICH ARE APPLICABLE THERETO; (4) THAT HE/SHE WILL PERFORM NO WORK ON THE ABOVE REFERENCED PROPERTY NOT SPECIFICALLY DESCRIBED IN THIS APPLICATION; (5) THAT HE/SHE GRANTS COUNTY OFFICIALS THE RIGHT TO ENTER ONTO THIS PROPERTY FOR THE PURPOSE OF INSPECTING THE WORK PERMITTED AND POSTING NOTICES.

Applicant's Signature

Title/Company

Print Name

Date

Checks payable to: **DIRECTOR OF FINANCE OF HOWARD COUNTY**

** PLEASE WRITE NEATLY AND LEGIBLY. **

- FOR OFFICE USE ONLY -

AGENCY

DATE

SIGNATURE APPROVAL

DPZ SETBACK INFORMATION

PROPERTY ID#:

Land Development, DPZ

State Highways

Building Official

Dev. Engineering, DPZ

Health

Fire Protection

Is Sediment Control approval required prior to issuance?

YES ☐ NO ☐

CONTINGENCY CONSTRUCTION START: ☐

ONE STOP SHOP: ☐

Front: _____

Rear: _____

Side: _____

Side St.: _____

All minimum setbacks met?

YES ☐ NO ☐

Is Entrance Permit required?

YES ☐ NO ☐

Historic District?

YES ☐ NO ☐

Lot Coverage for NewTown Zone

SDP/Red-line approval date

Filing fee

Permit fee

Excise tax

Add'l per. fee

TOTAL FEES

Sub-total paid

Balance due

Check

Validation

\$ _____

\$ 100.00

\$ _____

\$ 10.00

\$ _____

\$ _____

\$ _____

2000

Accepted by

Distribution of Copies-

White: Building Official

Green: LDD, DPZ


Yellow: DED, DPZ

Pink: Health

Gold: SHA

T:\forms\PERMIT.FRM

Rev. 11/4/04

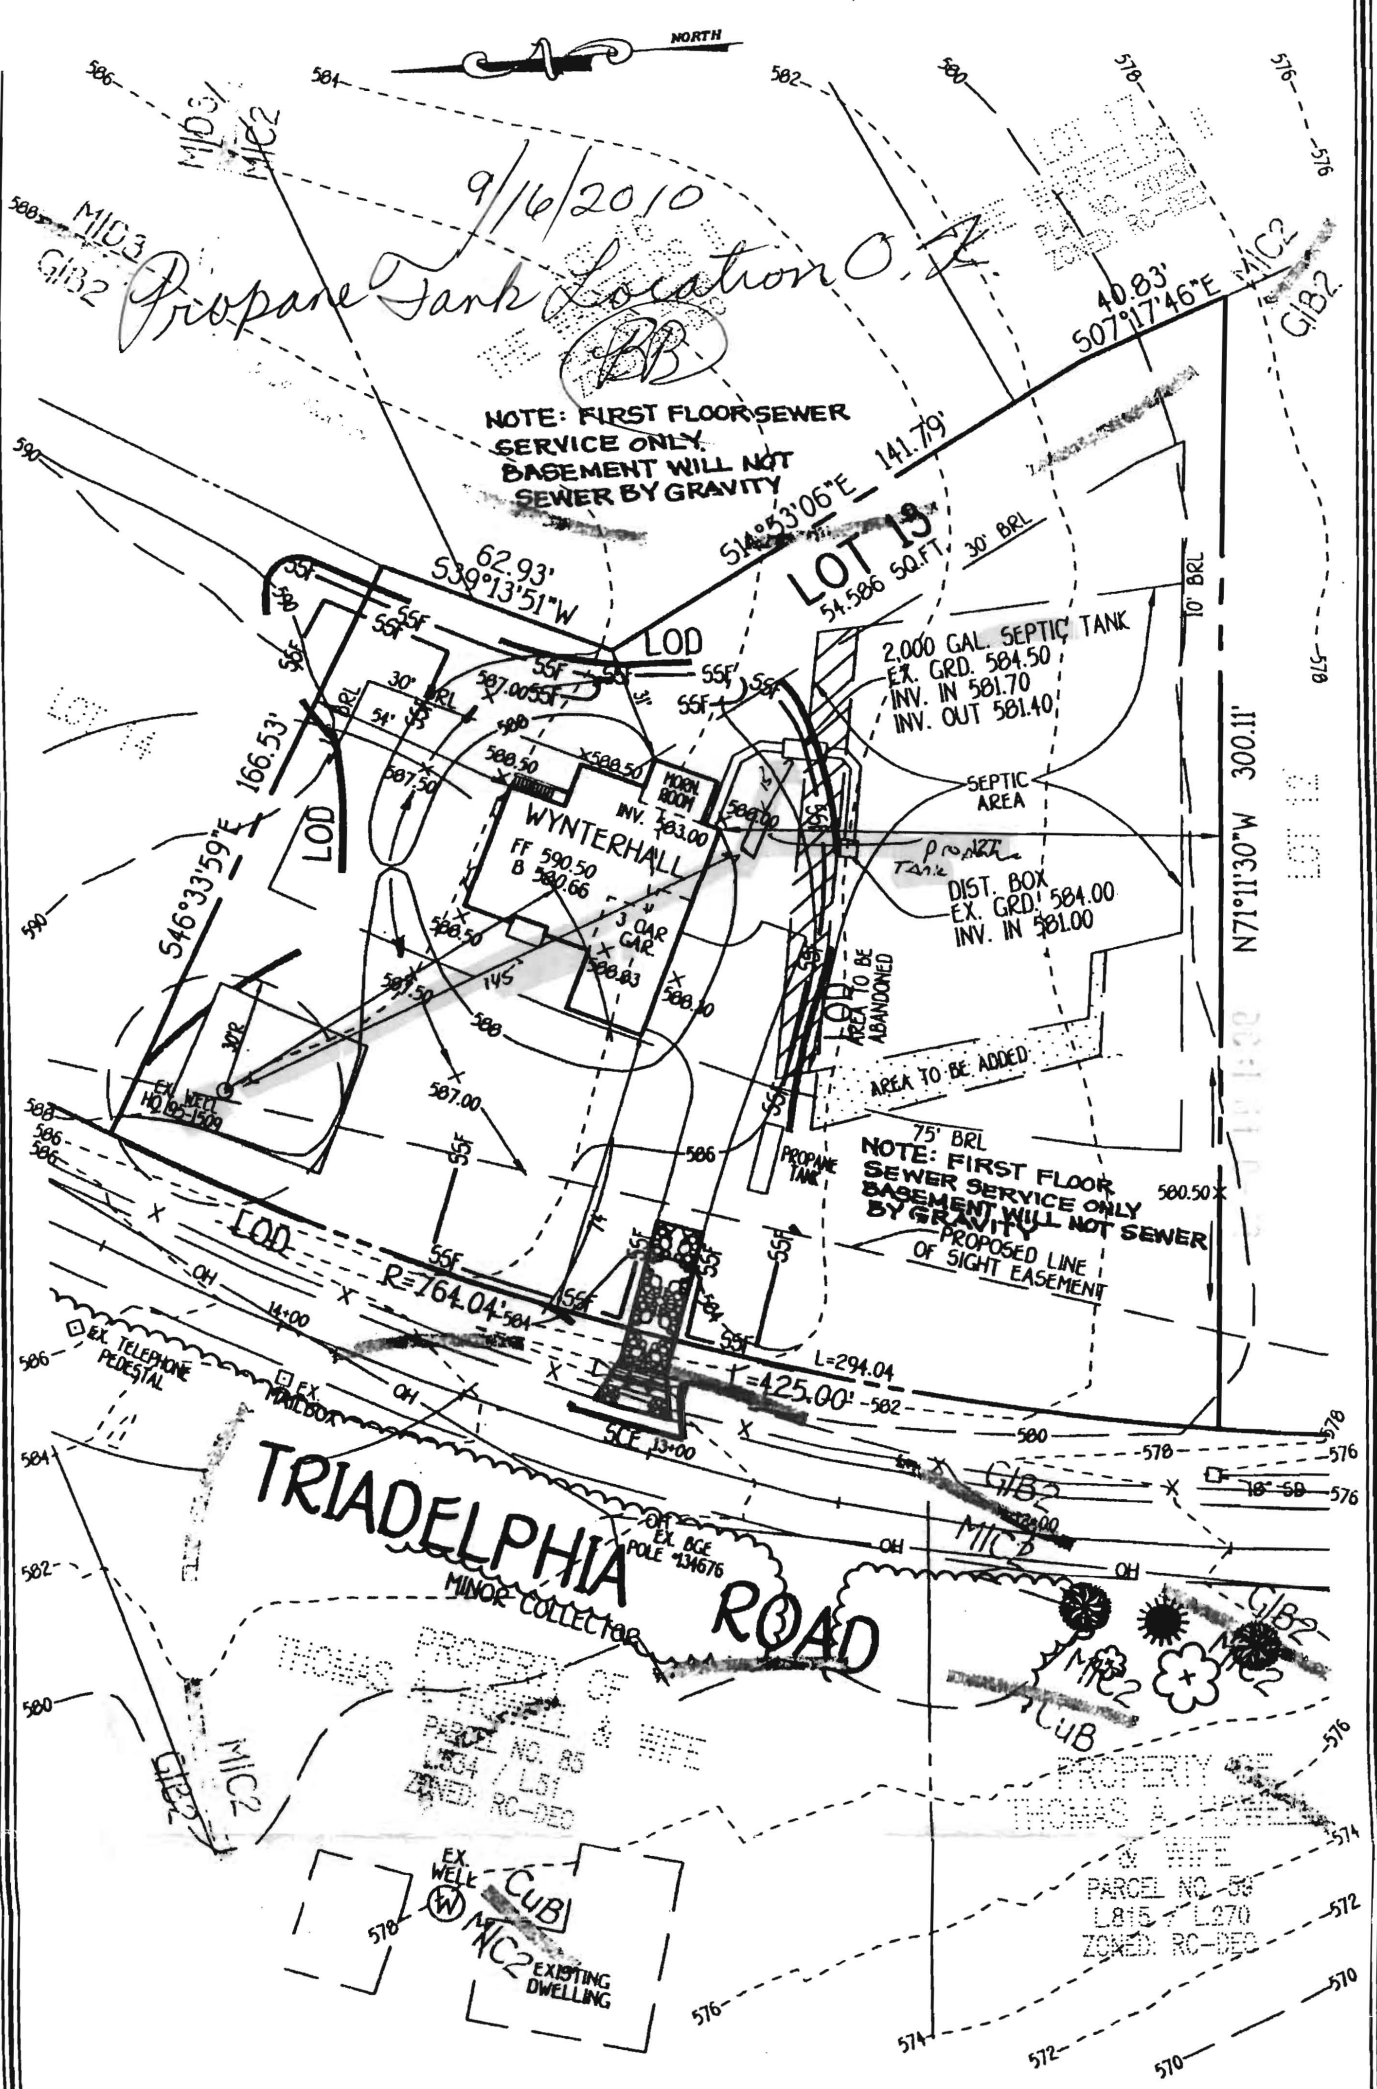

FISHER, COLLINS & CARTER, INC.
CIVIL ENGINEERING CONSULTANTS & LAND SURVEYORS
CENTENNIAL SQUARE OFFICE PARK - 10272 BALTIMORE NATIONAL PIKE
ELLCOTT CITY, MARYLAND 21042
(410) 461 - 2855

THE WARFIELDS II
LOT 13
SECTION TWO
ZONED: RC-DEO

TAX MAP NO.: 21 GRID NO.: 23 PARCEL NO.: 55
4TH ELECTION DISTRICT HOWARD COUNTY, MARYLAND
SCALE: 1" = 50' DATE: JUNE, 2010

DEPT. OF INSPECTIONS, LICENSES AND PERMITS 3430 COURT HOUSE DRIVE ELLCOTT CITY, MD 21043 PERMITS (410) 313-2455 INSPECTIONS (410) 313-1810 AUTOMATED INFORMATION (410) 313-3800		HOWARD COUNTY PERMIT APPLICATION		PERMIT NUMBER B10001885	
Building Address 14581 Triadelphia Road Ellicott City MD 21042			Property Owner's Name NYR Inc. Address 6085 Marshalee Dr #130 City Elkridge State MD Zip Code 21075 Home Phone Work Phone Applicant's Name & Mailing Address, (if other than stated herein): Jim Kerwin P.O. Box 352 Woodbine, MD 21797 Phone 410-301-7712 Fax 410-301-7713		
Suite/Apt. #: SDP/WP/Petition #: Census Tract Subdivision Warfields Section Area Lot 13 Tax Map Parcel Grid Zoning Map Coordinates Lot Size			Contractor Company Contact Person Address City State Zip Code License No. Phone Fax Engineer or Architect Company Contact Person Address City State Zip Code Phone Fax		
Existing Use Vacant plot Proposed Use Single family home Estimated Construction Cost \$ 250,000 Description of Work New 2 Story Winter Hall with 3 car garage morning room basement Occupant or Tenant Contact Name Address City State Zip Code Phone Fax					

BUILDING DESCRIPTION - COMMERCIAL		BUILDING DESCRIPTION - RESIDENTIAL	
Building Characteristics Height: No. of stories: Gross area, sq. ft. per floor: Use group: Construction type: Reinforced Concrete Structural Steel Masonry Wood Frame State Certified Modular	Utilities Water Supply: Public Private Sewage Disposal: Public Private Electric Yes <input type="checkbox"/> No <input type="checkbox"/> Gas Yes <input type="checkbox"/> No <input type="checkbox"/> Heating System: Electric <input type="checkbox"/> Oil <input type="checkbox"/> Natural Gas <input type="checkbox"/> Propane Gas <input type="checkbox"/> Sprinkler system: N/A <input type="checkbox"/> Full Partial Other Suppression # of Heads	Building Characteristics SF Dwelling <input type="checkbox"/> SF Townhouse <input type="checkbox"/> Depth Width 1st floor: 70 x 34 2nd floor: 11 x 51 Basement: 54 x 54 Finished Basement <input type="checkbox"/> Unfinished Basement <input type="checkbox"/> Crawl space <input type="checkbox"/> Slab on Grade <input type="checkbox"/> No. of Bedrooms 4 Multi-family dwellings: No. of efficiency units: No. of 1 BR units: No. of 2 BR units: No. of 3 BR units: Other Structure: Dimensions: Footings: Roof: State Certified Modular Manufactured Home	Utilities Water Supply: Public Private Sewage Disposal: Public Private Electric Yes <input type="checkbox"/> No <input type="checkbox"/> Gas Yes <input type="checkbox"/> No <input type="checkbox"/> Heating System: Electric <input type="checkbox"/> Oil <input type="checkbox"/> Natural Gas <input type="checkbox"/> Propane Gas <input type="checkbox"/> Sprinkler system: N/A <input type="checkbox"/> NFPA #13D NFPA #13R Other:

THE UNDERSIGNED HEREBY CERTIFIES AND AGREES AS FOLLOWS: (1) THAT HE/SHE IS AUTHORIZED TO MAKE THIS APPLICATION; (2) THAT THE INFORMATION IS CORRECT; (3) THAT HE/SHE WILL COMPLY WITH ALL REGULATIONS OF HOWARD COUNTY WHICH ARE APPLICABLE THERETO; (4) THAT HE/SHE WILL PERFORM NO WORK ON THE ABOVE REFERENCED PROPERTY NOT SPECIFICALLY DESCRIBED IN THIS APPLICATION; (5) THAT HE/SHE GRANTS COUNTY OFFICIALS THE RIGHT TO ENTER ONTO THIS PROPERTY FOR THE PURPOSE OF INSPECTING THE WORK PERMITTED AND POSTING NOTICES.

Applicant's Signature	Print Name
Email Address	
Title/Company	Date

Checks payable to: DIRECTOR OF FINANCE OF HOWARD COUNTY
PLEASE WRITE NEATLY AND LEGIBLY.

AGENCY Land Development, DPZ	DATE 7/15/10	SIGNATURE APPROVAL John Satt	DPZ SETBACK INFORMATION Front: Rear: Side: Side St.: All minimum setbacks met? YES <input type="checkbox"/> NO <input type="checkbox"/>	PROPERTY ID # Filing fee \$ Permit fee \$ Excise tax \$ Add'l per fee \$ TOTAL FEES \$ Sub-total paid \$ Balance due \$ Check # Validation #
State Highways			Is Entrance Permit Required? YES <input type="checkbox"/> NO <input type="checkbox"/>	
Building Officials			Historic District? YES <input type="checkbox"/> NO <input type="checkbox"/>	
Dev. Engineering, DPZ			Lot Coverage for New Town Zone SDP/Red-line approval date	
Health				
Fire Protection				
Is Sediment Control approval required prior to issuance? YES <input type="checkbox"/> NO <input type="checkbox"/>				


CONTINGENCY CONSTRUCTION START: ☐
ONE STOP SHOP: ☐

Accepted by

Approved Septic System Plan
Howard County Health Department

Neeraj 7/15/10
Signature Date

corner of SDA
over
driveway
OK MJD

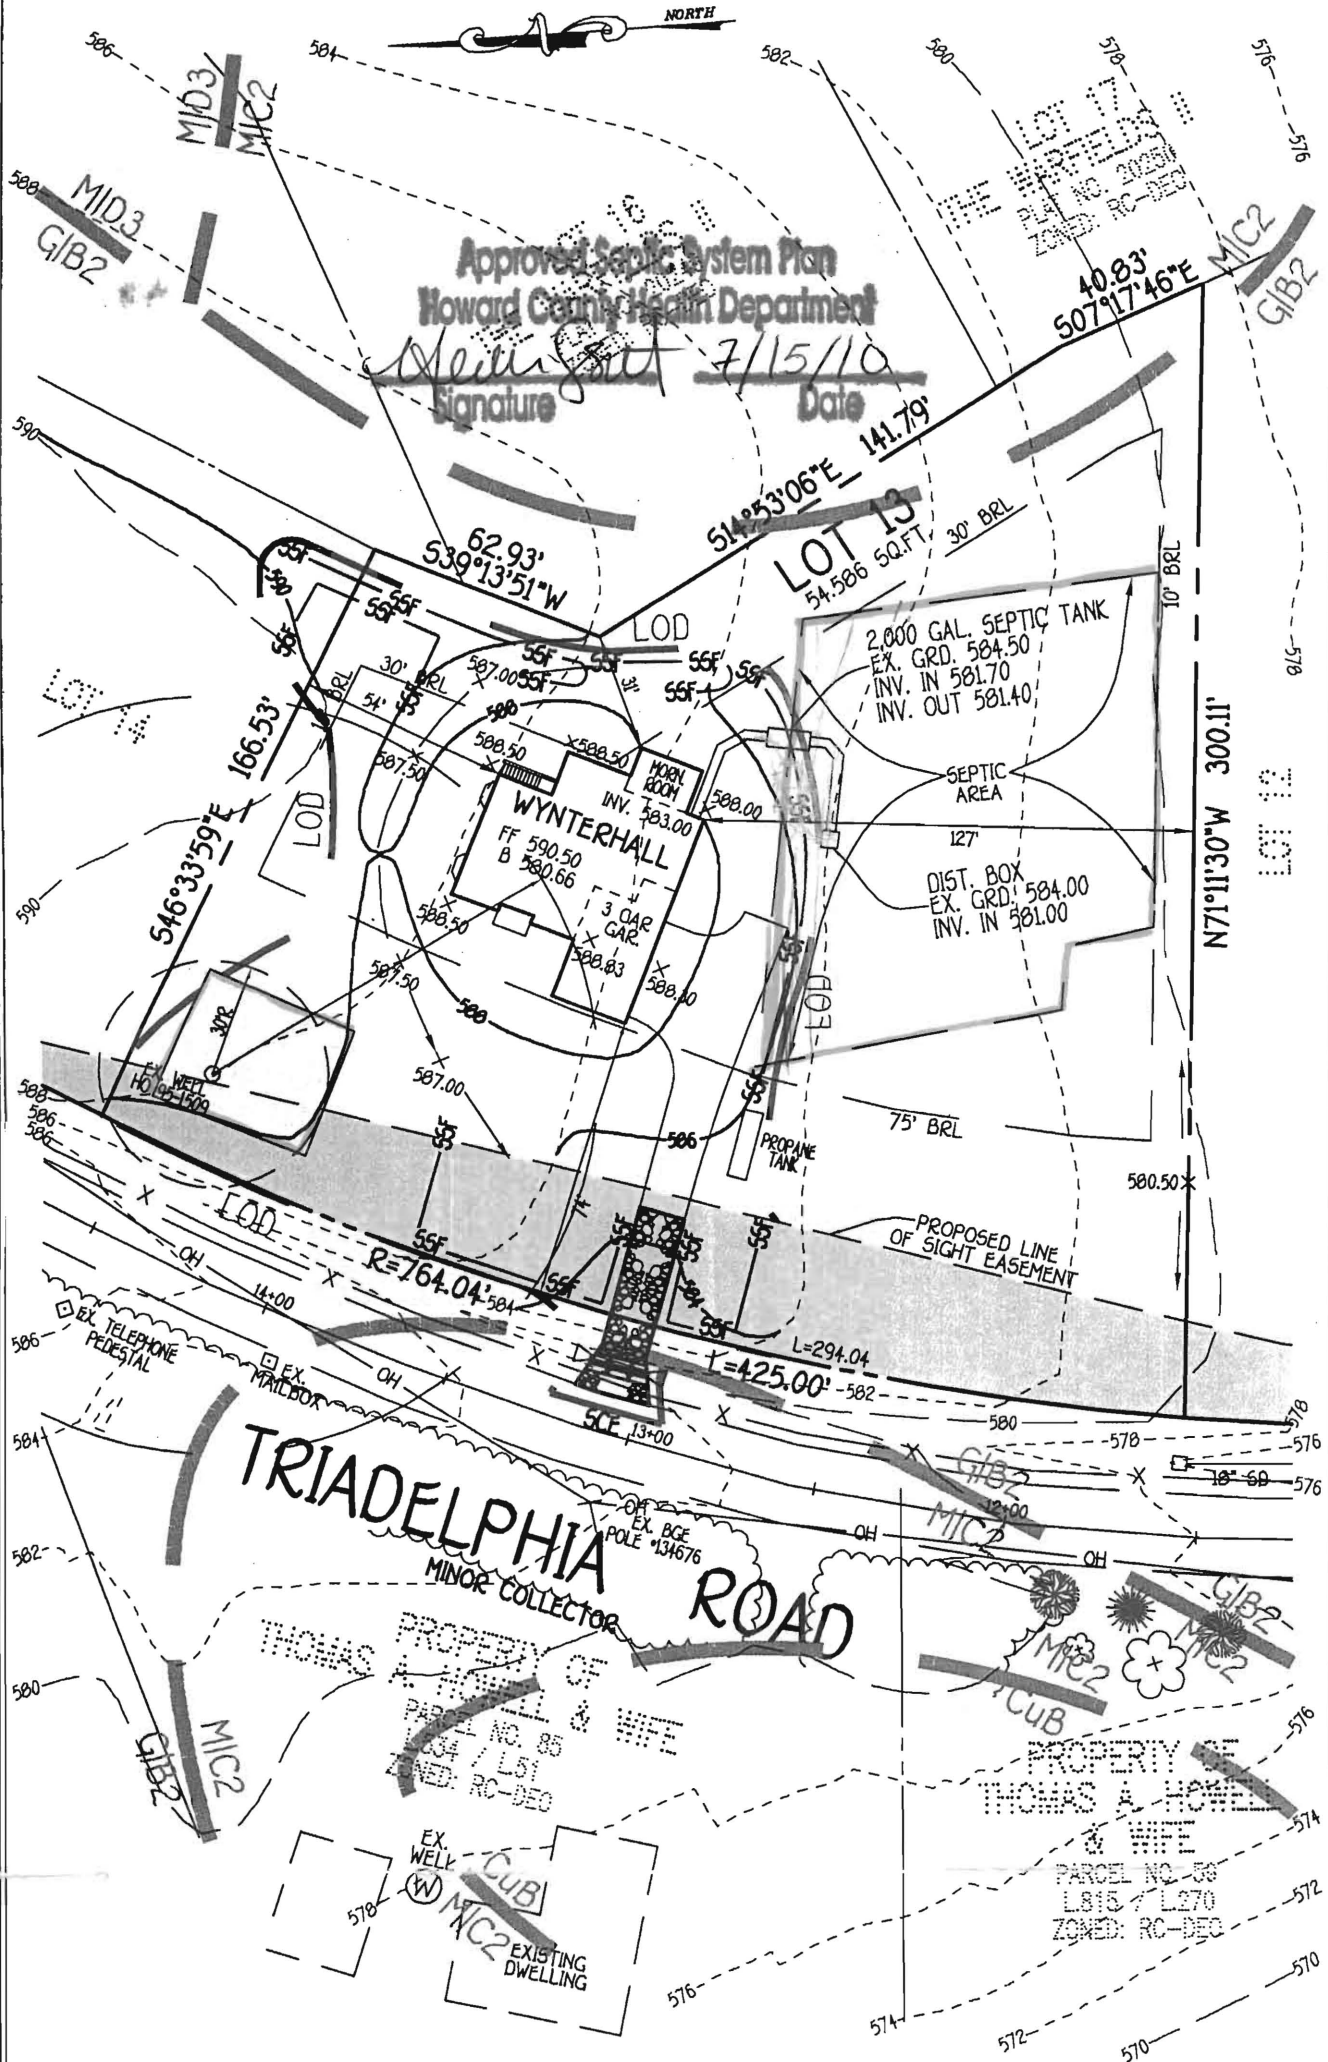

TRIADELPHIA ROAD
MINOR COLLECTOR

PROPERTY OF
THOMAS A. HOWELL & WIFE
PARCEL NO. 85
L834 / L851
ZONED: RC-DEO

PROPERTY OF
THOMAS A. HOWELL & WIFE
PARCEL NO. 86
L815 / L870
ZONED: RC-DEO

THE WARFIELDS II
LOT 13
SECTION TWO
ZONED: RC-DEO

FISHER, COLLINS & CARTER, INC.
CIVIL ENGINEERING CONSULTANTS & LAND SURVEYORS

CENTENNIAL SQUARE OFFICE PARK - 10272 BALTIMORE NATIONAL PIKE
ELLICOTT CITY, MARYLAND 21042
(410) 461-2855

TAX MAP NO.: 21 GRID NO.: 23 PARCEL NO.: 55
4TH ELECTION DISTRICT HOWARD COUNTY, MARYLAND
SCALE: 1" = 50' DATE: JUNE, 2010