

APPLICATION

SEWAGE DISPOSAL TESTING

A 16100

P _____

MARYLAND STATE DEPARTMENT OF HEALTH

HOWARD COUNTY

ELLICOTT CITY

DISTRICT 5th

DATE 7-9-71

Septic Tank - 1250 gal.

Dry Well - 400 sq ft effective area to begin

3 1/2 ft below the first 1 1/2 ft of original grade

Locate Dry well - 19 ft from home in front of house
and 63 ft from edge of driveway.

TO: THE COUNTY HEALTH OFFICER
ELLICOTT CITY, MARYLAND

I, HEREBY, APPLY FOR THE NECESSARY TESTS IN ORDER TO CONSTRUCT (OR RECONSTRUCT) A SEWAGE DISPOSAL SYSTEM.

PROPERTY OWNER Charles McFann

OLD: 3664 Hipsley Mill Rd., Woodbine, Md.

ADDRESS 14831 Triadelphia Rd., Glenelg, Md.

PHONE 489-4300

PROPERTY LOCATION:

SUBDIVISION _____ LOT NO. _____

ROAD AND DESCRIPTION 14831 Triadelphia Rd., Glenelg, Md. (SAPLING RANCH)

there is a sign

OCCUPANT _____

PERSON TO CONSTRUCT SYSTEM _____

ADDRESS _____

PHONE _____

SIZE OF LOT 37 Acres

TYPE BLDG. 4 - Bedrooms

NUMBER OF BEDROOMS

IF NOT SINGLE RESIDENCE DESCRIBE _____

SIGNATURE OF APPLICANT

Charles McFann

APPROVED BY

Dr. Monaghan

FOR

Dry Well

DATE

7-29-71

REJECTED BY _____

FOR

(KIND OF SYSTEM)


DATE

HOLD PENDING FURTHER TESTS _____

DATE

REASONS FOR REJECTION OR HOLDING _____

THIS IS NOT A PERMIT

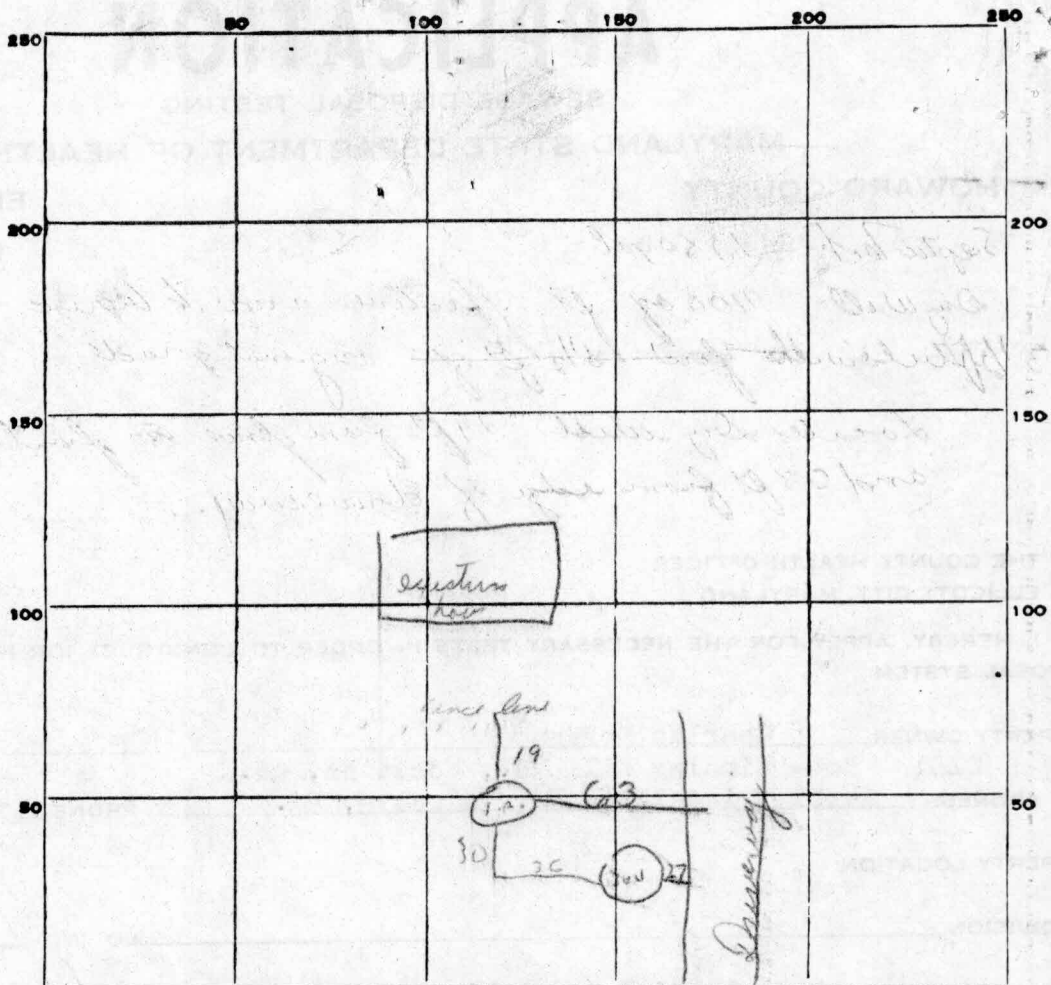

INDICATE NORTH. - NAME ADJOINING ROADWAY AS BASE LINE.

Madeline Rd

DATE	TEST NO.	DEPTH	PRE-WET		TEST - 1" DROP		TIME
			START	STOP	START	STOP	
7/20/71	1	4ft	9 ⁵⁸	10 ⁰²	10 ⁰²	10 ⁰⁷	5 min
	2	12ft	9 ⁵⁹	10 ⁰²	10 ⁰³	10 ¹⁴	11 min
	3	4ft	10 ⁰⁰	10 ⁰⁵	10 ⁰⁵	10 ¹⁰	5 min
	4	12ft	10 ⁰⁰	10 ⁰⁶	10 ⁰⁶	10 ¹⁶	10 min

SOIL AUGER FINDING *Good soil starts at 3ft*

TESTED BY _____

REMARKS _____

APPLICATION

SEWAGE DISPOSAL TESTING

A 16100

P _____

MARYLAND STATE DEPARTMENT OF HEALTH

HOWARD COUNTY

ELLICOTT CITY

Septic Tank - 1350 gal.

DISTRICT 5th

Dry Well - 400 sq ft effective area to be in

DATE 7-9-71

3 1/2 ft below the first 5 1/2 ft of original grade

Locate Dry Well 19 ft from fence in front of house
and 63 ft from edge of driveway.

TO: THE COUNTY HEALTH OFFICER
ELLICOTT CITY, MARYLAND

I, HEREBY, APPLY FOR THE NECESSARY TESTS IN ORDER TO CONSTRUCT (OR RECONSTRUCT) A SEWAGE DISPOSAL SYSTEM.

PROPERTY OWNER Charles McFann
OLD: 3664 Hipsley Mill Rd., Woodbine, Md.
ADDRESS 14831 Triadelphia Rd., Glenelg, Md. PHONE 489-4300

PROPERTY LOCATION:

SUBDIVISION _____ LOT NO. _____

ROAD AND DESCRIPTION 14831 Triadelphia Rd., Glenelg, Md.

OCCUPANT _____ PHONE _____

PERSON TO CONSTRUCT SYSTEM _____

ADDRESS _____ PHONE _____

SIZE OF LOT 37 Acres TYPE BLDG. Single Family Dwelling
4 - Bedrooms
NUMBER OF BEDROOMS

IF NOT SINGLE RESIDENCE DESCRIBE _____

SIGNATURE OF APPLICANT Mrs. Charles McFann

APPROVED BY D. Monaghan FOR Dry Well DATE 7-29-71
(KIND OF SYSTEM)

REJECTED BY _____ FOR _____ DATE _____
(KIND OF SYSTEM)

HOLD PENDING FURTHER TESTS _____ DATE _____

REASONS FOR REJECTION OR HOLDING _____

THIS IS NOT A PERMIT

13
19
27

① 7/5/88

orange/brown
hard chunky
clay/gravelly
mud 3 1/2 - 4 1/2'
more brown
orange silty
gummy clay loam
w/ patches of soil
9' b
starting to weather
(possible nodding)
11' b
HO 12' 0"


②

rock 5-6'
replaced
covered prior
to inspection

③

chunky red/
orange clay
clay loam
4-4 1/2'
changing to
tan/grey
mostly silty
loam w/ 5-10%
in shist frags
9' b


13' D (dry)

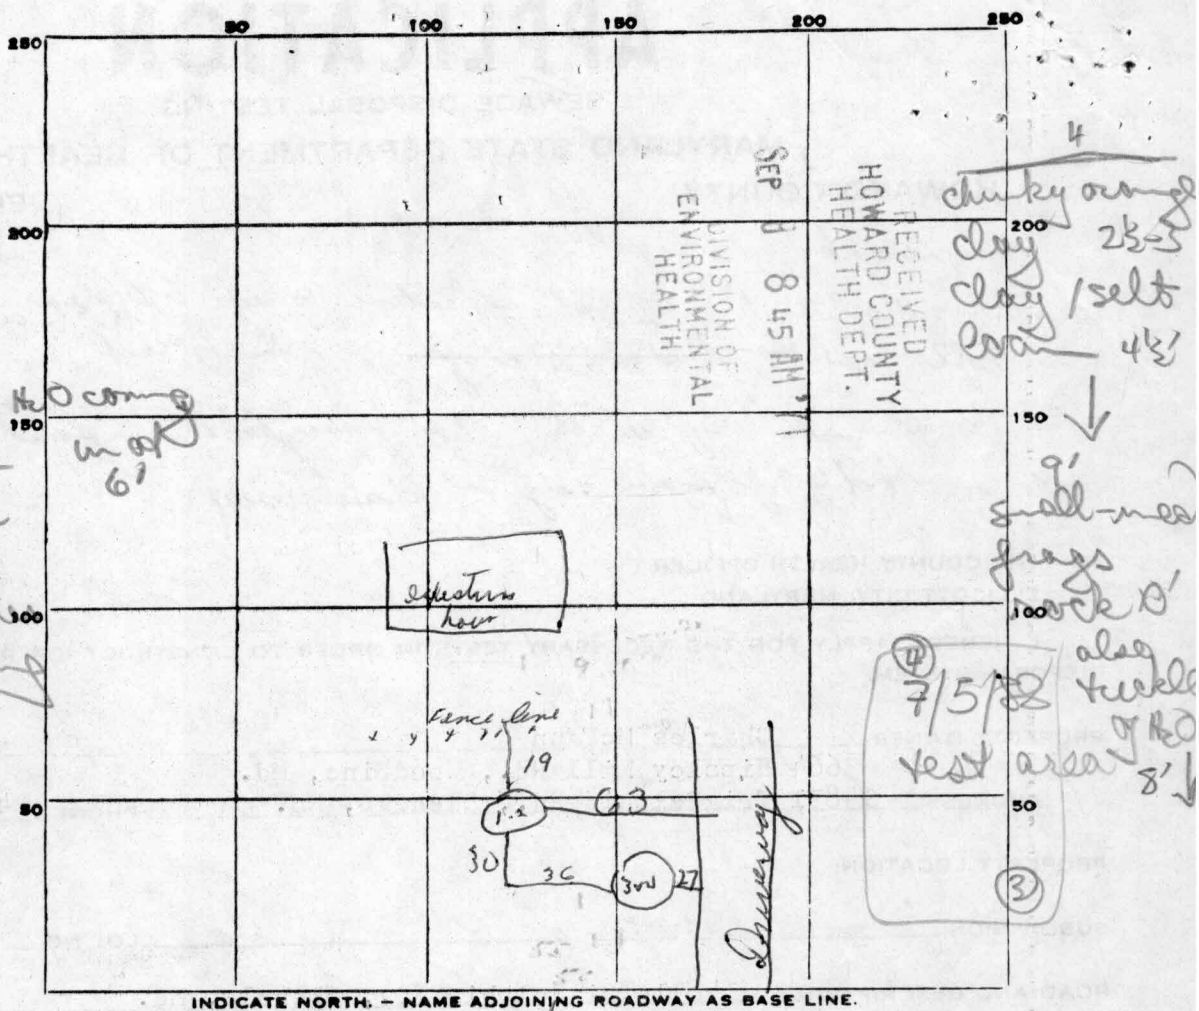

DATE	TEST NO.	DEPTH	PRE-WET		TEST - 1" DROP		TIME
			START	STOP	START	STOP	
7/25/71	1	4ft	9 58	10 02	10 02	10 07	5 min
	2	12ft	9 59	10 03	10 03	10 14	11 min
	3	4ft	10 00	10 05	10 05	10 10	5 min
	4	12ft	10 00	10 06	10 06	10 16	10 min
7/5/88	③	4' 5	12 59	10 06	10 06	11 18	12 min
		9' M	12 57	10 03	10 03	11 16	13 min
		13' D	bottom (see profile)				
	④	3 1/2 5	12 03	12 24	12 24	13 31	7 min
		7' M	11 19	12 25	12 25		
		10' D	hard bottom (see profile)				

SOIL AUGER FINDING good soil starts at 3ft

TESTED BY _____
REMARKS _____

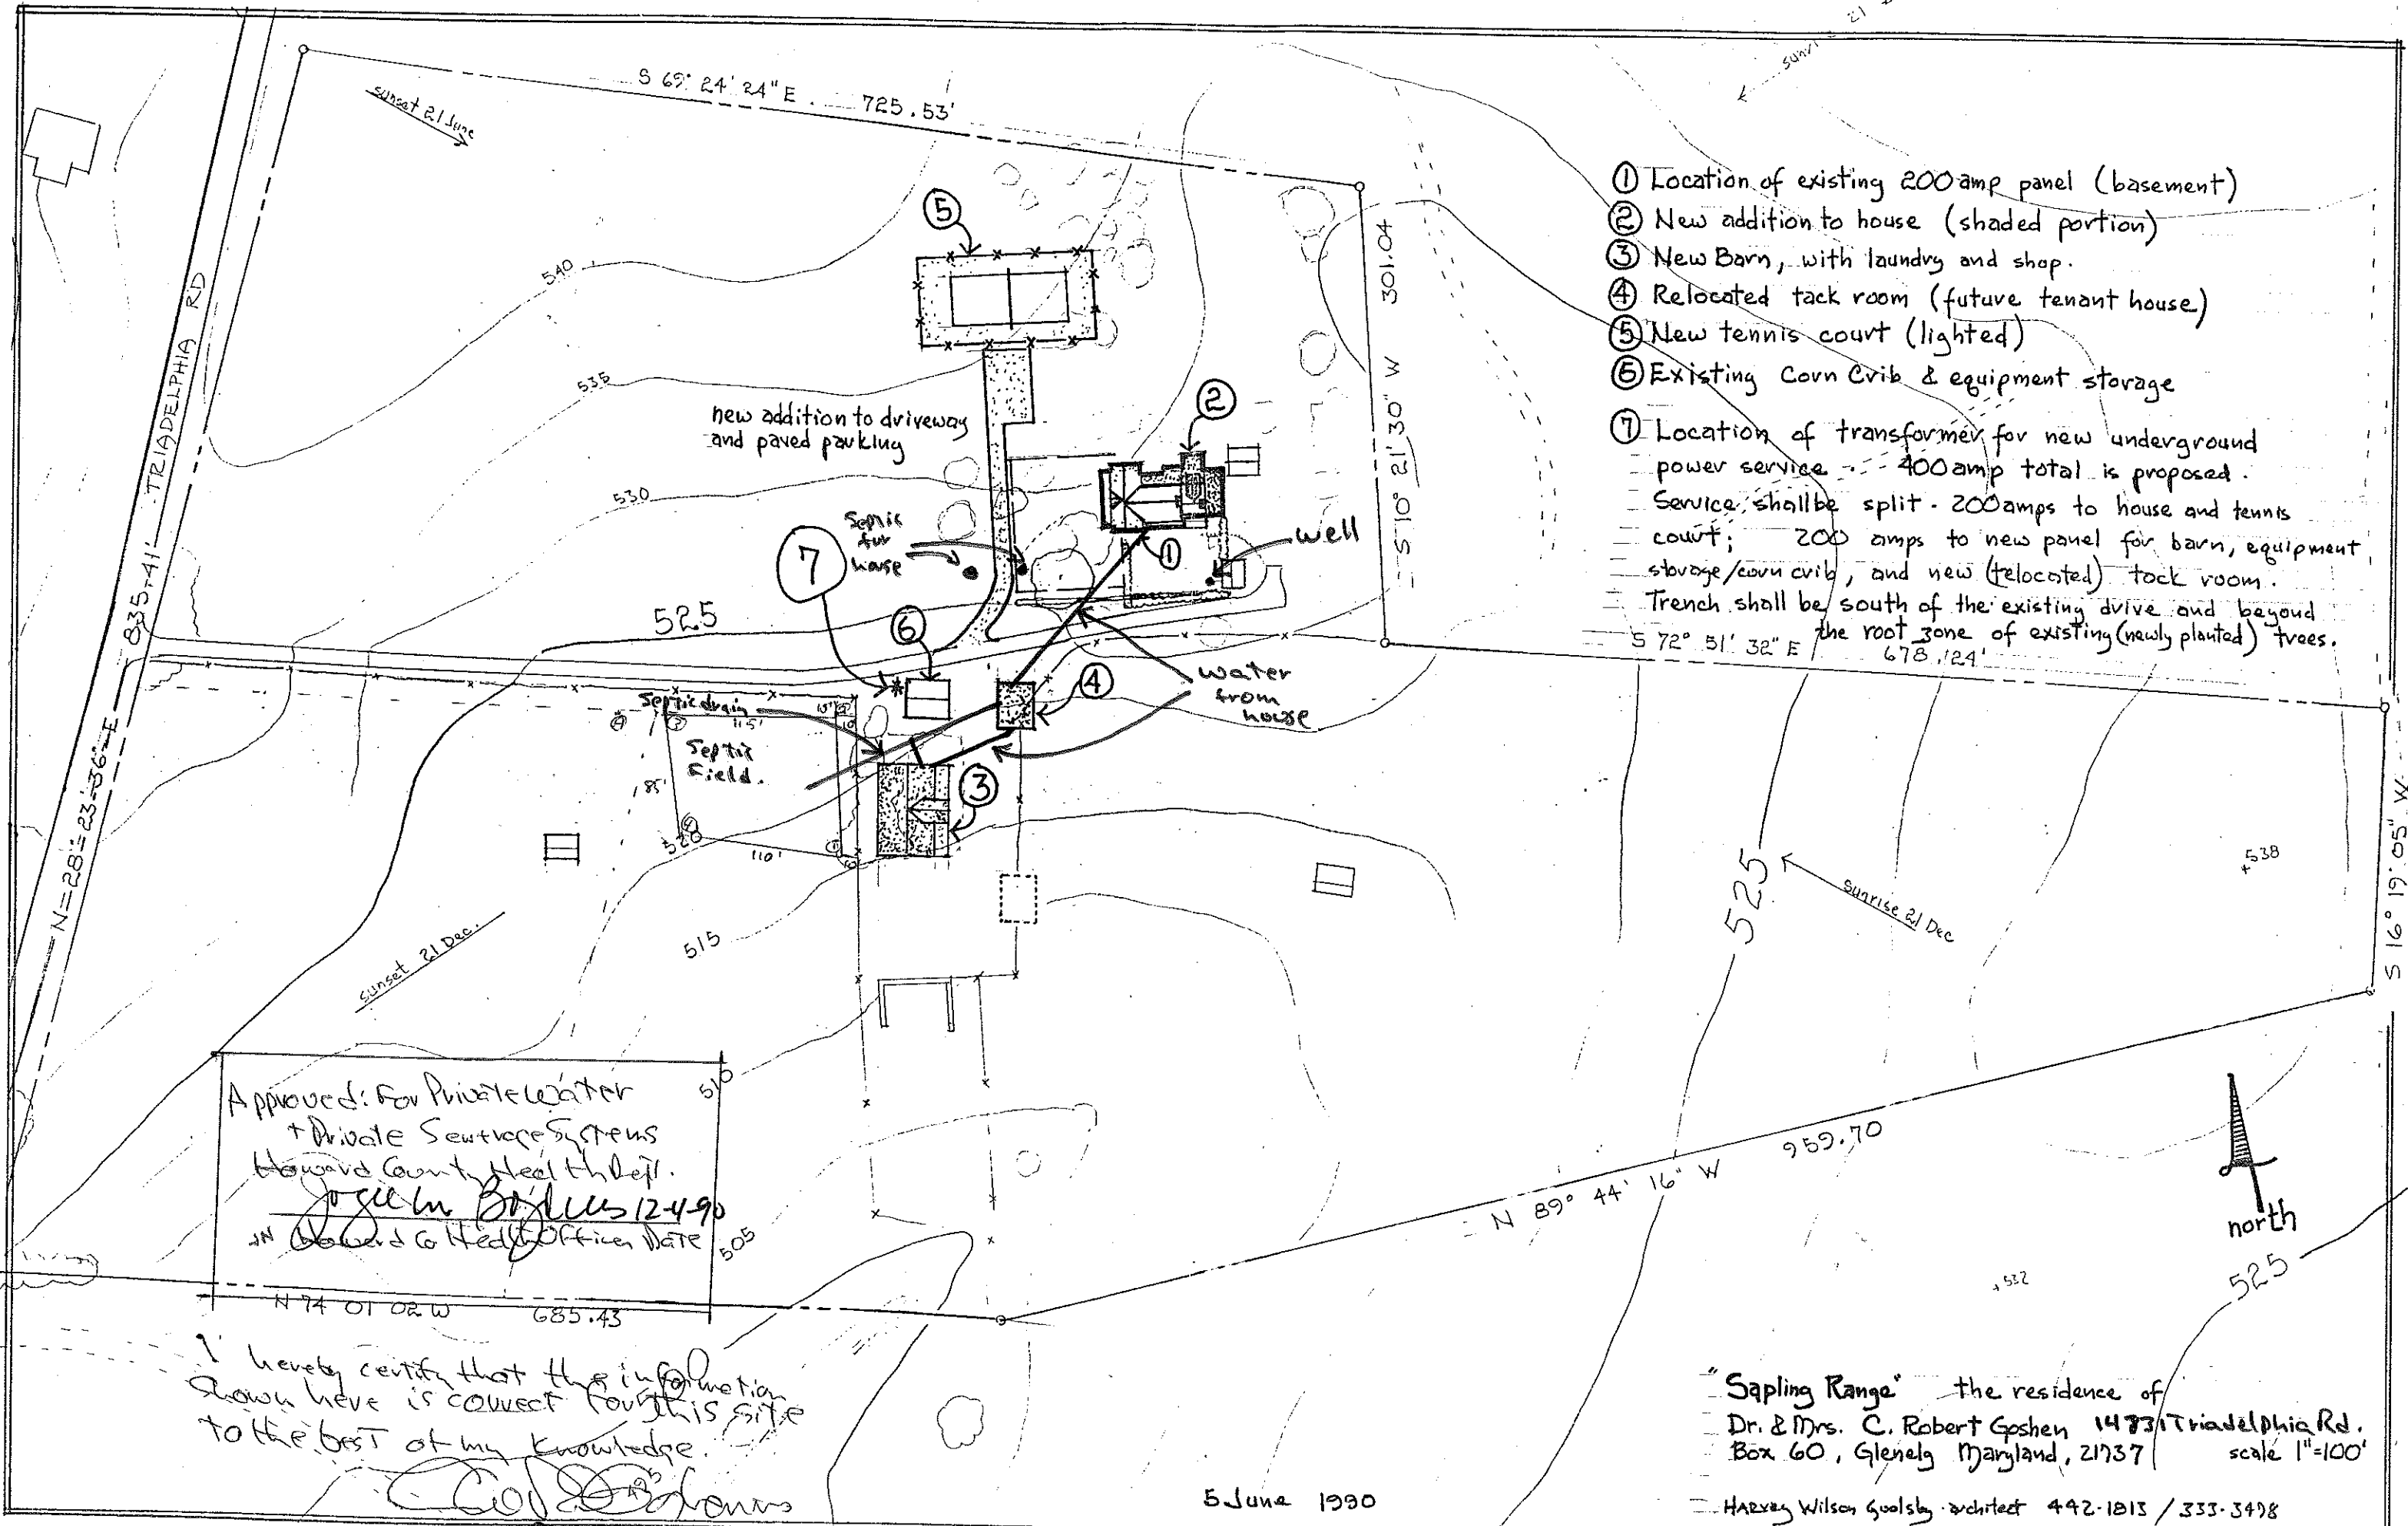

- ① Location of existing 200 amp panel (basement)
 - ② New addition to house (shaded portion)
 - ③ New Barn, with laundry and shop.
 - ④ Relocated tack room (future tenant house)
 - ⑤ New tennis court (lighted)
 - ⑥ Existing Corn Crib & equipment storage
 - ⑦ Location of transformer for new underground power service - 400 amp total is proposed.
- Service shall be split - 200 amps to house and tennis court; 200 amps to new panel for barn, equipment storage/corn crib, and new (relocated) tack room.
- Trench shall be south of the existing drive and beyond the root zone of existing (newly planted) trees.

Approved: For Private Water
+ Private Sewerage Systems
Howard County Health Dept.
John Boyle 12-490
IN Accordance With Office Note


I hereby certify that the information shown here is correct for this site to the best of my knowledge.

Charles Robert Goshen
Charles Robert Goshen, owner.

5 June 1990

"Sapling Range" the residence of
Dr. & Mrs. C. Robert Goshen 14831 Triadelphia Rd.
Box 60, Glenelg Maryland, 21737
scale 1"=100'

Harvey Wilson Goolsby architect 442-1813 / 333-3498

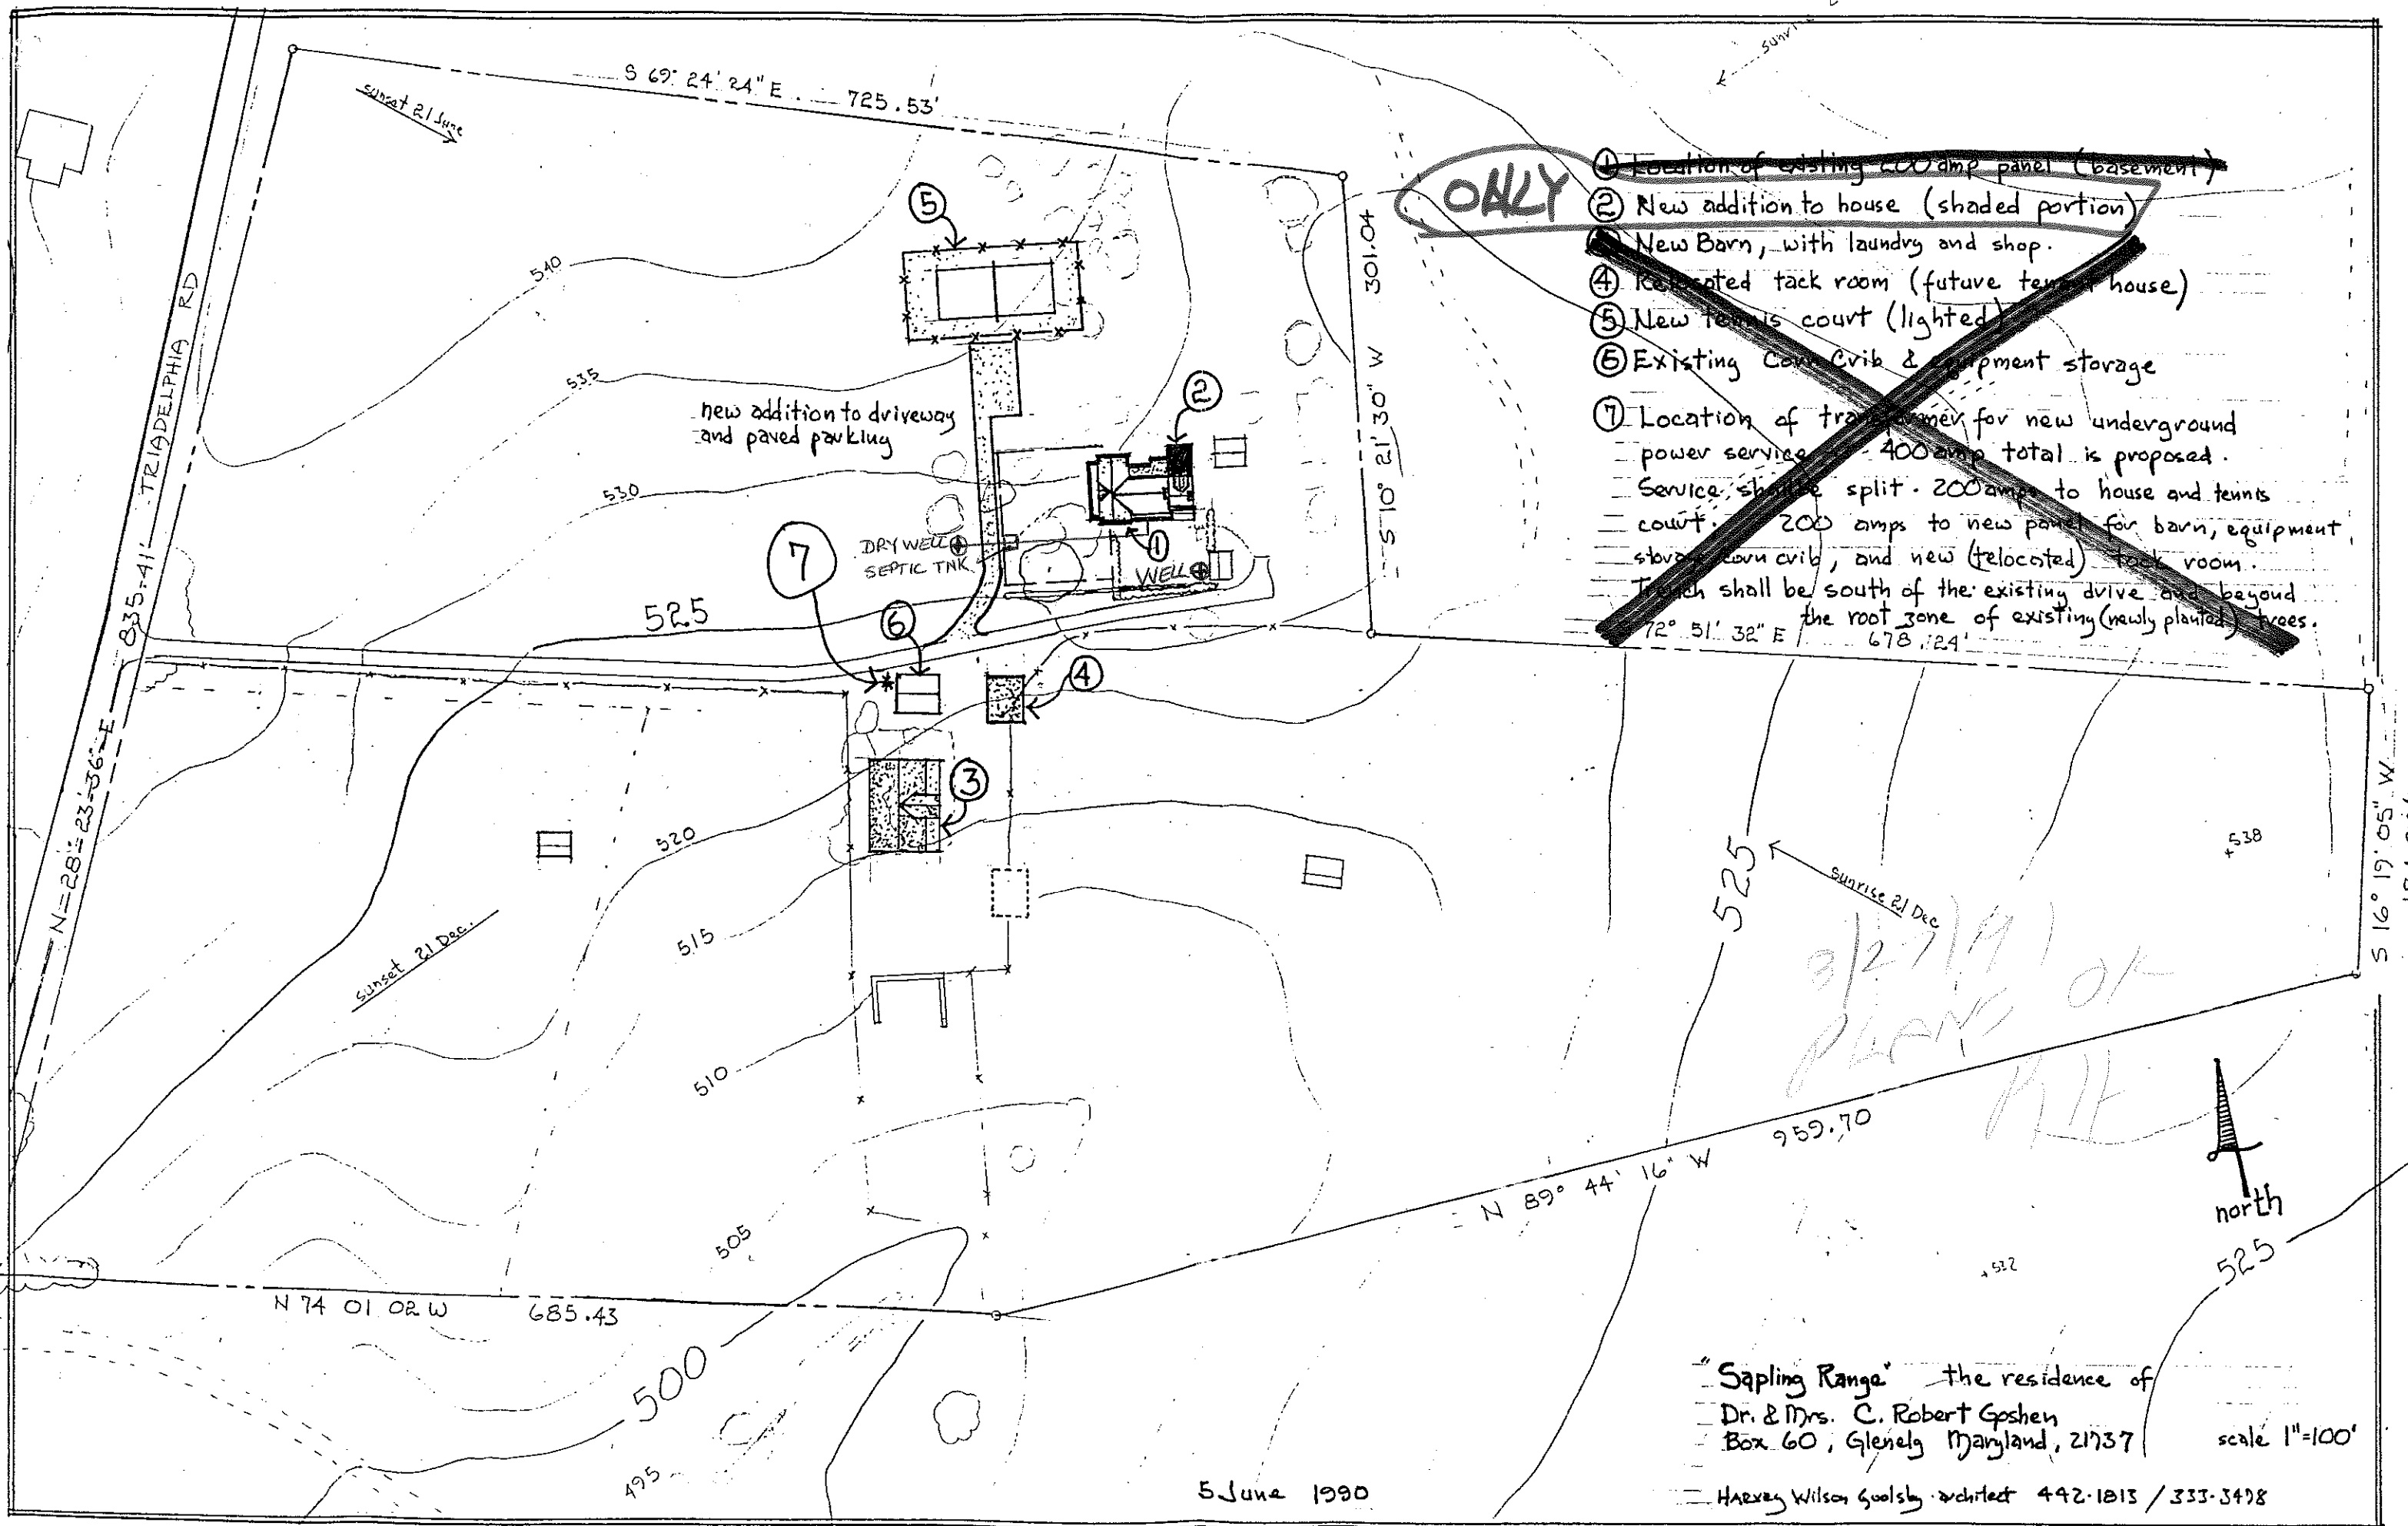


- ONLY**
- ① Location of existing 200 amp panel (basement)
 - ② New addition to house (shaded portion)
 - ③ New Barn, with laundry and shop.
 - ④ Relocated tack room (future tennis house)
 - ⑤ New tennis court (lighted)
 - ⑥ Existing horse crib & equipment storage
 - ⑦ Location of transformer for new underground power service. 400 amp total is proposed. Service shall be split. 200 amp to house and tennis court. 200 amp to new panel for barn, equipment storage, horse crib, and new (relocated) tack room. Trench shall be south of the existing drive and beyond the root zone of existing (newly planted) trees.

8/27/91 OK
PLANS
HIT

"Sapling Range" the residence of
Dr. & Mrs. C. Robert Goshen
Box 60, Glenelg Maryland, 21737
Harvey Wilson Goolsby architect 442-1813 / 333-3428
scale 1"=100'

5 June 1990

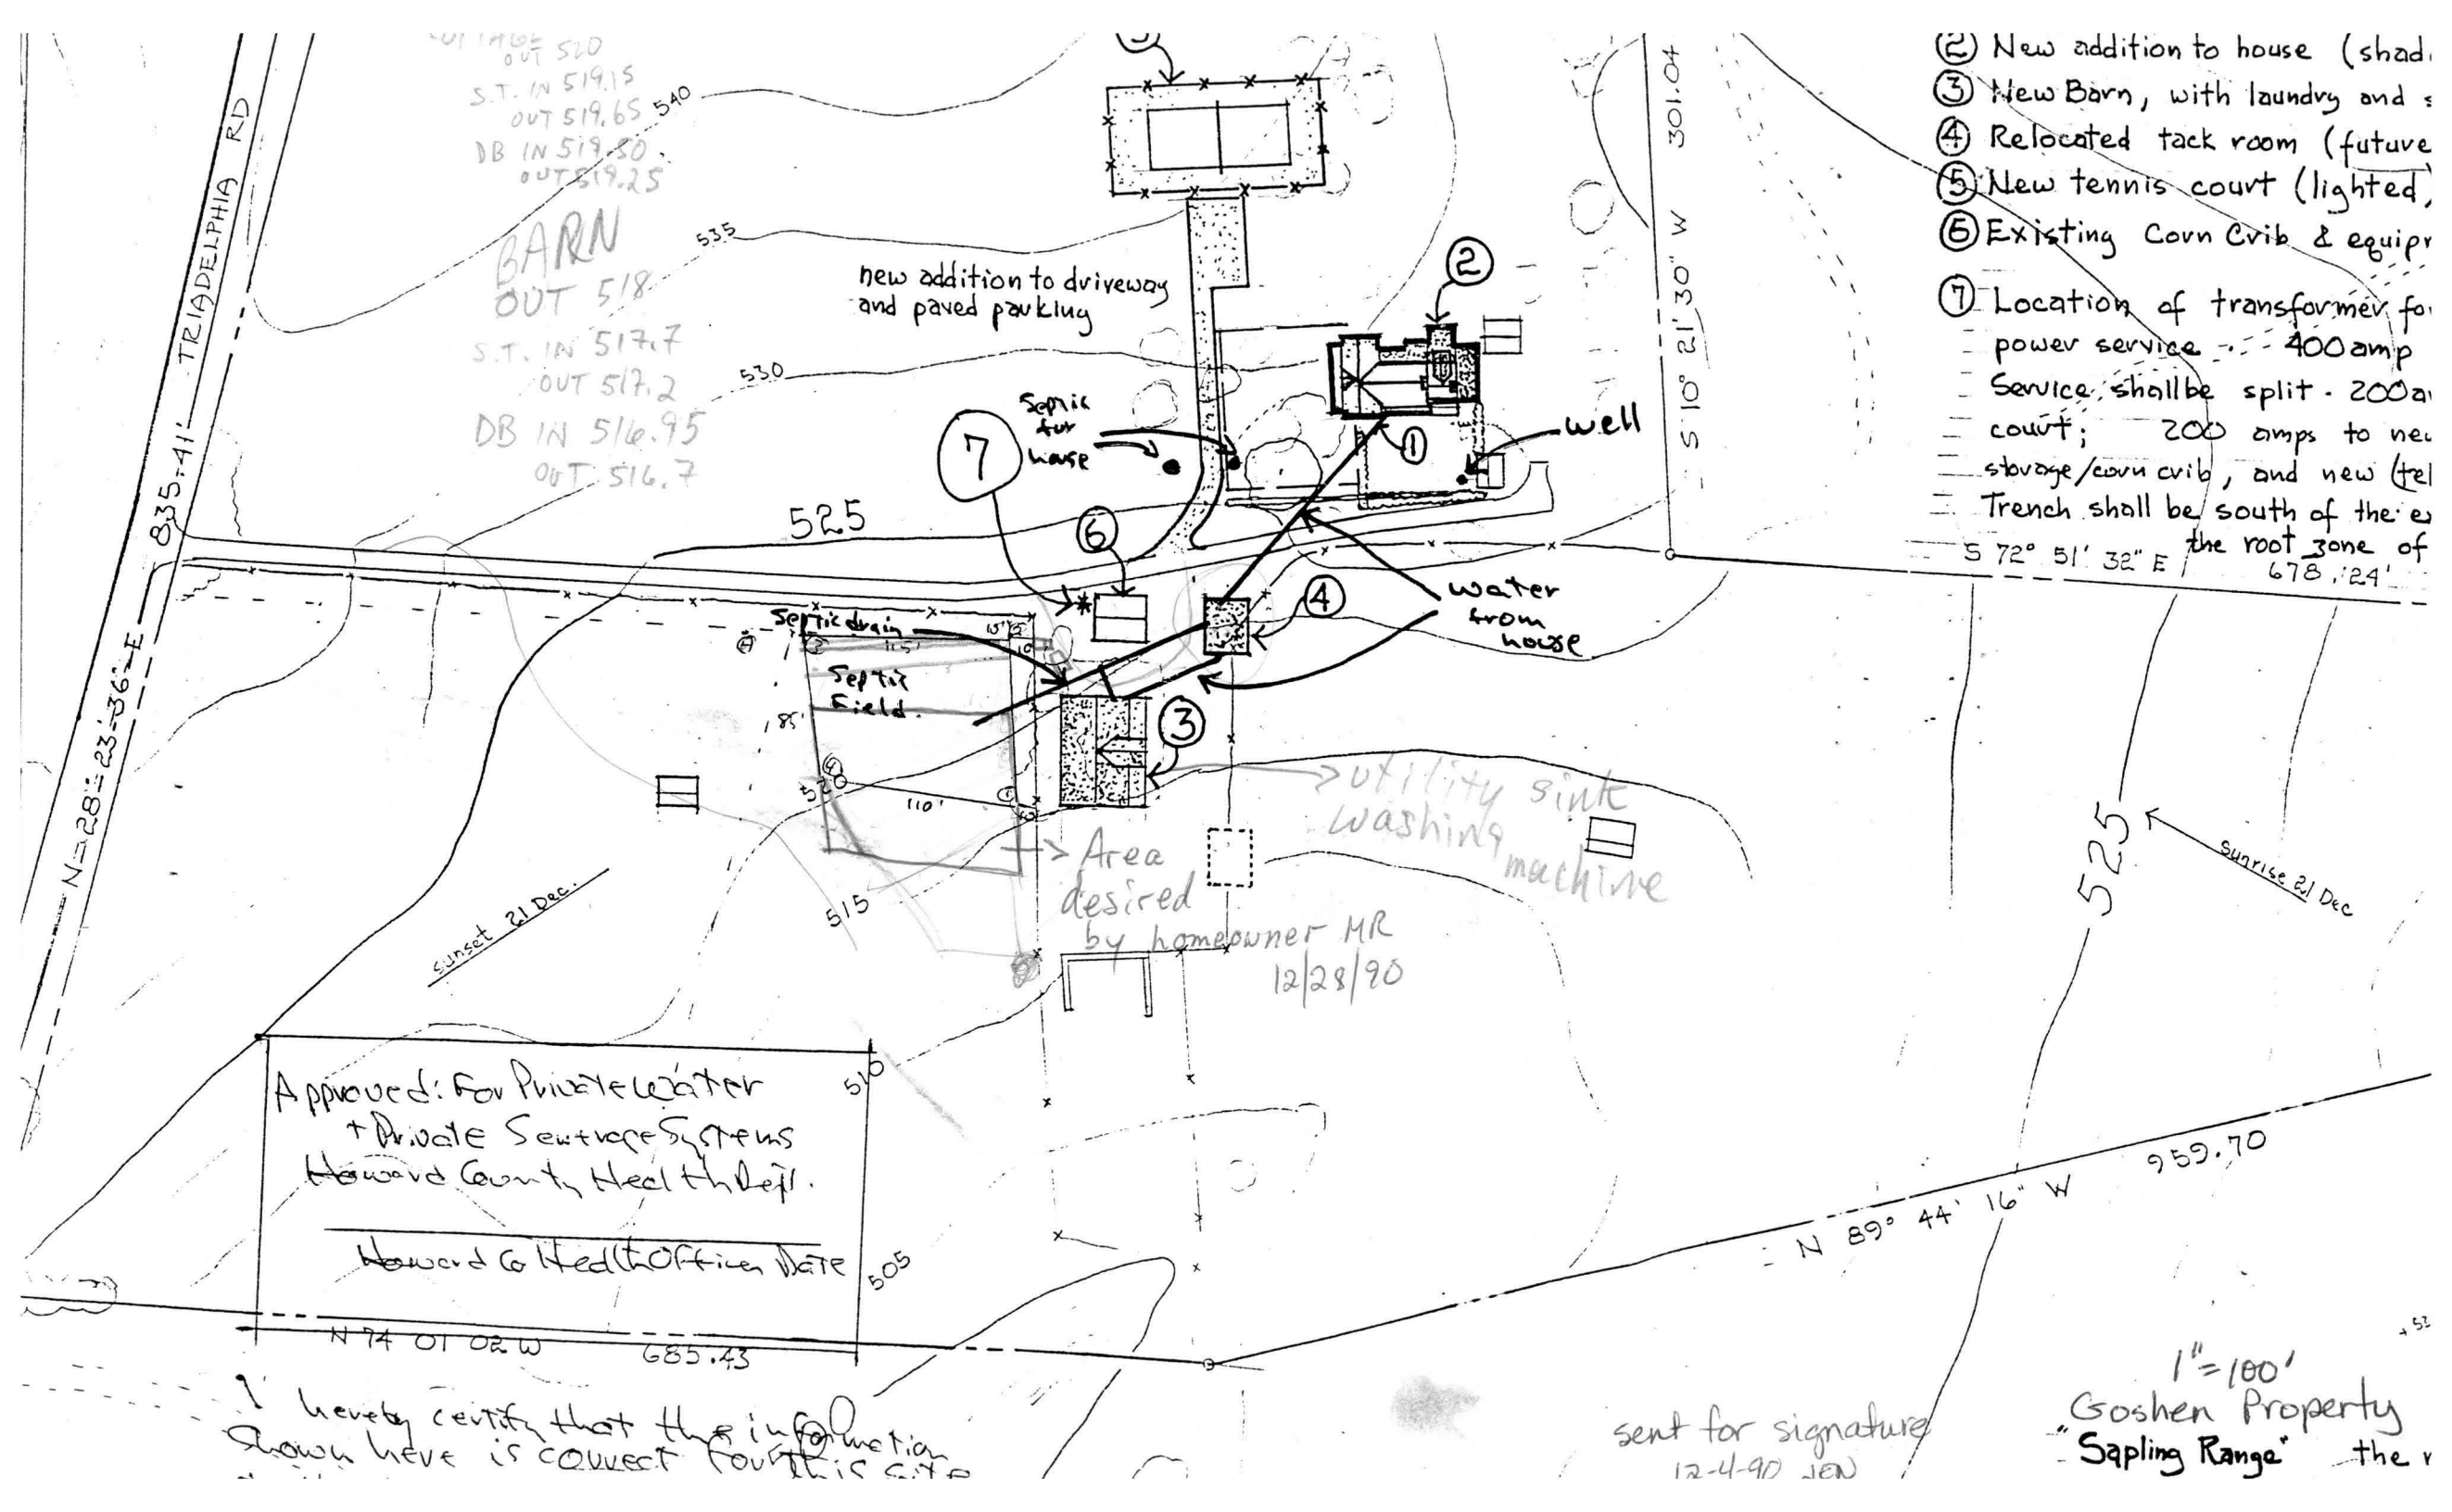

- ② New addition to house (shad.)
- ③ New Barn, with laundry and s
- ④ Relocated tack room (future)
- ⑤ New tennis court (lighted)
- ⑥ Existing Corn Crib & equipr
- ⑦ Location of transformer for power service - 400 amp
Service shall be split - 200a
count; 200 amps to new
storage/corn crib, and new tel
Trench shall be south of the e
the root zone of

Approved: For Private Water
+ Private Sewerage Systems
Howard County Health Dept.


Howard Co Health Officer Date

I hereby certify that the information
shown here is correct for this site

sent for signature
12-4-90 JEN

1"=100'
Goshen Property
"Sapling Range" the v

- ② New addition to house (shade)
- ③ New Barn, with laundry and s
- ④ Relocated tack room (future)
- ⑤ New tennis court (lighted)
- ⑥ Existing Corn Crib & equipn
- ⑦ Location of transformer for power service - 400 amp
Service shall be split - 200 amp
court; 200 amps to new
storage/corn crib, and new tel
Trench shall be south of the ex
the root zone of

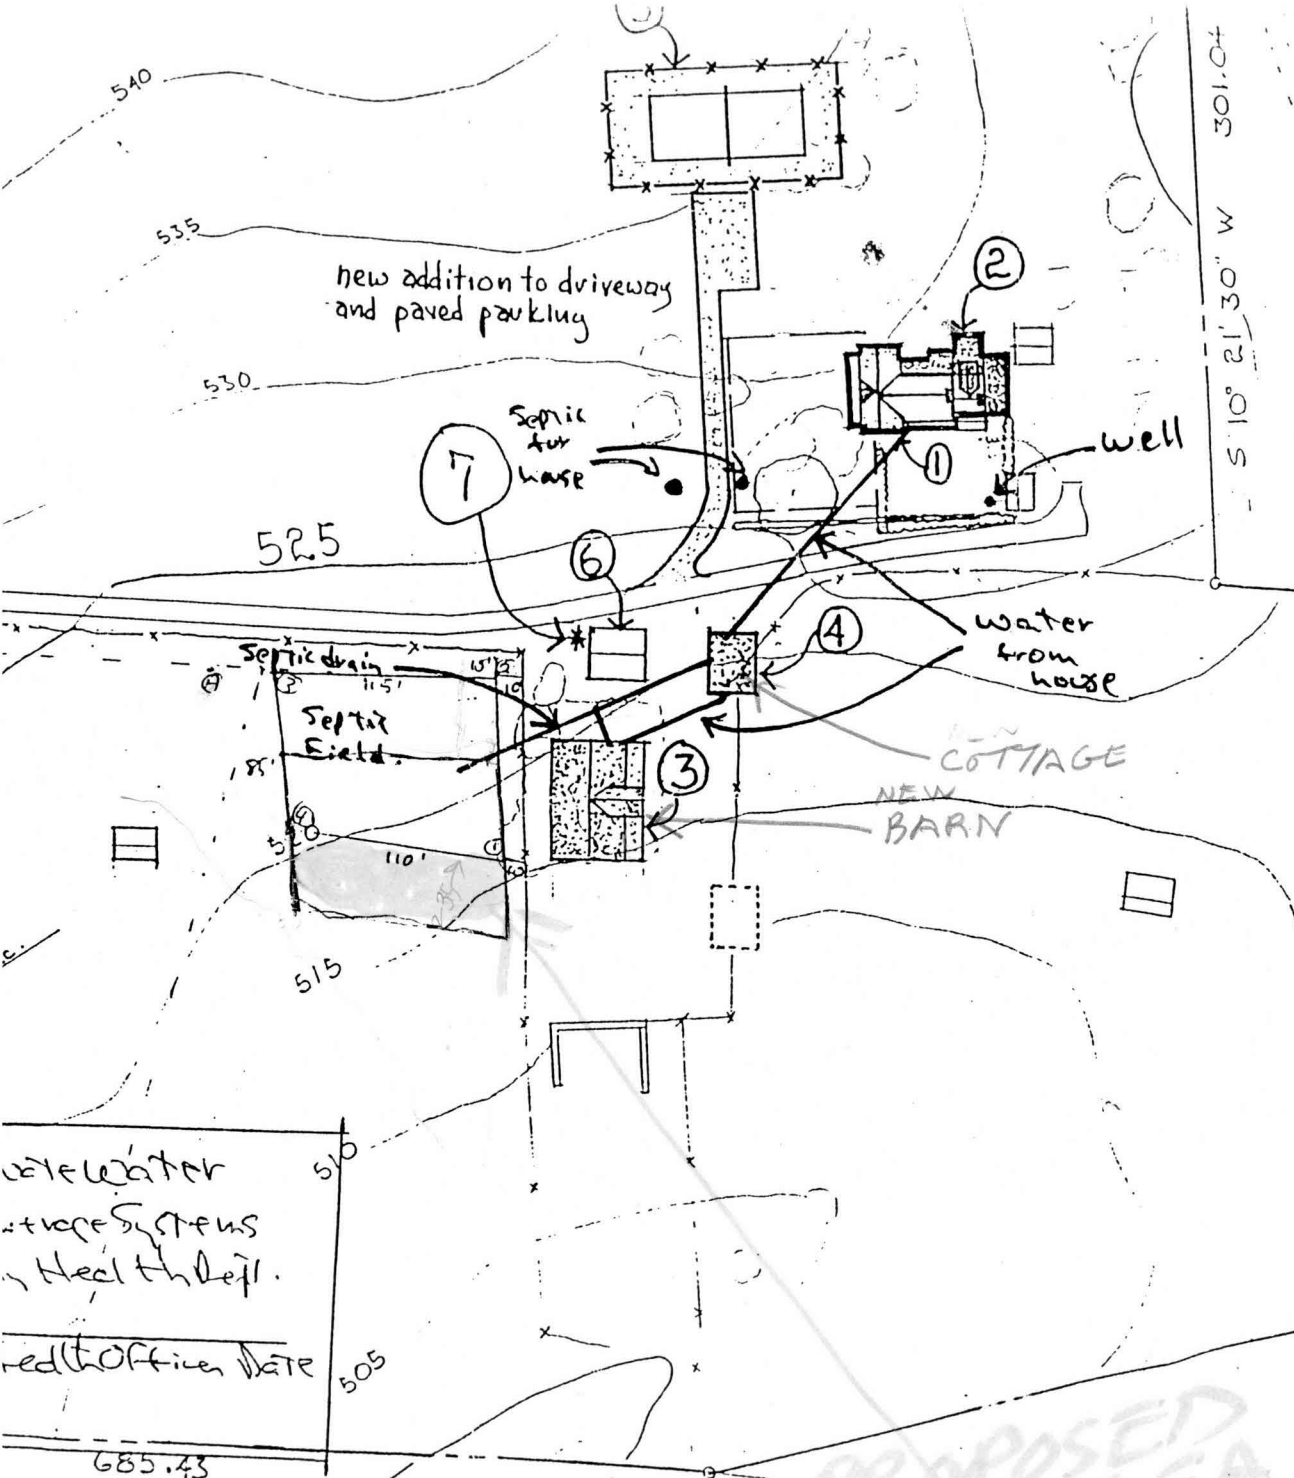

525
Sunrise 21 Dec

Bill Ingram
442-2139

water water
storage systems
in the field.

red (office) date

let the information
about the information

PROPOSED
NEW AREA

sent for signature

N 89° 44' 16" W 959.70

Bob Goshen
14831, Triadelphia Rd
1"=100'
Goshen Property
"Sapling Ranae" the r

GOSHEN. PROP-OWNER'S PREFERENCES

- 1- Combine Bork Barn & Cottage into one septic system. If this can be done can we move perk area down 40 FT.
- 2 - If two systems required can amount or size of trenches be reduced down to one trench? (100' long)

Jan. 10, 1991

B. A. O.

1/16/91. HOUSE REQUIRES SEPARATE 10,000 ~~GA~~ EASEMENT
AND SEPTIC SYSTEM.

BARN REQUIRES OWN EASEMENT & SYSTEM AS WELL.
IF STANDARD EASEMENT & SYSTEM IS
CONSIDERED NOT REASONABLE, DOWNSIZING CAN
BE CONSIDERED.

INSTALLER WILL HAVE OWNER ARRANGE
FOR MEETING IN OFFICE TO DISCUSS.

C. W. O.