

9/8/71

Final Approved
C.B.N.

PERMIT

SEWAGE DISPOSAL SYSTEM

MARYLAND STATE DEPARTMENT OF HEALTH

HOWARD COUNTY

INDEXED

ELLICOTT CITY

DISTRICT 5

DATE 7/28/71

P 16172

A 16100

Herman Sirk

IS PERMITTED TO INSTALL X ALTER

ADDRESS Annapolis Rock Road, Woodbine, Md.

PHONE HU 9-4724

A SEWAGE DISPOSAL SYSTEM LOCATED AT

SUBDIVISION ROAD 14831 Triadelphia LOT

PROPERTY OWNER Charles McFann Robert Goshen Rd.

ADDRESS

SPECIFICATIONS - 4 bedrooms

DRAIN FIELD DEPTH FEET, BOTTOM AREA SQ. FT.

SEEPAGE PITS ABSORBENT SIDE-WALL AREA SQ. FT.

SEPTIC TANK CAPACITY 1,250 GALLONS

FOR GARBAGE GRINDER, INCREASE DISPOSAL AREA 22% & TANK CAPACITY 50%.

OTHER Dry well - 400 sq. ft. effective area to begin 3 1/2 ft. below original
grade. Locate dry well 19 ft. from fence in front of house and 63 ft. from
edge of driveway.

NOTE: ALL PIPE FROM HOUSE TO SEPTIC TANK MUST BE CAST IRON.
PERMIT VOID AFTER THREE YEARS.

PLANS APPROVED BY D. W. Monaghan DATE 7/29/71

FILL SEPTIC TANK AND DISTRIBUTION BOX WITH WATER BEFORE CALLING FOR AN INSPECTION. COVER NO WORK UNTIL INSPECTED AND APPROVED.


NEITHER THE HOWARD COUNTY COMMISSIONERS NOR THE HEALTH DEPARTMENT IS RESPONSIBLE FOR THE SUCCESSFUL OPERATION OF ANY SYSTEM.

BLDG. PERMIT SIGNED

AND RETURNED

8/27/91
Serial # 39429
Addition - Katcher

A 16100

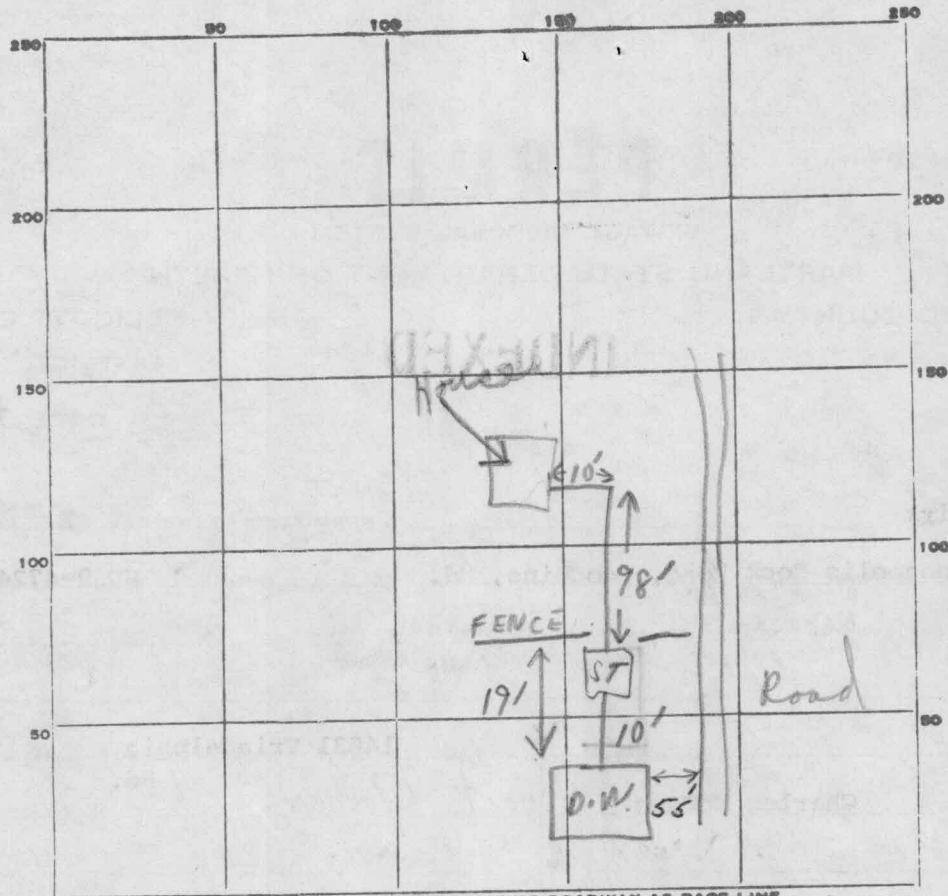

INDICATE NORTH. - NAME ADJOINING ROADWAY AS BASE LINE.

PERMIT CARD OK

SEPTIC TANK, LEVEL OK CLEANOUTS OK

DISTRIBUTION BOX, LEVEL NONE

TILE FIELD, DEPTH FT. TRENCH WIDTH FT.

GRAVEL DEPTH IN. TOTAL LENGTH FT.

NUMBER OF TRENCHES TOTAL BOTTOM AREA

SEEPAGE PITS, OUTSIDE PER. INSIDE DIAMETER 60 FT. DEPTH BELOW INLET 7 FT.

ABSORBENT AREA 420 SQ. FT.

REMARKS


DATE SYSTEM APPROVED 8 Sept. 1971 INSPECTOR C. J. Sheaffer

I WILL AGREE TO FILL IN HAND DUG WELL OR CONFIRM
THAT THIS HAS ALREADY OCCURED
(EX. SURFACE AESTHETIC FEATURES CAN REMAIN)

Shiff. 9/13/01


OK MR 9/13/01

1:50

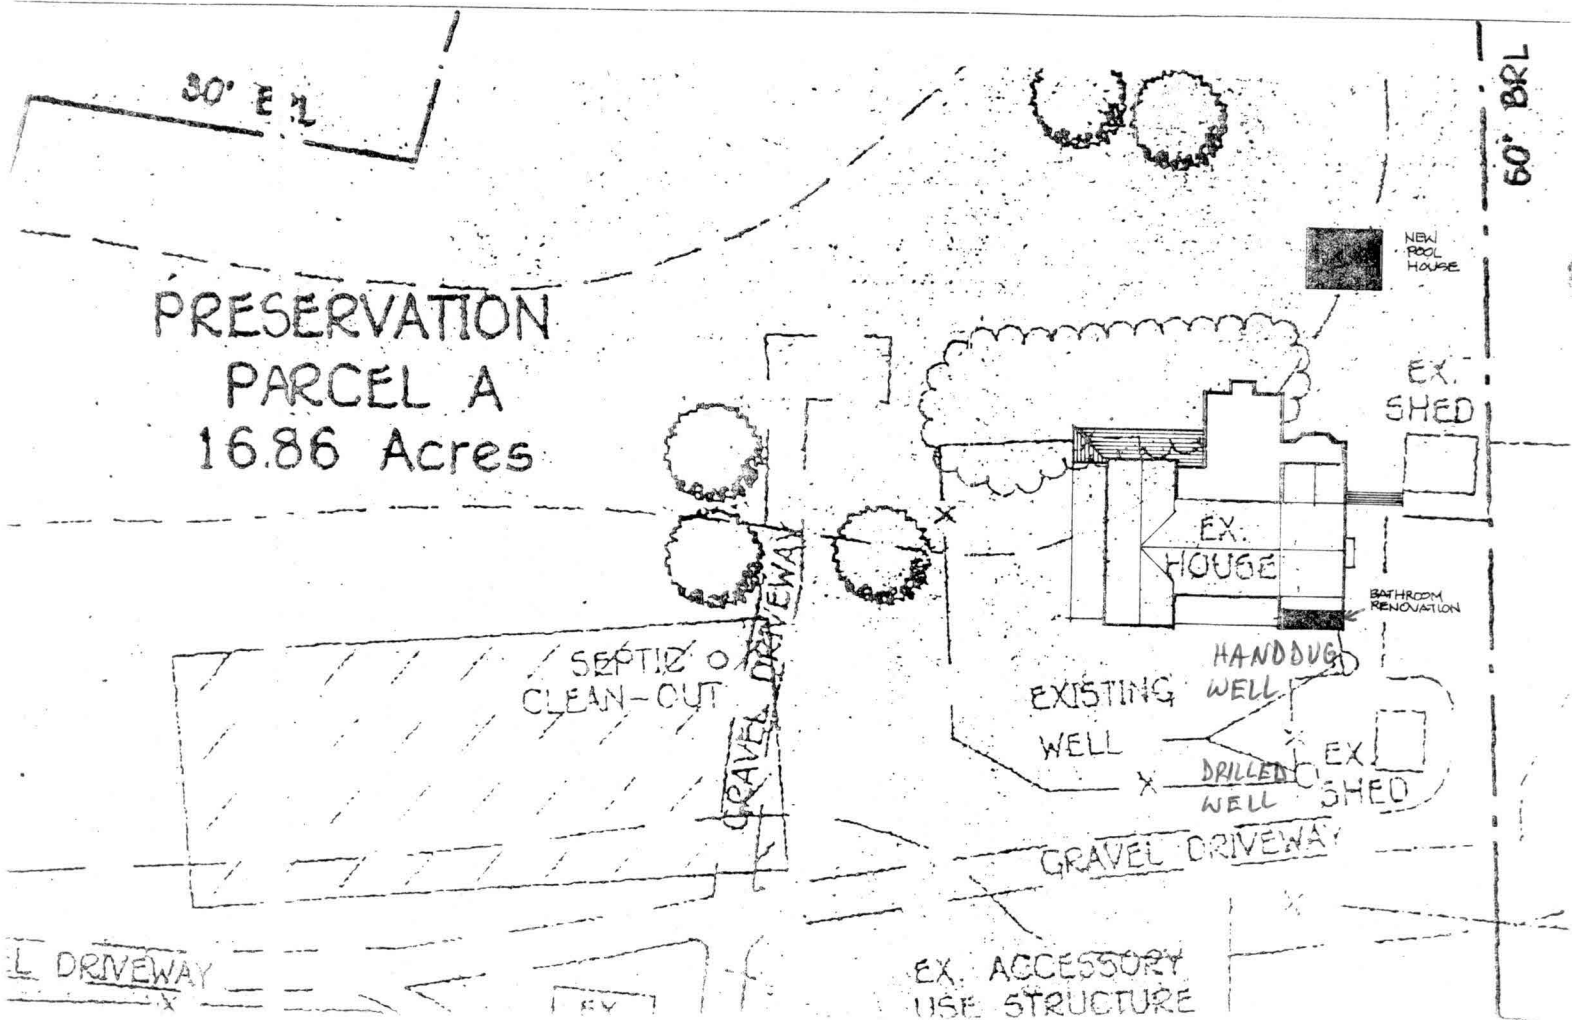

1/8" = 1'

ST
NEW
2x4
INCL.

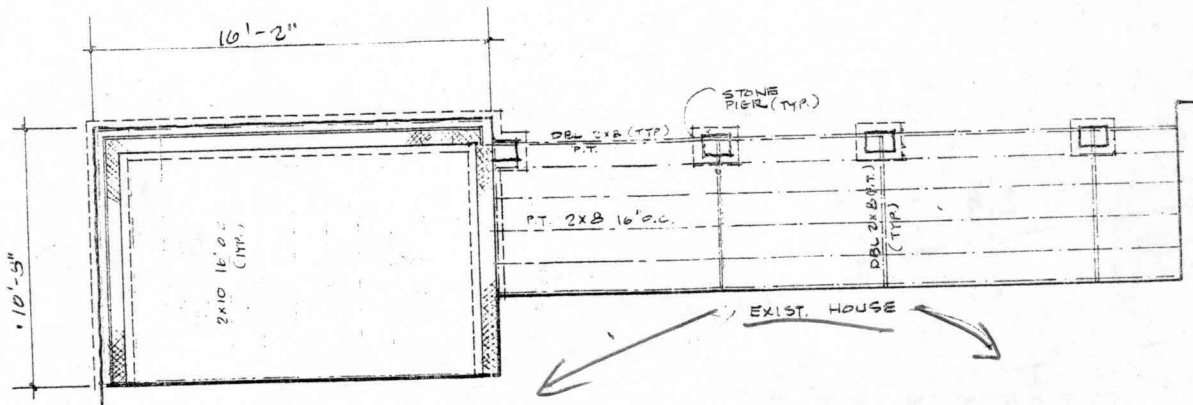

FOUNDATION PLAN

Office (703) 684-8225 FAX (703) 684-9235
1-866-684-8225 • rkteckim@aol.com

NEW
TYP.
WALL
VENUEER
(TYP.)

