

LAYOUT 3/24/08 INSP 4 \_\_\_\_\_  
INSP 2 3/26/08 INSP 5 \_\_\_\_\_  
INSP 3 3/21/08 INSP 6 \_\_\_\_\_

ISSUE DATE: \_\_\_\_\_

APPROVAL DATE: 4/2/08

# PERMIT

P 528435

A 520329

TAX ID # 05369118

**ON-SITE SEWAGE DISPOSAL SYSTEM  
HOWARD COUNTY HEALTH DEPARTMENT  
BUREAU OF ENVIRONMENTAL HEALTH**

Rylea Homes Inc IS PERMITTED TO INSTALL ☒ ALTER ☐

ADDRESS: P.O. Box 68, Glenwood MD 21738 PHONE NUMBER: \_\_\_\_\_

SUBDIVISION: \_\_\_\_\_ LOT NUMBER: \_\_\_\_\_

ADDRESS: 13551 Triadelphia Mill Rd PROPERTY OWNER: Rylea Homes

SEPTIC TANK CAPACITY (GALLONS): 2000 OUTLET BAFFLE FILTER REQUIRED ☐

PUMP CHAMBER CAPACITY (GALLONS): \_\_\_\_\_ COMPARTMENTED TANK REQUIRED ☒

NUMBER OF BEDROOMS: 5 *Trenches 2' Wide*

SQUARE FEET PER BEDROOM: \_\_\_\_\_ *Inlet 5'*

LINEAR FEET OF TRENCH REQUIRED: 194' or close To It *Bottom 9'*

TRENCHES:	Trench to be <u>3.0</u> feet wide. Inlet <u>3.5</u> feet below original grade. Bottom maximum depth <u>7.5</u> feet below original grade. Effective area begins at 5.5 feet below original grade. 4.0 feet of stone below distribution pipe.
LOCATION:	
NOTES:	

PLANS APPROVED: Ashley Trump DATE: 4/2/07

NOTE: PERMIT VOID AFTER 2 YEARS

NOTE: CONTRACTOR RESPONSIBLE FOR SCHEDULING A PRE-CONSTRUCTION INSPECTION FOR ALL INSTALLATIONS


NOTE: WATERTIGHT SEPTIC TANKS REQUIRED

NOTE: ALL PARTS OF SEPTIC SYSTEM SHALL BE 100 FEET FROM ANY WATER WELL

NOTE: MANHOLE RISERS REQUIRED ON ALL SEPTIC TANKS AND PUMP CHAMBERS UNLESS SPECIFICALLY AUTHORIZED

**NEITHER THE HOWARD COUNTY COUNCIL NOR THE HEALTH DEPARTMENT IS  
RESPONSIBLE FOR THE SUCCESSFUL OPERATION OF ANY SYSTEM  
PERMITTEE RESPONSIBLE FOR OBTAINING FINAL APPROVAL ON THIS PERMIT  
CALL 410-313-1771 FOR INSPECTION OF SEPTIC SYSTEM**


HO-94-3980

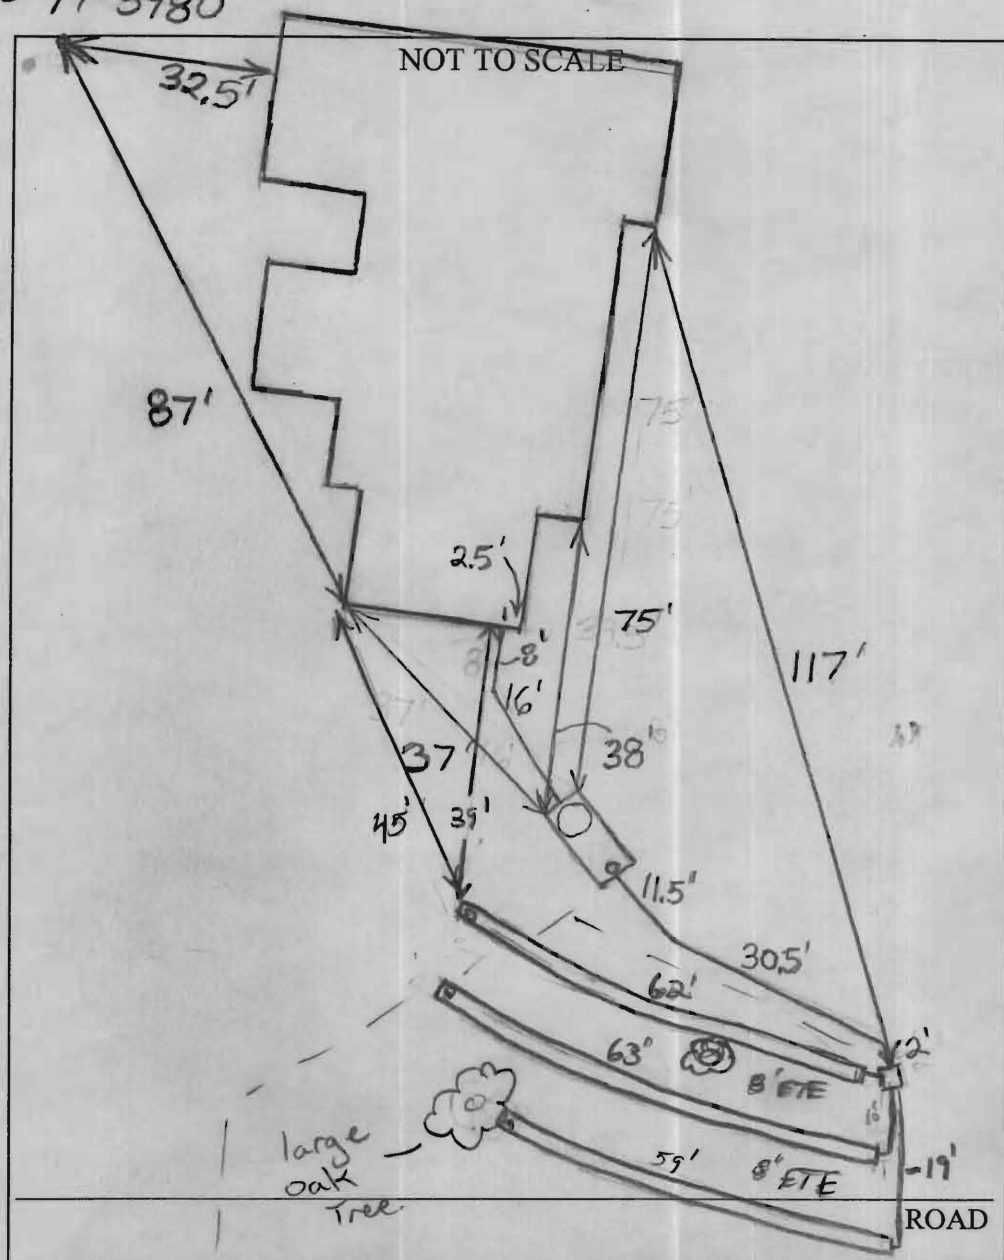

TRENCH/DRAINFIELD DATA		
WIDTH	INLET	BOTTOM
2'	3-4	9'
NUMBER OF TRENCHES		
3		
TOTAL LENGTH		
184'		
ABSORPTION AREA		
368' ± SW		
DISTRIBUTION BOX LEVEL		
level		
DISTRIBUTION BOX BAFFLE		
Yes		
DISTRIBUTION BOX PORT		
No		

SEPTIC TANK DATA	
SEPTIC TANK 1 LEVEL	Yes
CAPACITY	2000 GAL
SEAM LOC	Top
TANK LID DEPTH	0.5'-1.5'
BAFFLES	Rear, Front?
BAFFLE FILTER	No
MANHOLE LOC	Front
6" PORT LOC	Rear
WATERTIGHT TEST	No
SEPTIC TANK 2 LEVEL	N/A
CAPACITY	GAL
SEAM LOC	
TANK LID DEPTH	
BAFFLES	
BAFFLE FILTER	
MANHOLE LOC	
6" PORT LOC	
WATERTIGHT TEST	

PRE-CONSTRUCTION 3/24/08 Transit not on site. To place the distribution box near the top center of the field or  
 INSTALLATION near the upper right easement stake and install 185-195 feet of trench. O.K. to start trenches slightly above corner easement stakes to avoid trees. Changed trench specs. (BB) 3/26/08 Swale going through bottom part of easement. Tank set and plumbing to box finished. Still need to lay out exact location of trenches with transit. (BB) 3/31/08 Install 3x 63' trucks on contour running north. (KW) 4/2/08 Sys complete. OK to backfill  
 FINAL INSPECTOR J. de W. Way DATE OF APPROVAL 4/2/08 (15)

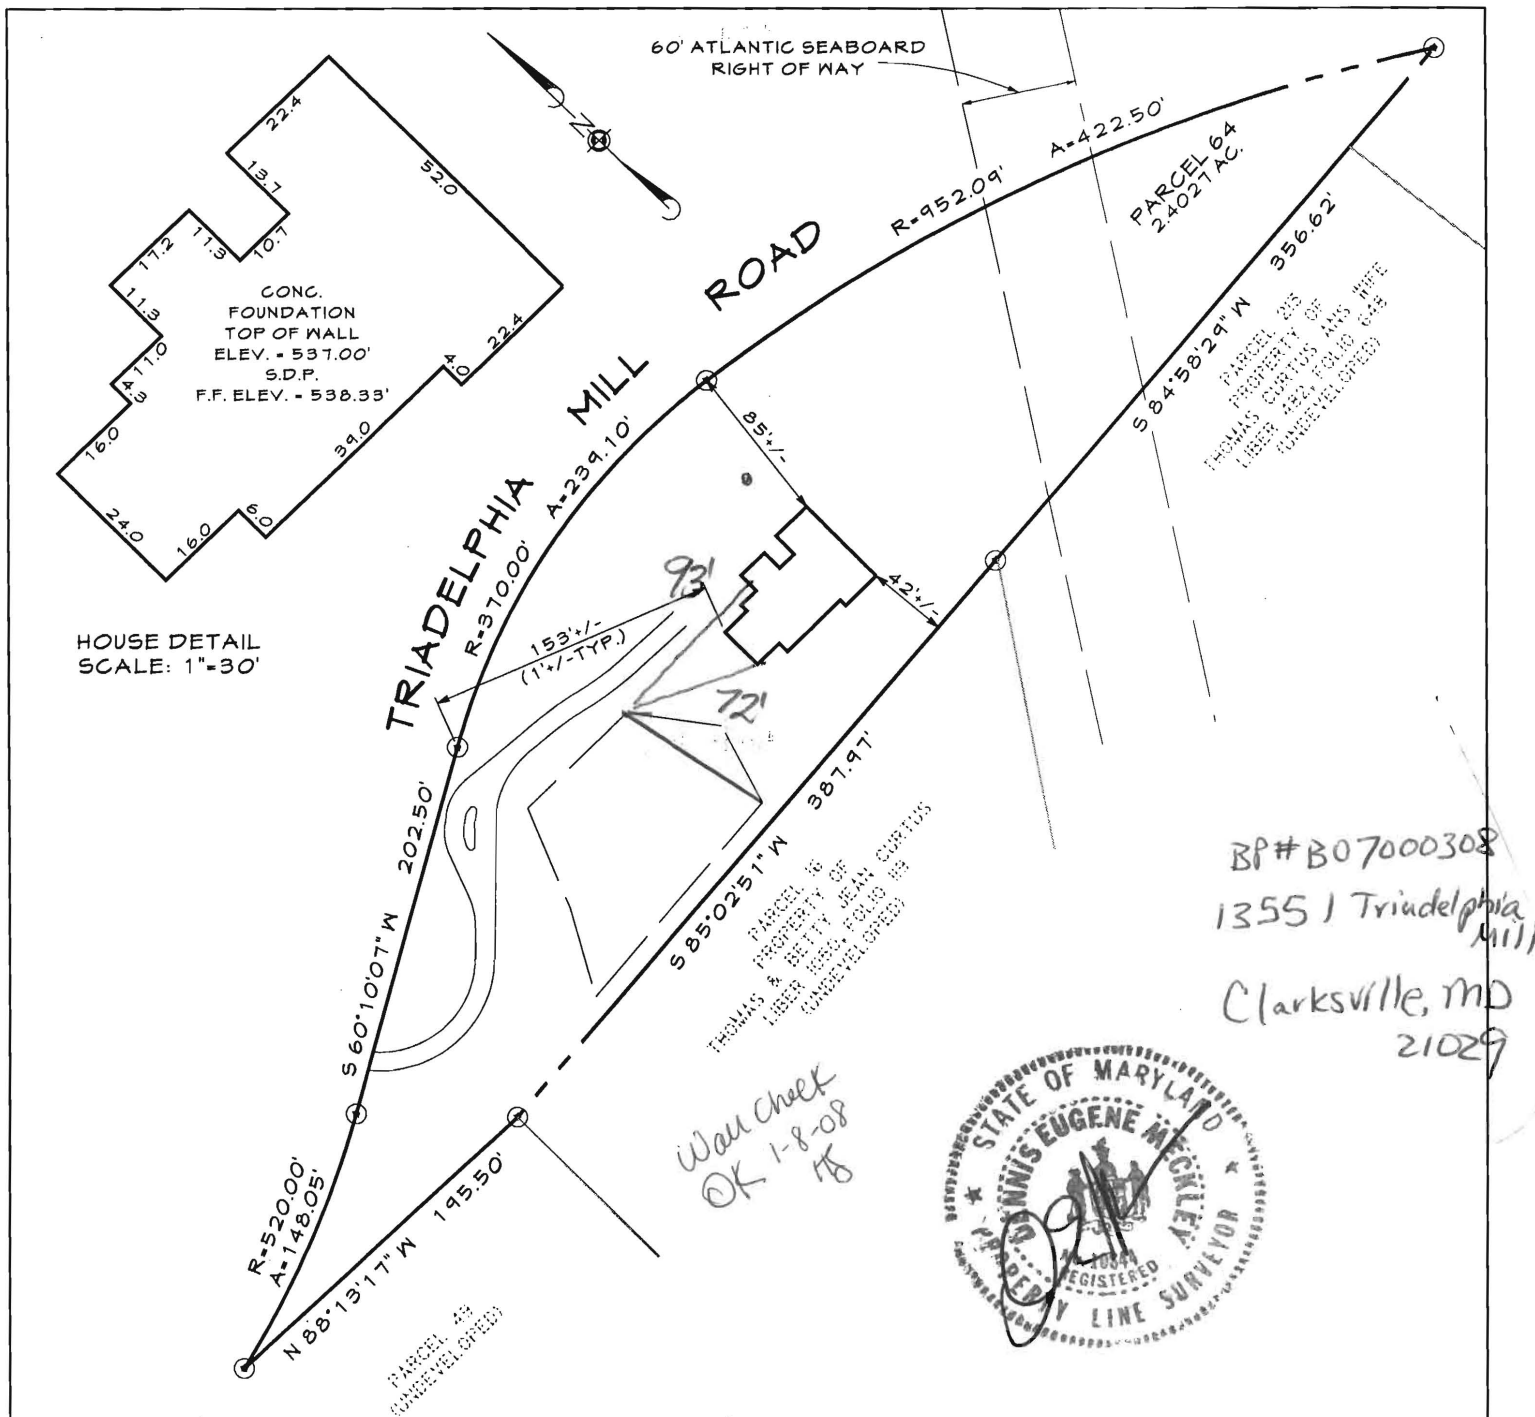

BP# B07000308  
1355 1 Triadelphia Mill Rd  
Clarksville, MD  
21029



# FOUNDATION CERTIFICATION FOR 1355 1 TRIADELPHIA MILL ROAD

5th ELECTION DISTRICT HOWARD COUNTY, MD.  
DEED REF.: 8683/074.

A licensed Maryland Surveyor either personally prepared this Foundation Certification, or was in responsible charge over its preparation and the surveying work reflected in it, in compliance with the Maryland Minimum Standards of Practice for Land Surveyors.

I hereby certify that I have surveyed the property shown hereon for the sole purpose of locating the improvements. This plan is a benefit to the consumer only in so far as it is required by a lender or a title insurance company or its agent in connection with contemplated transfer, financing or refinancing. It is not to be relied upon for the establishment of boundary, easement or right-of-way lines for any reason, such as the location of fences, garages, buildings, or other existing or future improvements.

By Dennis E. Meckley Date 11/14/07  
Dennis E. Meckley Property Line Surveyor No. 10844



FREDERICK OFFICE:  
8445 Progress Drive, Suite 88  
Frederick, MD 21701-4879  
(301) 662-1799  
FAX (301) 662-8004

WESTMINSTER OFFICE:  
439 East Main Street  
Westminster, MD 21157-5539  
(410) 848-1790  
FAX (410) 848-1791

DRAWN BY:	GDD
DESIGN BY:	
REVIEW BY:	DEM
DATE:	11-13-07
SCALE:	1"=100'
JOB NO:	2004156
SHEET:	1 OF 1