

12/29/80  
as soon as possible  
10/24/80  
a.m. please

5 stages  
P 30981  
A 29064

# PERMIT

SEWAGE DISPOSAL SYSTEM

MARYLAND STATE DEPARTMENT OF HEALTH

HOWARD COUNTY

INDEXED

ELLICOTT CITY

DISTRICT 5th.

DATE 10/7/80

Jack Pyock, Jr.

IS PERMITTED TO INSTALL X ALTER

ADDRESS

PHONE 988-9270

SUBDIVISION Triadelphia Mill Farms

ROAD 1401<sup>1/2</sup> Triadelphia Mill LOT 17

PROPERTY OWNER Wilson Development

- GLENNON

ADDRESS

SPECIFICATIONS 3 Bedrooms

SEPTIC TANK CAPACITY 1000 GALLONS

DRAIN FIELD \_\_\_\_\_ DEPTH \_\_\_\_\_ FEET, BOTTOM AREA \_\_\_\_\_ SQ. FT.

DEEP TRENCH \_\_\_\_\_ DEPTH \_\_\_\_\_ FEET, BOTTOM AREA \_\_\_\_\_ SQ. FT.

Dry Well

SEEPAGE PITS X ABSORBENT SIDE-WALL AREA 187 SQ. FT. per bedroom

INLET PIPE 3<sup>1/4</sup> FT. BELOW ORIGINAL GRADE. MAXIMUM DEPTH 9<sup>1/2</sup> FT. BELOW ORIGINAL GRADE

EFFECTIVE DEPTH AT 3 FT. BELOW ORIGINAL GRADE.

O.K. FIS. 10/7/80

LOCATE DISPOSAL AREA \_\_\_\_\_ FT. FROM \_\_\_\_\_ LOT LINE AND \_\_\_\_\_ FT. FROM \_\_\_\_\_ LOT LINE AS SEEN WHEN

FACING LOT FROM

Location of the dry well is 145 feet from the right lot line and 195 feet (down right lot line) from the right front corner point of lot as seen when facing the lot from Triadelphia Mill Road. If trench used with dry well - need (1) 5 ft. earth buffer between trench and dry well. (2) 2 inspections of trench, before and after stone in. (3) Run trench on contour.

PLANS APPROVED BY C. B. Streaker DATE 12/14/79

COVER NO WORK UNTIL INSPECTED AND APPROVED.

NEITHER THE HOWARD COUNTY COUNCIL NOR THE HEALTH DEPARTMENT IS RESPONSIBLE FOR THE SUCCESSFUL OPERATION OF ANY SYSTEM.

NOTE: IF TRENCH IS USED CALL FOR INSPECTION BEFORE PLACING GRAVEL IN TRENCH.

NOTE: NO DRY WELL SHALL EXCEED 15 FOOT IN DIAMETER.

NOTE: ALL PIPE FROM HOUSE TO DISPOSAL AREA MUST BE CAST IRON.

PERMIT VOID AFTER THREE YEARS.

NOTE: INSTALL STAND PIPE ON SEPTIC TANK AND DRY WELL. STAND PIPES MUST BE 6 INCHES IN DIAMETER. CAST IRON, CONCRETE OR TERRA COTTA ACCEPTED.


**\*INSTALLER IS RESPONSIBLE FOR OBTAINING FINAL APPROVAL ON THIS PERMIT.**

A 29064

187  
3  
561

44  
6.5  
220  
264  
286.0  
292  
578

45  
6.5  
225  
270  
292

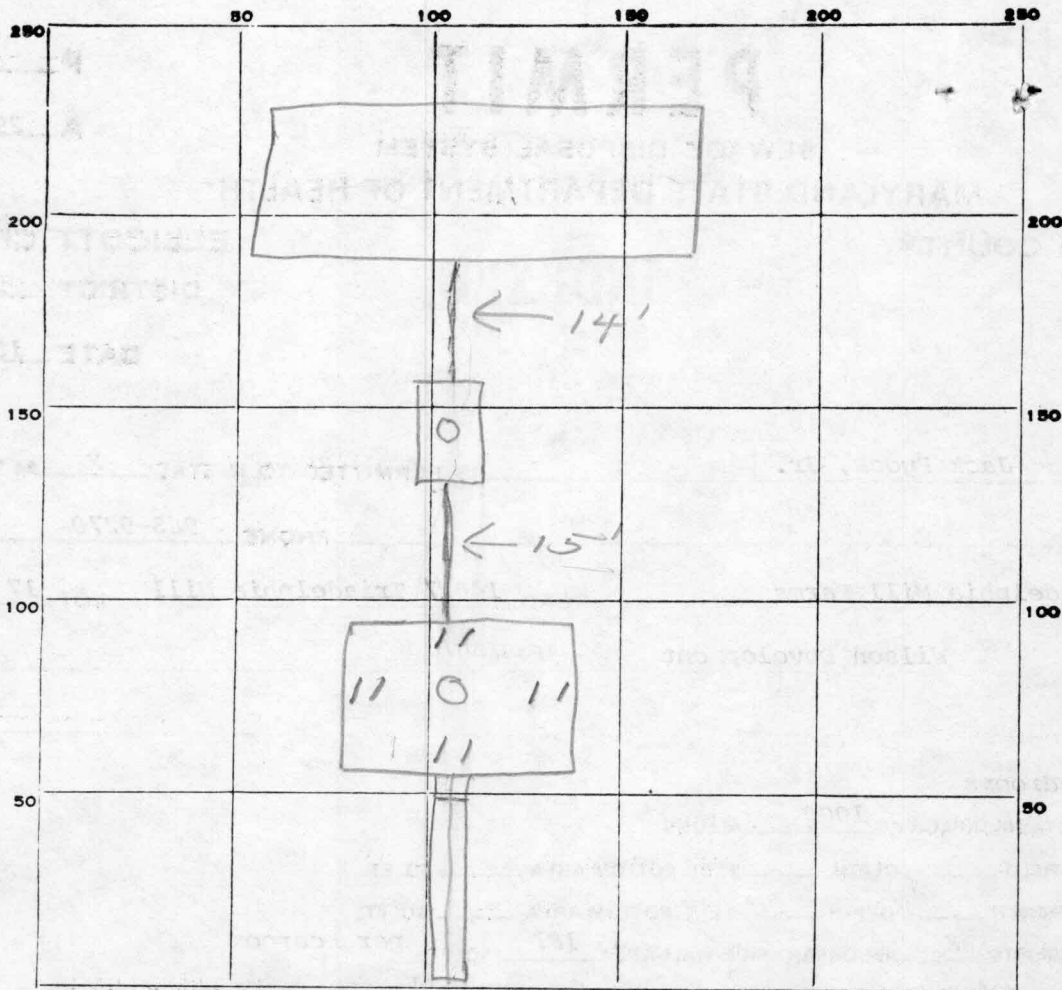

PERMIT CARD

SEPTIC TANK, LEVEL

CLEANOUTS

DISTRIBUTION BOX, LEVEL

TILE FIELD, DEPTH 9 1/2 FT. TRENCH WIDTH 2 FT.

GRAVEL DEPTH 6 1/2 IN. TOTAL LENGTH 45 FT.

NUMBER OF TRENCHES 1 TOTAL BOTTOM AREA 292

SEEPAGE PITS, INSIDE DIAMETER 44 FT. DEPTH BELOW INLET 7 FT.

ABSORBENT AREA 600 SQ. FT.

REMARKS 10/23/80 OK to add gravel in trench. JS  
10/24/80 OK to cover all work. JS + SK

DATE SYSTEM APPROVED 10/24/80

INSPECTOR

5/2/80