

ISSUE DATE:

9/21/07

APPROVAL DATE:

9/21/07

PERMIT

P 516040

A REPAIR

INDEXED

ON-SITE SEWAGE DISPOSAL SYSTEM HOWARD COUNTY HEALTH DEPARTMENT BUREAU OF ENVIRONMENTAL HEALTH

05-388619

Jenkins Brothers

IS PERMITTED TO INSTALL ☐ ALTER ☒

ADDRESS: 7670 Smith's Private Road

PHONE NUMBER: 410-461-9282

SUBDIVISION: Triadelphia Mill Farms

LOT NUMBER: 17

ADDRESS: 14014 Triadelphia Mill Road

PROPERTY OWNER: Glennon

SEPTIC TANK CAPACITY (GALLONS):

PUMP CHAMBER CAPACITY (GALLONS):

N/A

NUMBER OF BEDROOMS:

3

SQUARE FEET PER BEDROOM:

180

LINEAR FEET OF TRENCH REQUIRED:

90

TRENCHES:	Trench to be 2 feet wide. Inlet 5 feet below original grade. Bottom maximum depth 11 feet below original grade. Effective area begins at 5 feet below original grade. 6 feet of stone below distribution pipe.
LOCATION:	
PURPOSE:	Existing septic system has failed. Call for inspection when ground is opened so sanitarian can recommend repair.

PLANS APPROVED:

DATE:

NOTE: PERMIT VOID AFTER 2 YEARS

NOTE: CONTRACTOR RESPONSIBLE FOR SCHEDULING A PRE-CONSTRUCTION INSPECTION FOR ALL INSTALLATIONS

NOTE: WATERTIGHT SEPTIC TANKS REQUIRED


NOTE: ALL PARTS OF SEPTIC SYSTEM SHALL BE 100 FEET FROM ANY WATER WELL

NOTE: MANHOLE RISERS REQUIRED ON ALL SEPTIC TANKS AND PUMP CHAMBERS

**NEITHER THE HOWARD COUNTY COUNCIL NOR THE HEALTH DEPARTMENT IS
RESPONSIBLE FOR THE SUCCESSFUL OPERATION OF ANY SYSTEM
PERMITTEE RESPONSIBLE FOR OBTAINING FINAL APPROVAL ON THIS PERMIT
CALL 410-313-2640 FOR INSPECTION OF SEPTIC SYSTEM**

P 516040

NOT TO SCALE

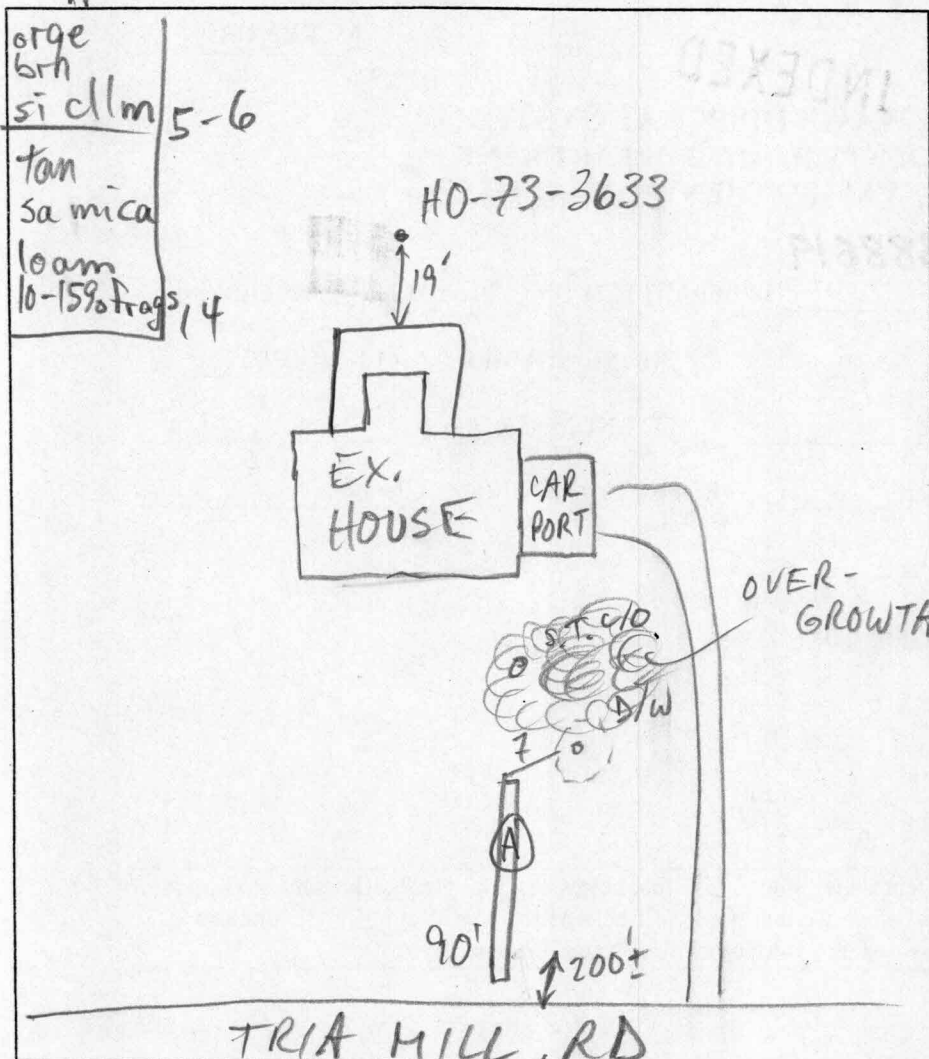

TRENCH DATA

TRENCH WIDTH 2

TRENCH INLET DEPTH 5

TRENCH BOTTOM DEPTH 11

DEPTH OF STONE 6

NUMBER OF TRENCHES 1

TOTAL TRENCH LENGTH 90

ABSORBENT AREA 540

DISTRIBUTION BOX LEVEL —

BAFFLE IN DISTRIBUTION BOX —

SEPTIC TANK DATA

SEPTIC TANK EX. GALLONS

MANHOLE RISER —

6 INCH INSPECTION PORT ✓

PUMP CHAMBER DATA

PUMP CHAMBER GALLONS —

MANHOLE RISER —

ALARM —

PUMP PERFORMANCE TEST —

PRE-CONSTRUCTION INSPECTION:

9/21/01 AM OK TO START (MR)

INSPECTION COMMENTS:

9/21/01 PM OK TO COVER (MR)

INSPECTOR

M. Rifkin

DATE SYSTEM APPROVED

9/21/01