

4-12' Lobs
corners on
edges of
10,000 #

APPLICATION

A 17091

P _____

SEWAGE DISPOSAL TESTING

MARYLAND STATE DEPARTMENT OF HEALTH

HOWARD COUNTY

ELLICOTT CITY

DISTRICT 5th

DATE 5/30/72

TO: THE COUNTY HEALTH OFFICER
ELLICOTT CITY, MARYLAND

I, HEREBY, APPLY FOR THE NECESSARY TESTS IN ORDER TO CONSTRUCT (OR RECONSTRUCT) A SEWAGE DISPOSAL SYSTEM.

PROPERTY OWNER Kenneth L. Purcell

ADDRESS 2102 Dexter Avenue, Silver Spring, Maryland PHONE 681-6056

PROPERTY LOCATION:

SUBDIVISION Russell Coleman & Donald G. Lerch, Jr. LOT NO. 2 (Two)

ROAD AND DESCRIPTION Triadelphia Mill Road with 25foot access - 5.6-A M/L

OCCUPANT Unimproved PHONE --

PERSON TO CONSTRUCT SYSTEM To be determined

ADDRESS _____ PHONE _____

SIZE OF LOT 5.6 5.6 acres M/L TYPE BLDG. four (4)
NUMBER OF BEDROOMS

IF NOT SINGLE RESIDENCE DESCRIBE _____

SIGNATURE OF APPLICANT Kenneth L. Purcell

APPROVED BY _____ FOR _____ DATE _____
(KIND OF SYSTEM)

REJECTED BY _____ FOR _____ DATE _____
(KIND OF SYSTEM)

HOLD PENDING FURTHER TESTS _____ DATE _____

REASONS FOR REJECTION OR HOLDING _____

THIS IS NOT A PERMIT

A 44530

SOIL PROFILE

INDICATE NORTH - NAME ADJOINING ROADWAY AS BASE LINE.


DATE	TEST NO.	DEPTH	PRE-WET		TEST - 1" DROP		TIME
			START	STOP	START	STOP	
MS	7 V	10	5 min	1	MOTTLES AT 5'	6' FAIL	
	3 V	8 1/2	WATER AT 7'		MOTTLES AT 4'	FAIL	
	8 V	9	WATER AT 8'		MOTTLES AT 3'	FAIL	

REMARKS _____

TYPE OF SOIL _____

TESTED BY _____ ALSO PRESENT _____

A17457

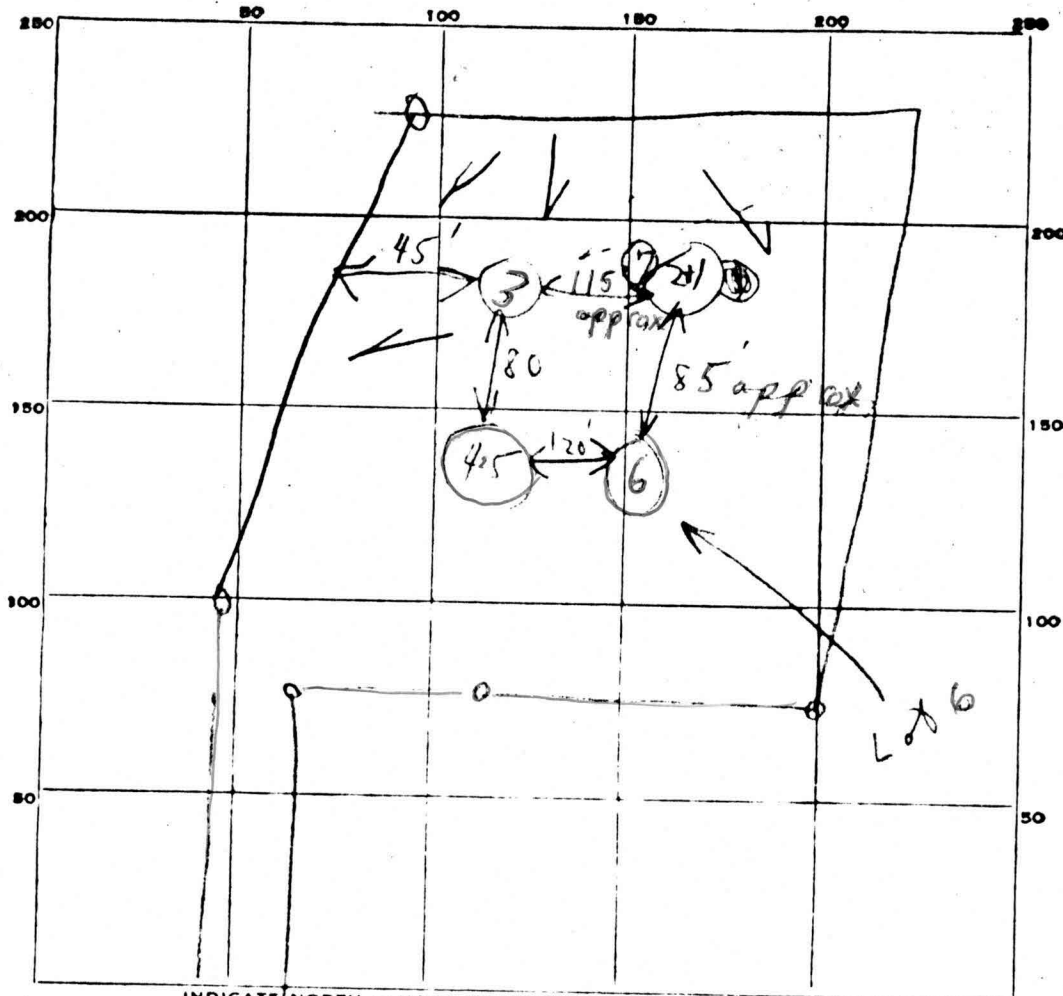

INDICATE NORTH. - NAME ADJOINING ROADWAY AS BASE LINE.

Trudolph Rd

DATE	TEST NO.	DEPTH	PRE-WET		TEST - 1" DROP		TIME
			START	STOP	START	STOP	
1/18/73	⊗ 1	3'	207	2:25	2:25	Pulled Key	
High	2	10 1/2'	155	158	158	2:10	12 min
	3	10' sandy soil					
	4	5 1/2'	215	2:18	2:18	2:28	10 min
Clay 5'	5	11'	216	2:25	2:25	2:38	13 min
	6	10 1/2' visual				Wood stuff 3 1/2'	
	⊗ 7	4'	245	250	250	308	18 min

SOIL AUGER FINDING

TESTED BY

B. Sheeter

REMARKS

APPLICATION

SEWAGE DISPOSAL TESTING

MARYLAND STATE DEPARTMENT OF HEALTH

HOWARD COUNTY

ELLICOTT CITY

DISTRICT 5th

DATE 5/30/72

TO: THE COUNTY HEALTH OFFICER
ELLICOTT CITY, MARYLAND

I, HEREBY, APPLY FOR THE NECESSARY TESTS IN ORDER TO CONSTRUCT (OR RECONSTRUCT) A SEWAGE DISPOSAL SYSTEM.

PROPERTY OWNER Kenneth L. Purcell

ADDRESS 2102 Dexter Avenue, Silver Spring, Maryland PHONE 681-6056

PROPERTY LOCATION:

SUBDIVISION Russell Coleman & Donald G. Lerch, Jr. LOT NO. 2 (Two)

ROAD AND DESCRIPTION Triadelphia Mill Road with 25foot access - 5.6-A M/L

OCCUPANT Unimproved PHONE - -

PERSON TO CONSTRUCT SYSTEM To be determined

ADDRESS _____ PHONE _____

SIZE OF LOT 5/6 5.6 acres M/L TYPE BLDG. four (4)

NUMBER OF BEDROOMS

IF NOT SINGLE RESIDENCE DESCRIBE _____

SIGNATURE OF APPLICANT Kenneth L. Purcell

APPROVED BY _____ FOR _____ DATE _____
(KIND OF SYSTEM)

REJECTED BY _____ FOR _____ DATE _____
(KIND OF SYSTEM)

HOLD PENDING FURTHER TESTS _____ DATE _____

REASONS FOR REJECTION OR HOLDING _____


THIS IS NOT A PERMIT


lst 2

SOIL AUGER FINDING _____

TESTED BY R. Tane _____


REMARKS _____

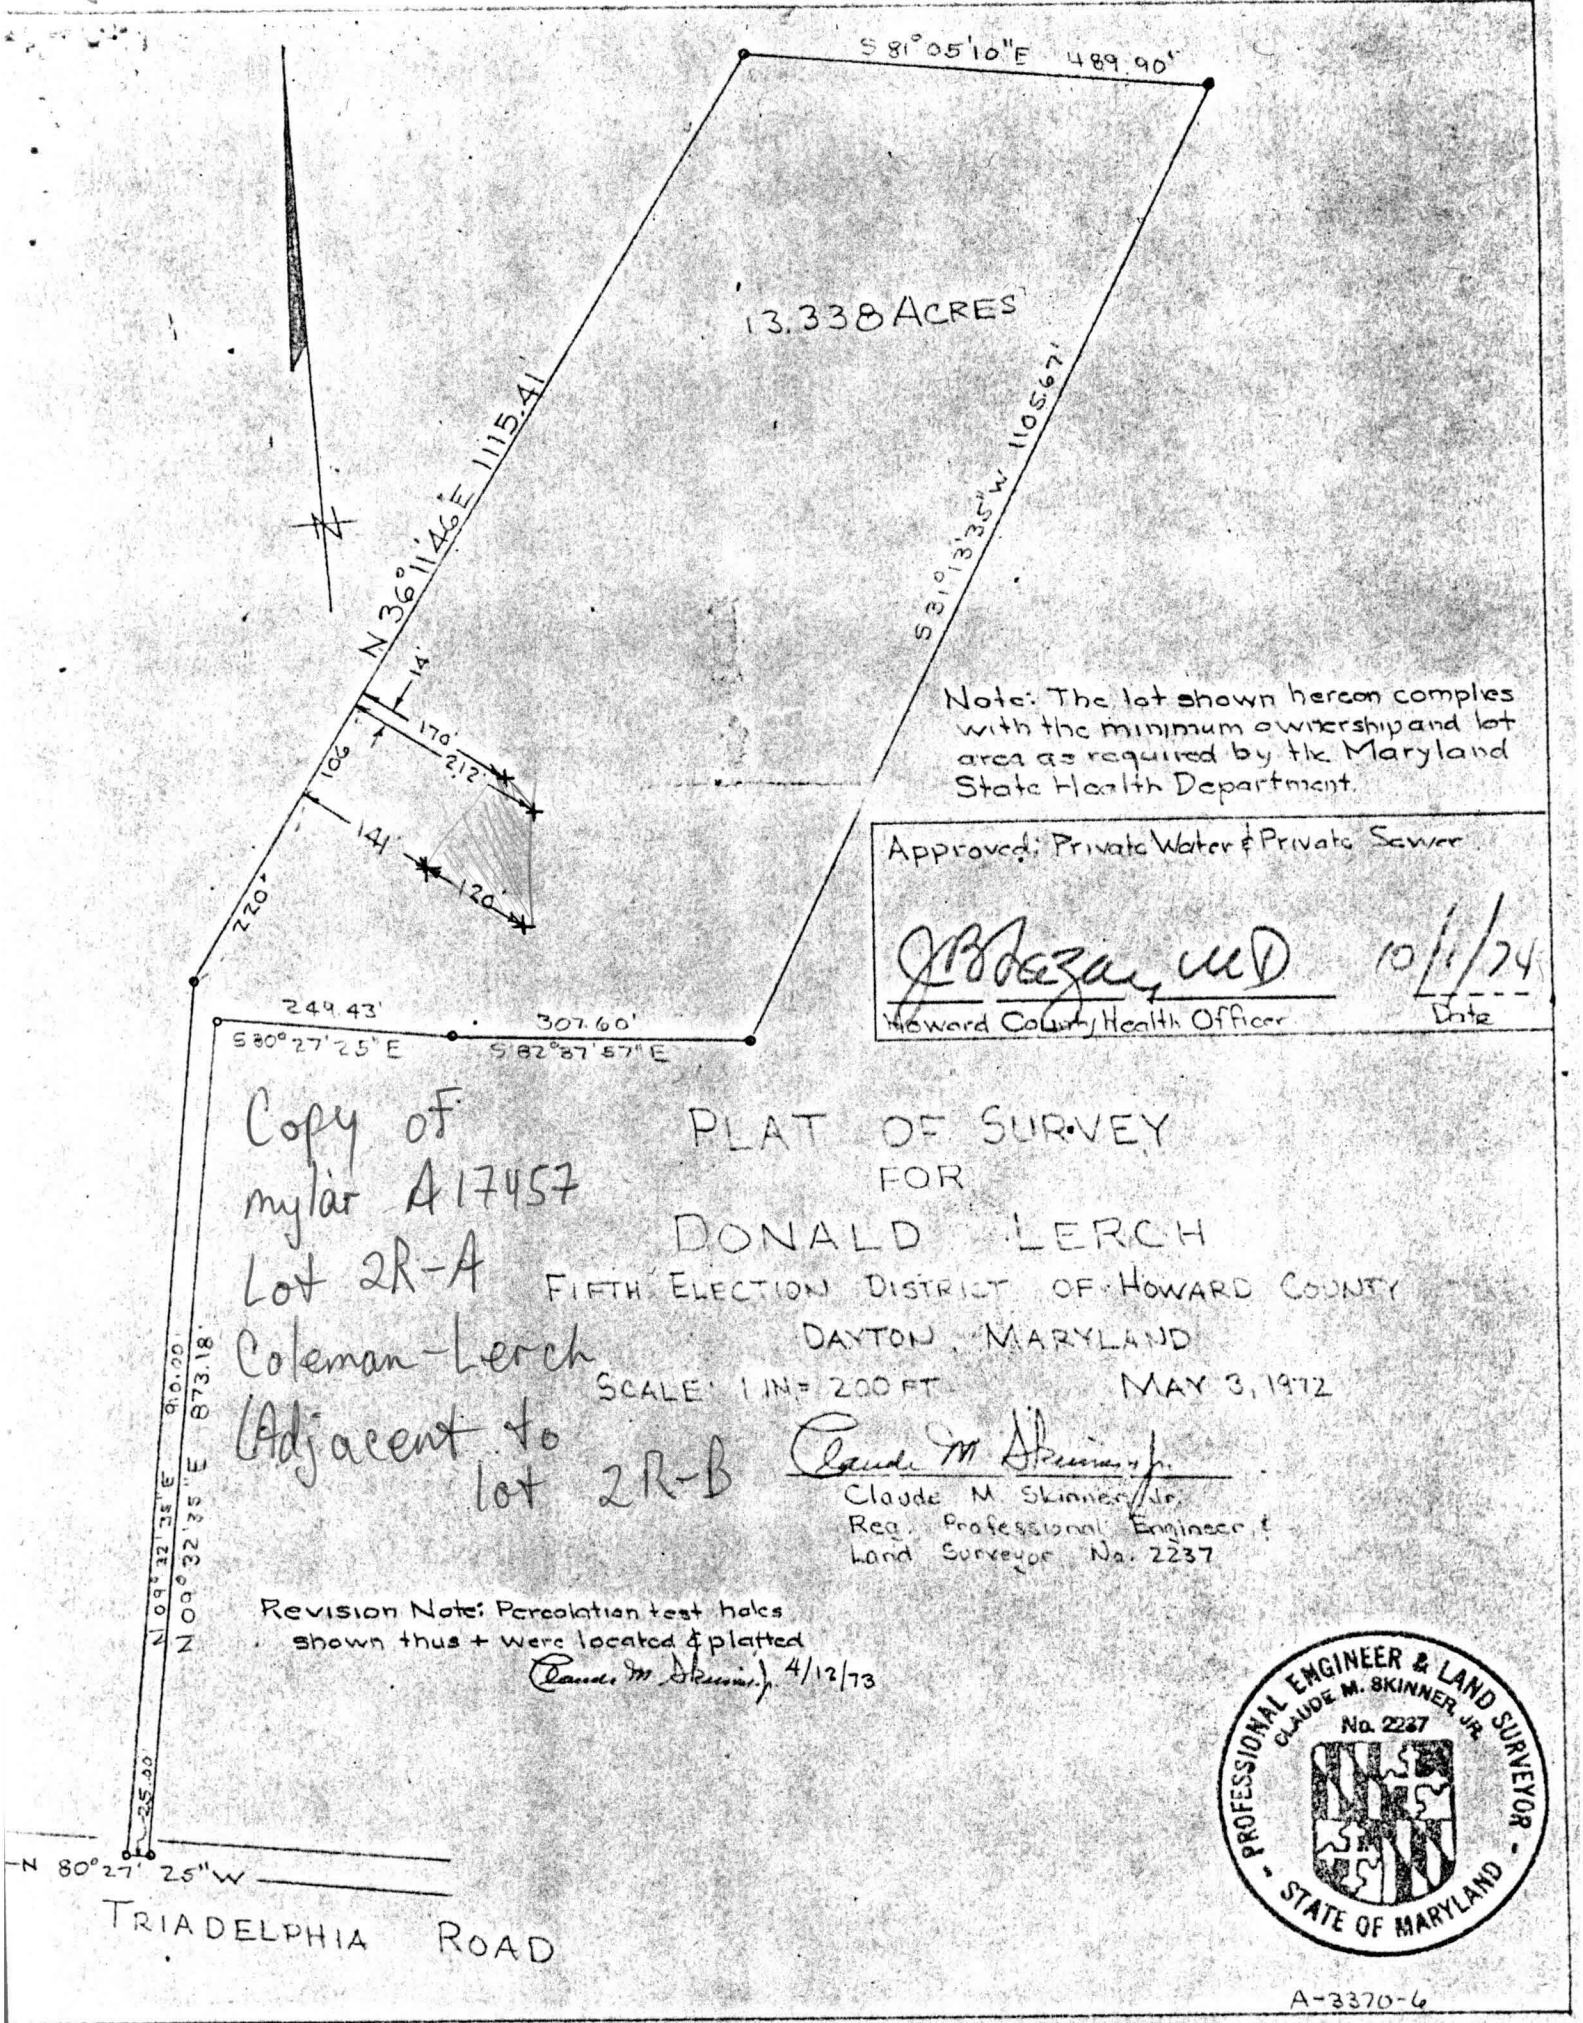

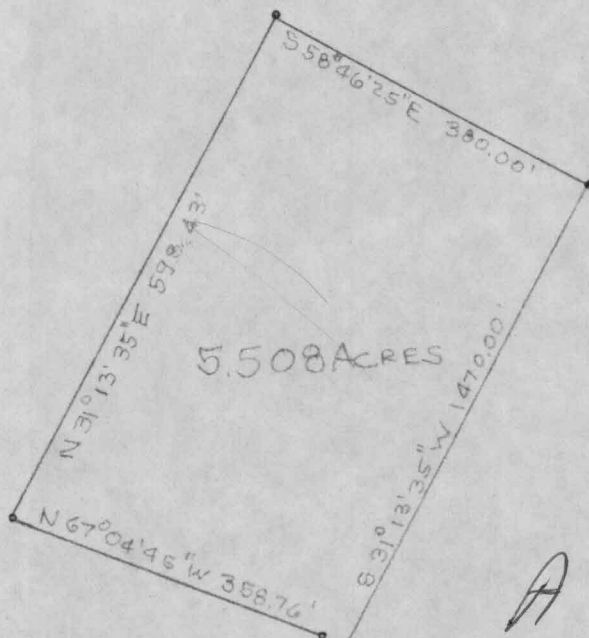

5.508 ACRES

A 17091
LOT 2

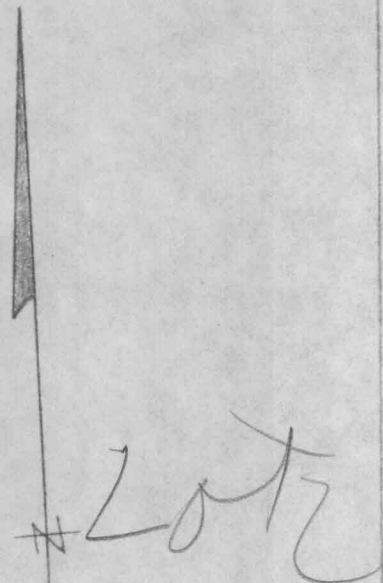

PLAT OF SURVEY
FOR
DONALD LERCH
FIFTH ELECTION DISTRICT OF HOWARD COUNTY
DAYTON, MARYLAND
SCALE: 1 IN = 200 FT MAY 3, 1972

Claude M. Skinner Jr.

Claude M. Skinner Jr.
Reg. Professional Engineer &
Land Surveyor No 2237

NS 50° 23' W
TRIADELPHIA ROAD

