

APPLICATION

PERCOLATION TESTING

HOWARD COUNTY HEALTH DEPARTMENT
BUREAU OF ENVIRONMENTAL HEALTH
P.O. BOX 476 ELLICOTT CITY, MARYLAND 21043
TELEPHONE: 461-9933

A 43750
P _____
DISTRICT 5TH
DATE 3-8-89

TO: THE COUNTY HEALTH OFFICER
ELLICOTT CITY, MARYLAND

I, HEREBY, APPLY FOR THE NECESSARY TEST IN ORDER TO CONSTRUCT (OR RECONSTRUCT) A SEWAGE DISPOSAL SYSTEM.

PROPERTY OWNER ~~ACTOGETHER LIMITED PARTNERSHIP~~ Roger D. Marino

ADDRESS _____ PHONE 381-5448

PROSPECTIVE BUYER _____

ADDRESS _____ PHONE Final 41

PROPERTY LOCATION:

SUBDIVISION 12 HILLS SECTION III LOT NO. 16 Preliminary RE-PERC

ROAD AND DESCRIPTION (14003 Twelve Oaks Court)

TAX MAP _____ PARCEL # _____

SIZE OF LOT 3 AC TYPE BLDG. SFD
(SINGLE FAMILY DWELLING OR COMMERCIAL)

THE SYSTEM INSTALLED UNDER THIS APPLICATION IS ACCEPTABLE ONLY UNTIL PUBLIC FACILITIES BECOME AVAILABLE. I FULLY UNDERSTAND THE

FEE CONNECTED WITH THE FILING OF THIS PERC TEST APPLICATION IS NON-REFUNDABLE UNDER ANY CIRCUMSTANCES. I ALSO AGREE TO COMPLY

WITH ALL M.O.S.H.A. REQUIREMENTS IN TESTING THIS LOT.

John C. Rea
(SIGNATURE OF APPLICANT)

APPROVED BY _____ FOR _____ DATE _____

REJECTED BY _____ FOR _____ DATE _____

HOLD PENDING FURTHER TESTS _____ DATE _____

REASONS FOR REJECTION OR HOLDING 3-9-89 Pending perc hole locations and subdivision plat approval JEN

BLDG. PERMIT SIGNED
AND RETURNED 9/20/89
Serial # 28974
SFD - 5 Bedrooms

THIS IS NOT A PERMIT

FE
SOIL PROFILE


0-4.0	Br sac 1m
4.0-12.0	Br sac 1m
12.0	Bottom

(5)

0-3.5 Dk br
si cl
lm

3.5-12.5 Tan
mica
sa si
lm

12.5 Bottom

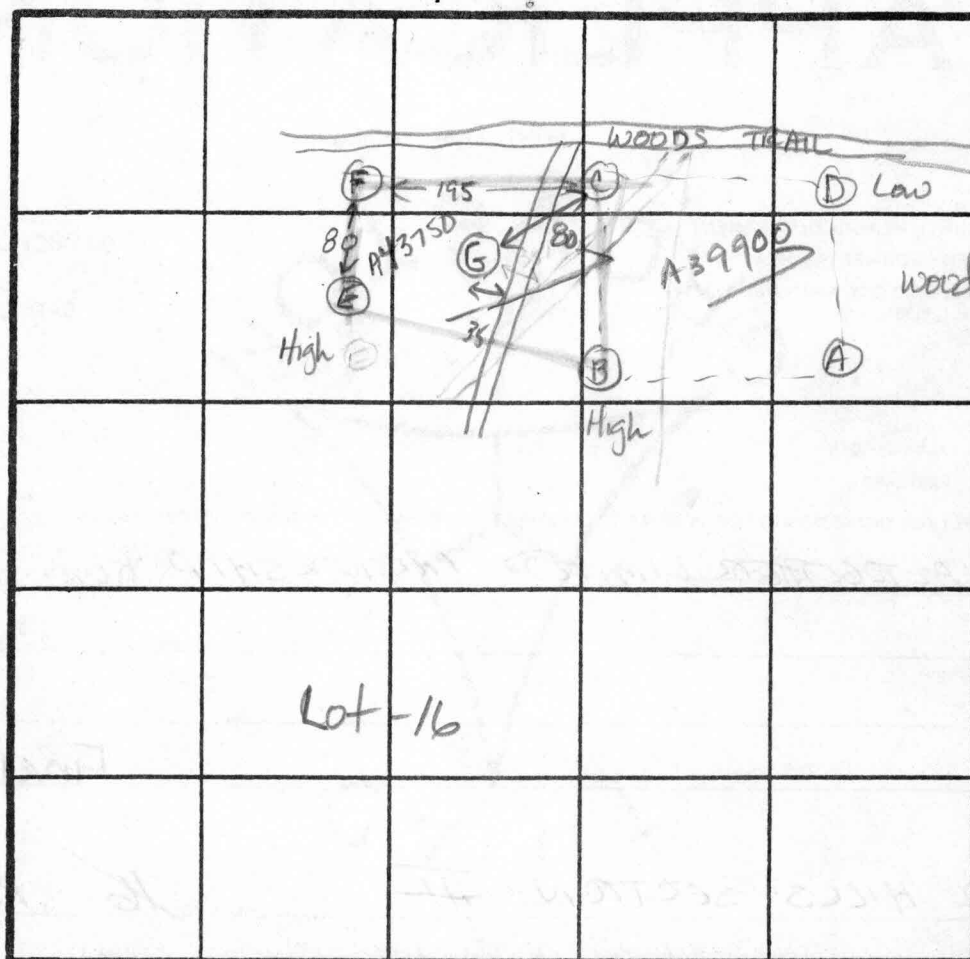

INDICATE NORTH - NAME ADJOINING ROADWAY AS BASE LINE

High B B-E
A
F
G
C
Low D

SHALLOW

$\bar{X} = 10 \text{ min}$
Inlet 3.0 ft
Bottom 5.0 ft
210 sq ft / bdr

[illegible]

REMARKS All holes moved uphill from C₁B

TYPE OF SOIL 0-3.5' Br sac l m, 3.5-12.0 Br-tan mica sa sil m

TESTED BY Jane E. Nadeau ALSO PRESENT John Reuwer
Olen K III, Dave

APPLICATION

PERCOLATION TESTING

HOWARD COUNTY HEALTH DEPARTMENT
BUREAU OF ENVIRONMENTAL HEALTH
P.O. BOX 476 ELLICOTT CITY, MARYLAND 21043
TELEPHONE: 461-9933

9-2-87 Percs
Ok pending plat
approval JEN

A 39901

P _____

DISTRICT 5 III

DATE 8-19-87

TO: THE COUNTY HEALTH OFFICER
ELLICOTT CITY, MARYLAND

I, HEREBY, APPLY FOR THE NECESSARY TEST IN ORDER TO CONSTRUCT (OR RECONSTRUCT) A SEWAGE DISPOSAL SYSTEM.

PROPERTY OWNER Alfred Bassler

ADDRESS 4994 Shepherd Lane PHONE 531-2193

PROSPECTIVE BUYER N/A

ADDRESS _____ PHONE Final Not Used

PROPERTY LOCATION:

SUBDIVISION Twelve Hills Sec III LOT NO. LOT 16 Preliminary new 13

ROAD AND DESCRIPTION Linden Church Rd

TAX MAP 28 PARCEL # 49

SIZE OF LOT 3 acres TYPE BLDG SFD
(SINGLE FAMILY DWELLING OR COMMERCIAL)

THE SYSTEM INSTALLED UNDER THIS APPLICATION IS ACCEPTABLE ONLY UNTIL PUBLIC FACILITIES BECOME AVAILABLE. I FULLY UNDERSTAND THE FEE CONNECTED WITH THE FILING OF THIS PERC TEST APPLICATION IS NON-REFUNDABLE UNDER ANY CIRCUMSTANCES. I ALSO AGREE TO COMPLY WITH ALL M.O.S.H.A. REQUIREMENTS IN TESTING THIS LOT.

Mal D. Kinn

(SIGNATURE OF APPLICANT)

APPROVED BY _____ FOR _____ DATE _____

REJECTED BY _____ FOR _____ DATE _____

HOLD PENDING FURTHER TESTS _____ DATE _____

REASONS FOR REJECTION OR HOLDING 9-2-87 for perc hole location and subdivision plat approval JEN.

THIS IS NOT A PERMIT

Highest A
B
C
Low D

#37101

(A)

SOIL PROFILE

0-4 Br sa
si gvl
lm, <5%
4-12.5 Tan to
white
sa si lm
12.5 Bottom


(B)

0-5 Br si sa
loam
5-9 Brown to
grey
sa si lm,
trc broken
rock
frags
<5%
9.0 Refusal

(C)

0-2.5 Br sa
cl si lm,
little gvl
<5%
2.5-10 Tan sa
si lm
10 Bottom

EH-12-1079

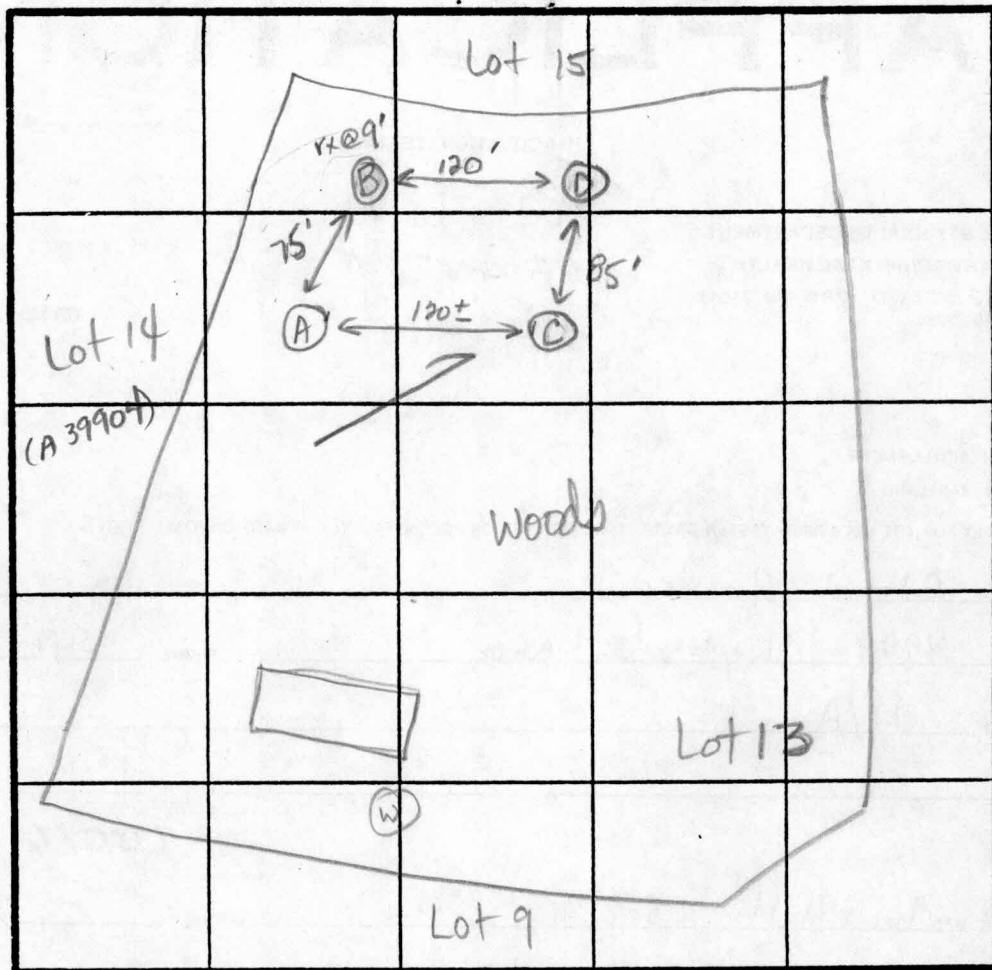

INDICATE NORTH - NAME ADJOINING ROADWAY AS BASE LINE.

(D)

0-4 Br sa si
cl lm
4-11.5 Br sa si
lm
11.5 Bottom

X Perc
10 min

200 #1/2 R
Inlet 3.0'
Bottom 5.0'

DATE	TEST NO.	DEPTH	PRE-WET		TEST - 1" DROP		TIME
			START	STOP	START	STOP	
9-2-87	A	4.0 S	3:03	3:05	3:05	3:07	2
		7.0 M	3:04	3:05	3:05	3:07	2
		12.5 D	Bottom (see profile)				
	B	9.0 V	(see profile)		Refusal @ 9.0' dc		
	C	3.5 S	3:15	3:19	3:19	3:28	9
		10.0 D	Bottom (see profile)				
	D	5.0 S	3:19	3:25	3:25	3:50	25
		11.5 D	Bottom (see profile)				

REMARKS

Holes as marked on plat. Refusal @ 9' on second high hole.

TYPE OF SOIL

0-5' Br sa si cl lm, 5-12' Brown-tan sa si lm

TESTED BY

J E Nadeau

ALSO PRESENT

Olen K, Mark Wright

APPLICATION

PERCOLATION TESTING

HOWARD COUNTY HEALTH DEPARTMENT
BUREAU OF ENVIRONMENTAL HEALTH
P.O. BOX 476 ELLICOTT CITY, MARYLAND 21043
TELEPHONE: 461-9933

9-15-87 Perc ok
pending plat approval
JEN

A 39908

P _____

DISTRICT 5TH

DATE 8-19-87

TO: THE COUNTY HEALTH OFFICER
ELLICOTT CITY, MARYLAND

I, HEREBY, APPLY FOR THE NECESSARY TEST IN ORDER TO CONSTRUCT (OR RECONSTRUCT) A SEWAGE DISPOSAL SYSTEM.

PROPERTY OWNER Alfred Bassler

ADDRESS 4994 Shepherd Lane PHONE 531-2193

PROSPECTIVE BUYER N/A

ADDRESS _____ PHONE Final Not Used

PROPERTY LOCATION:

SUBDIVISION Twelve Hills Sec III LOT NO. LOT 16 Preliminary new 8/12

ROAD AND DESCRIPTION Linden Church Rd

TAX MAP 28 PARCEL # 49

SIZE OF LOT 3 acres TYPE BLDG SFD
(SINGLE FAMILY DWELLING OR COMMERCIAL)

THE SYSTEM INSTALLED UNDER THIS APPLICATION IS ACCEPTABLE ONLY UNTIL PUBLIC FACILITIES BECOME AVAILABLE. I FULLY UNDERSTAND THE
FEE CONNECTED WITH THE FILING OF THIS PERC TEST APPLICATION IS NON-REFUNDABLE UNDER ANY CIRCUMSTANCES. I ALSO AGREE TO COMPLY
WITH ALL M.O.S.H.A. REQUIREMENTS IN TESTING THIS LOT.

Mark D. Rein
(SIGNATURE OF APPLICANT)

APPROVED BY _____ FOR _____ DATE _____

REJECTED BY _____ FOR _____ DATE _____

HOLD PENDING FURTHER TESTS _____ DATE _____



REASONS FOR REJECTION OR HOLDING 9-15-87 for subdivision plat approval
and perc hole location JEN

THIS IS NOT A PERMIT

High B
A
C
Low D

USE THESE SPECS FOR

37700

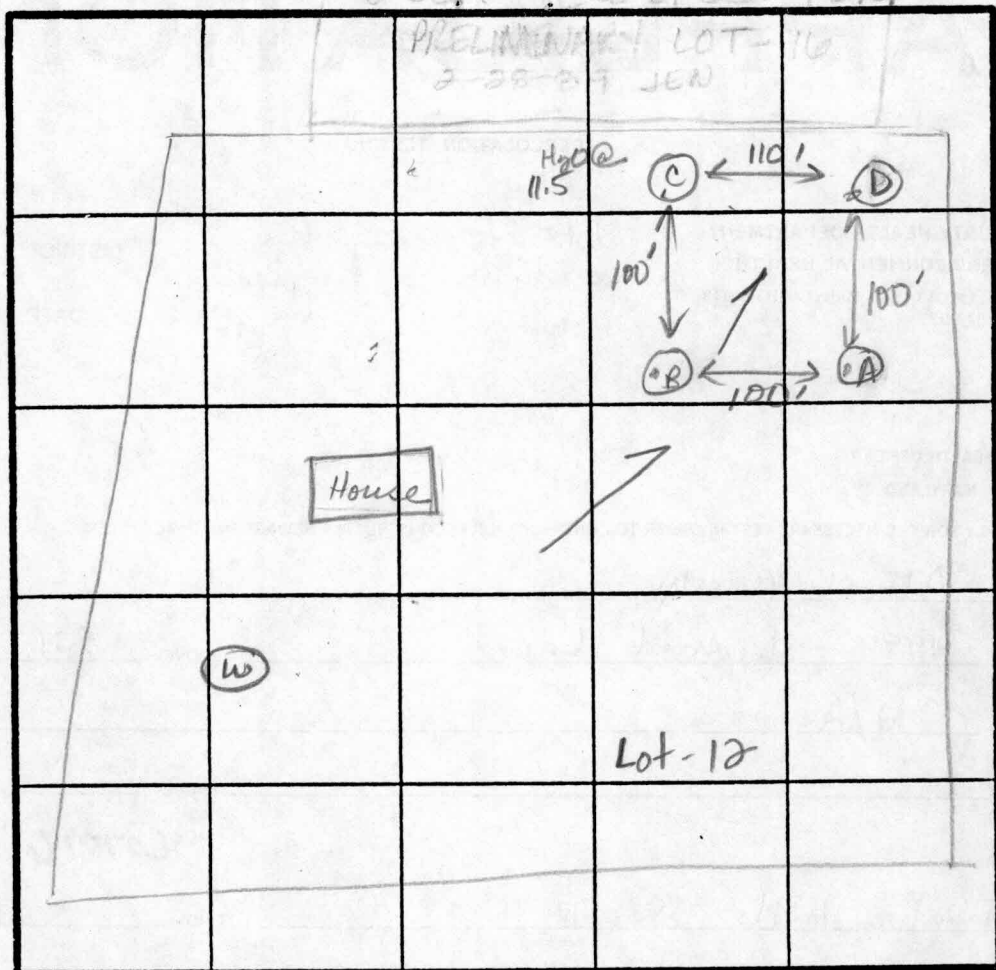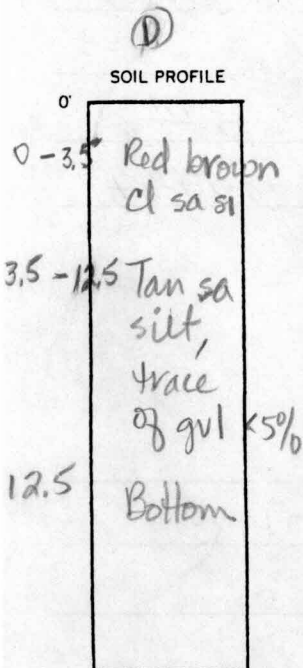

(C)

0-2.5' Brd sa si

2.5-12.5 Tan si sand water at 11.5'

12.5 Bottom

~~X~~ Forc 3 mi
180' R
Inlet 3.0'
Bottom 5.0'

INDICATE NORTH - NAME ADJOINING ROADWAY AS BASE LINE.

(A)

0-3.5 Red-brown cl sa silt

5-11.5 Tan sa silt, trace of gul <5%

Bottom

(B)

0-3 Brown sa silt

3-12 Tan silty sand

12 Bottom

DATE	TEST NO.	DEPTH	PRE-WET		TEST - 1" DROP		TIME
			START	STOP	START	STOP	
9-15-87	D	3.5 S	1:32	1:36	1:36	1:40	4
		12.5 D	Bottom (see profile)				Dry
	A	11.5 V	(see profile)				
	B	3.0 S	1:45	1:47	1:47	1:49	2
		8.0 M	1:45	1:47	1:47	1:49	2
		12.0 D	Bottom (see profile)				
	C	3.5 S	1:52	1:54	1:54	1:56	2
		12.5 D	Bottom (see profile)				Water @ 11.5' ok after 3 hrs.

REMARKS

Holes staked as shown on plat.

TYPE OF SOIL

0-3' Red-br cl sa si, 3'-12.5' Tan sa silt

TESTED BY

JE Nadeau

ALSO PRESENT

Olenk, Mark R.

