

9/6/01 Layout ~~new~~

9/7/01 WPT + Septic CO. (duration thru day)
Late PM (12:00)

9/11/01 Ditch insp & Final 10:30am / 1-2pm

ISSUE DATE: 8/17/2001

APPROVAL DATE: 9/11/01

**PERMIT
INDEXED**

515988-C
P 515988
A 43750

**ON-SITE SEWAGE DISPOSAL SYSTEM
HOWARD COUNTY HEALTH DEPARTMENT
BUREAU OF ENVIRONMENTAL HEALTH**

05-410800

K & K Excavating IS PERMITTED TO INSTALL ☒ ALTER ☐

ADDRESS: 14960 Frederick Rd, Woodbine 21797 PHONE NUMBER: 410-442-1336

SUBDIVISION: Twelve Hills LOT NUMBER: 41

ADDRESS: 14003 Twelve Oaks Court PROPERTY OWNER: ROBERT STEPHENS
Selfridge Builders

SEPTIC TANK CAPACITY (GALLONS): 1250 (TOPSEAM)

PUMP CHAMBER CAPACITY (GALLONS): N/A

NUMBER OF BEDROOMS: 4

SQUARE FEET PER BEDROOM: 210

LINEAR FEET OF TRENCH REQUIRED: 280

TRENCHES:	Trench to be 3.0 feet wide. Inlet 3.0 feet below original grade. Bottom maximum depth 5.0 feet below original grade. Effective area begins at 3.0 feet below original grade. 2.0 feet of stone below distribution pipe.
LOCATION:	Place the first trench 110' feet off the front lot line and 130 feet off the left lot line as seen when facing the lot from Twelve Hills Road. Run trenches on contour in both directions.
NOTES:	KEEP TANK OUT OF 100' WELL RADIUS

PLANS APPROVED: Amy Mc Millen ON SRU 6/9/01 DATE: 6-1-01

NOTE: PERMIT VOID AFTER 2 YEARS

NOTE: CONTRACTOR RESPONSIBLE FOR SCHEDULING A PRE-CONSTRUCTION INSPECTION FOR ALL INSTALLATIONS

NOTE: WATERTIGHT SEPTIC TANKS REQUIRED

NOTE: ALL PARTS OF SEPTIC SYSTEM SHALL BE 100 FEET FROM ANY WATER WELL

NOTE: MANHOLE RISERS REQUIRED ON ALL SEPTIC TANKS AND PUMP CHAMBERS

**NEITHER THE HOWARD COUNTY COUNCIL NOR THE HEALTH DEPARTMENT IS
RESPONSIBLE FOR THE SUCCESSFUL OPERATION OF ANY SYSTEM
PERMITTEE RESPONSIBLE FOR OBTAINING FINAL APPROVAL ON THIS PERMIT
CALL 410-313-2640 FOR INSPECTION OF SEPTIC SYSTEM**


**BUILDING PERMIT SIGNED
AND RETURNED**

11/2002 B00138371 INGROUND POOL

515988-C

NOT TO SCALE

HO-88-0595
well

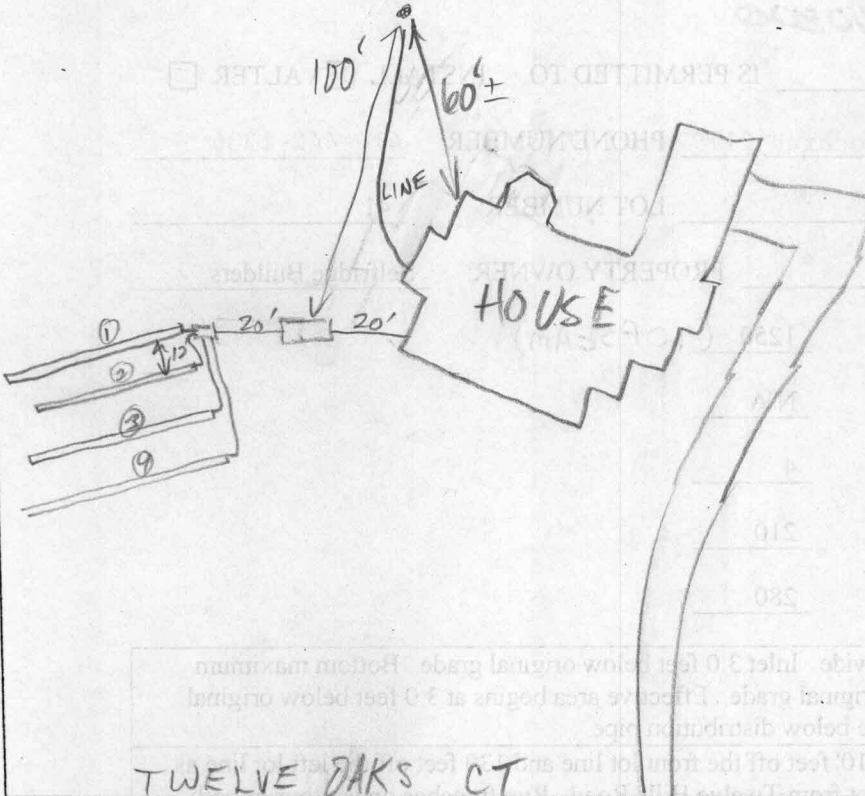

TRENCH DATA

TRENCH WIDTH 3'
TRENCH INLET DEPTH 3'
TRENCH BOTTOM DEPTH 5'
DEPTH OF STONE 2'
NUMBER OF TRENCHES 4
TOTAL TRENCH LENGTH 280'
166' 2-52' 3-83' 4
ABSORBENT AREA 840 ft²
DISTRIBUTION BOX LEVEL ✓
BAFFLE IN DISTRIBUTION BOX ✓

SEPTIC TANK DATA

SEPTIC TANK 1500 T.S. GALLONS
MANHOLE RISER ✓
6 INCH INSPECTION PORT No

PUMP CHAMBER DATA

PUMP CHAMBER GALLONS NA
MANHOLE RISER NA
ALARM NA
PUMP PERFORMANCE TEST NA

PRE-CONSTRUCTION INSPECTION: Layout - OK to place longer trenches all to south end of septic field
(to avoid 3 central big tree's) RPP 9/6/01

INSPECTION COMMENTS: 9/7/01 S.T., D.B. INSTALLED; NO OTHER WORK (MR)

Trench 2 covered (open @ ends) Trench 3 grouted, filled & prepared OK to cover, Trench 4 open OK to gravel fill
OK to cover all work when finished. (not closed early due to emergency office) RPP 9/11/01

INSPECTOR [Signature] DATE SYSTEM APPROVED 9/11/01