

# APPLICATION

PERCOLATION TESTING

A 42213  
P \_\_\_\_\_

HOWARD COUNTY HEALTH DEPARTMENT  
BUREAU OF ENVIRONMENTAL HEALTH  
P.O. BOX 476 ELLICOTT CITY, MARYLAND 21043  
TELEPHONE 461-9933

DISTRICT \_\_\_\_\_

DATE July 29, 1988

check for 200'  
from STREAM

TO: THE COUNTY HEALTH OFFICER  
ELLICOTT CITY, MARYLAND

I, HEREBY, APPLY FOR THE NECESSARY TEST IN ORDER TO CONSTRUCT (OR RECONSTRUCT) A SEWAGE DISPOSAL SYSTEM.

PROPERTY OWNER

ADDRESS

PHONE

PROSPECTIVE BUYER

ADDRESS

PHONE

PROPERTY LOCATION:

SUBDIVISION

LOT NO.

ROAD AND DESCRIPTION

TAX MAP

PARCEL #

TYPE BLDG

SIZE OF LOT

(SINGLE FAMILY DWELLING OR COMMERCIAL)

THE SYSTEM INSTALLED UNDER THIS APPLICATION IS ACCEPTABLE ONLY UNTIL PUBLIC FACILITIES BECOME AVAILABLE. I FULLY UNDERSTAND THE  
FEE CONNECTED WITH THE FILING OF THIS PERC TEST APPLICATION IS NON-REFUNDABLE UNDER ANY CIRCUMSTANCES. I ALSO AGREE TO COMPLY  
WITH ALL M.O.S.H.A. REQUIREMENTS IN TESTING THIS LOT.

(SIGNATURE OF APPLICANT)

APPROVED BY

FOR

DATE

REJECTED BY

FOR

DATE

HOLD PENDING FURTHER TESTS

DATE

REASONS FOR REJECTION OR HOLDING

10-24-88 For perc hole location and plat approval.  
well casing should be extended 8 inches above grade if new  
additions are proposed - E Nadeau.


## THIS IS NOT A PERMIT

A 42213

①

## SOIL PROFILE

|          |                                            |
|----------|--------------------------------------------|
| 0-4.5    | Br si cl<br>lm                             |
| 4.5-13.5 | Br si lm<br>some<br>broken<br>rock<br>~20% |
| 13.5     | Bottom                                     |

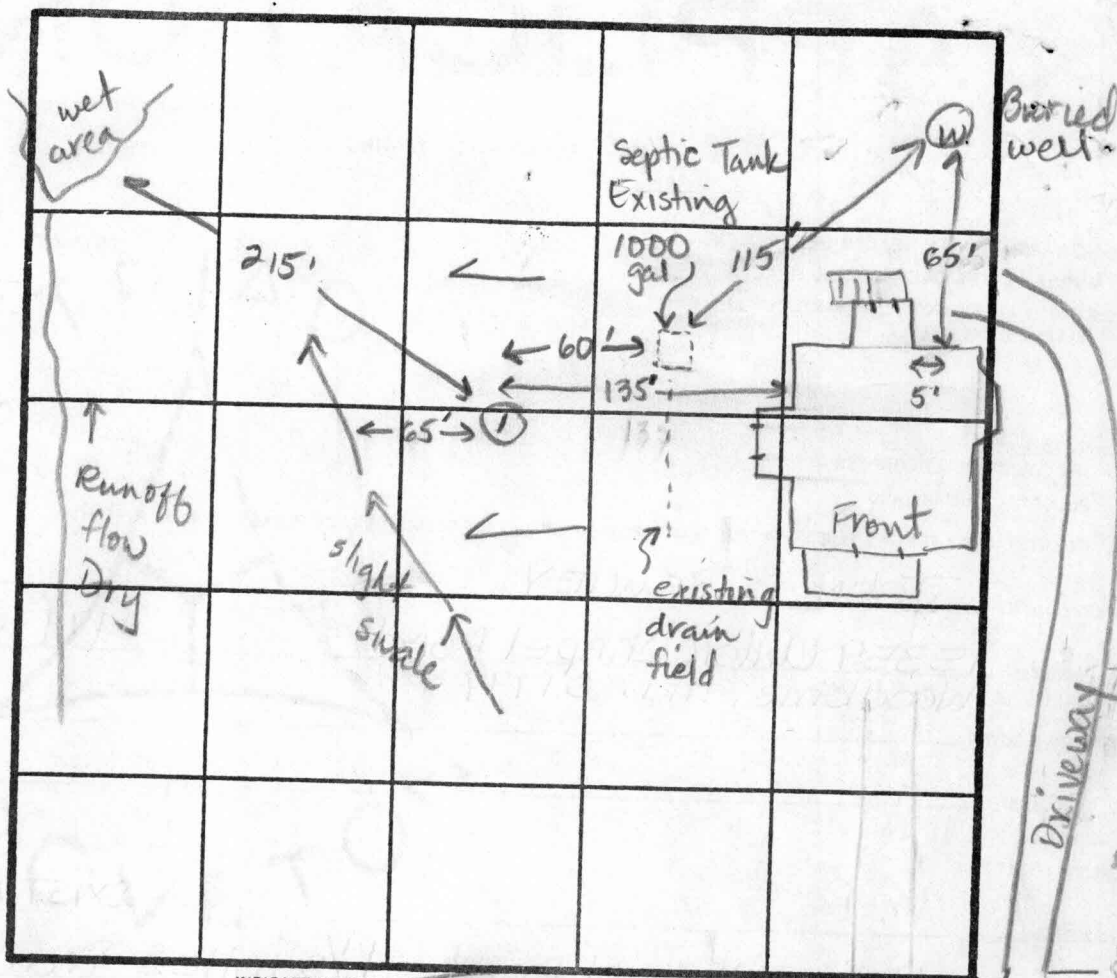

$\bar{X} = 9 \text{ min}$   
 Inlet 4.0 ft  
 Bottom 6.0 ft,  
 210 sq ft/  
 bedroom

| DATE     | TEST NO. | DEPTH  | PRE-WET              |       | TEST - 1" DROP |      | TIME  |
|----------|----------|--------|----------------------|-------|----------------|------|-------|
|          |          |        | START                | STOP  | START          | STOP |       |
| 10/24/88 | 1        | 4.5 S  | 12:49                | 12:53 | 12:53          | 1:02 | 9 min |
| ↓        |          | 13.5 D | Bottom (see profile) |       |                |      | ok    |
|          |          |        |                      |       |                |      |       |
|          |          |        |                      |       |                |      |       |
REMARKS

Existing, 1000 gal tank is pumped every 2 yrs. Repair area ok.

TYPE OF SOIL

0-4.5 Br si cl lm, 4.5-13.5 Br si lm, ~20% broken rock

TESTED BY

J. E. Nadeau

ALSO PRESENT

J. Bewley  
Bud Arnold

27  
24  
108  
54  
64

847  
24  
108  
94  
112

25  
24  
100  
50

27  
24  
108  
54  
64