

APPLICATION

PERCOLATION TESTING

A 515042

P _____

HOWARD COUNTY HEALTH DEPARTMENT
BUREAU OF ENVIRONMENTAL HEALTH
3525-H ELLICOTT MILLS DRIVE/ELLICOTT CITY, MARYLAND 21043
TELEPHONE: 313-2640

DISTRICT _____

DATE _____

TO: THE COUNTY HEALTH OFFICER
ELLICOTT CITY, MARYLAND

I HEREBY APPLY FOR THE NECESSARY TEST PRIOR TO APPLICATION FOR PERMIT TO CONSTRUCT (OR RECONSTRUCT) A SEWAGE DISPOSAL SYSTEM.

PROPERTY OWNER _____

ADDRESS _____ PHONE _____

AGENT OR PROSPECTIVE BUYER _____

ADDRESS _____ PHONE _____

PROPERTY LOCATION:

SUBDIVISION Benedict Farm LOT NO. _____

ROAD AND DESCRIPTION _____

TAX MAP _____ PARCEL # _____

SIZE OF LOT _____ TYPE BLDG. _____
(SINGLE FAMILY DWELLING OR COMMERCIAL)

THE SYSTEM INSTALLED UNDER THIS APPLICATION IS ACCEPTABLE ONLY UNTIL PUBLIC FACILITIES BECOME AVAILABLE. I FULLY UNDERSTAND THE FEE CONNECTED WITH THE FILING OF THIS PERC TEST APPLICATION IS NON-REFUNDABLE UNDER ANY CIRCUMSTANCES. I ALSO AGREE TO COMPLY WITH ALL M.O.S.H.A. REQUIREMENTS IN TESTING THIS LOT.

(SIGNATURE OF APPLICANT)

APPROVED BY _____ FOR _____ DATE _____

DISAPPROVED BY _____ FOR _____ DATE _____

HOLD PENDING FURTHER TESTS _____

REASONS FOR REJECTION OR HOLDING _____

PERCOLATION TEST PLAT/PRELIMINARY PLAT - TITLE OR I.D. # _____ DATE _____

SITE DEVELOPMENT PLAN/FINAL PLAT - TITLE OR I.D. # _____ DATE _____

THIS IS NOT A PERMIT

lot 41

COUNTY #

SOIL PROFILE


0' (427)
 orge brn
 saclm
 5
 30-60%
 Rx
 brng gray
 sand
 9
 brng gray
 sa lm
 15-20% frags
 14

(426)
 orge brn
 saclm
 4 1/2'
 tan gray
 sand &
 sa lm
 10-15%
 frags
 25% Rx pox
 6-8'

(424/422)
 orge brn
 si clm
 4 1/2'
 tan gray
 sand &
 sa lm
 15-20%
 frags
 14

SOIL PROFILE

0' (425)
 brn tan
 si clm
 6
 tan
 lt. org
 sa lm
 5-10%
 frags
 14 1/2'

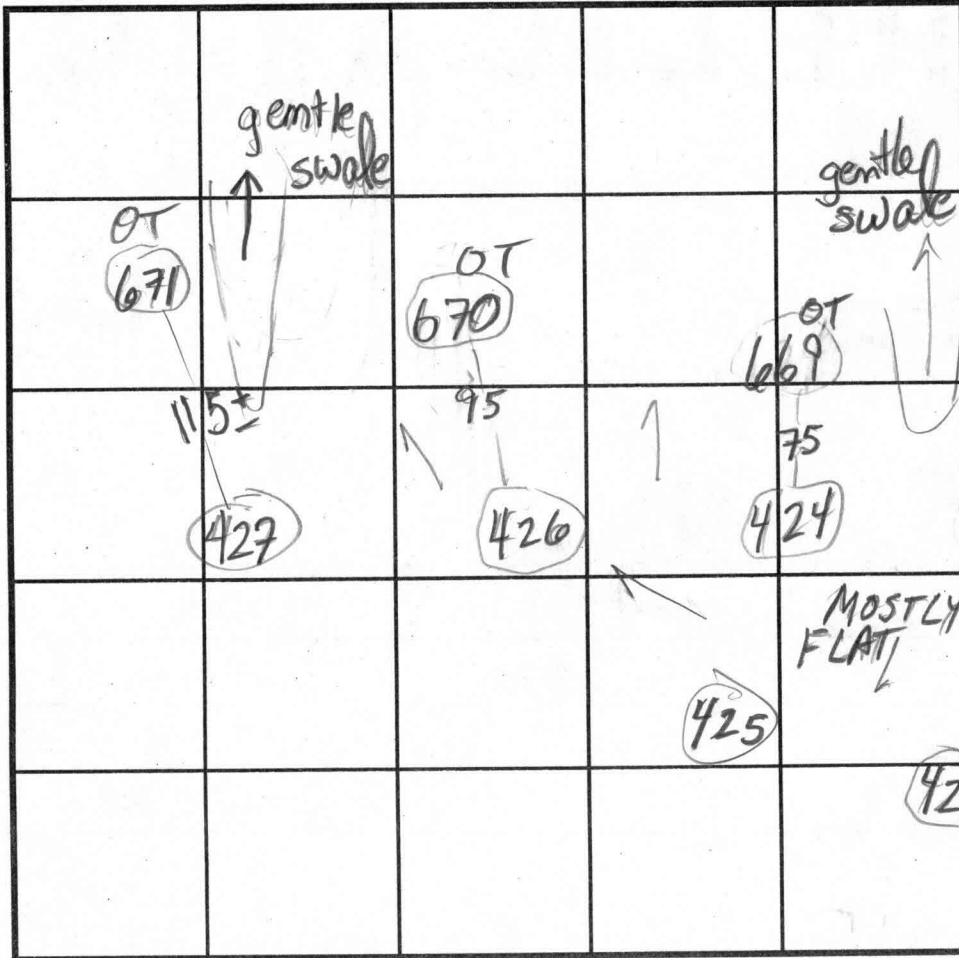

INDICATE NORTH - NAME ADJOINING ROADWAY AS BASE LINE.

DATE	TEST NO.	DEPTH	PRE-WET		TEST - 1" DROP		TIME
			START	STOP	START	STOP	
8/29/01	427	4 1/2' / 14	FAIL	Rx			
	426	5 1/2' / 14	11:07	11:11	11:11	11:21	10
	424	4 1/2' / 14	11:09	11:10	11:10	11:14	4
	422	4' 9" / 12' 9"	11:22	11:27	11:27	11:35	8
	425	5 1/2' / 14 1/2'	12:47 / 1:01	12:55 / 1:03	SLOW / 1:03	1:08	5

REMARKS ALL HOLES PER PLAN

TYPE OF SOIL _____

TESTED BY MARK REKIN ALSO PRESENT Chuck Crovo Mike Sacrew

TRENCH DESIGN DATA: AVERAGE PERCOLATION TIME _____ TRENCH WIDTH _____

INLET DEPTH _____ MAXIMUM BOTTOM DEPTH _____ SQ. FT./BEDROOM _____

LOT 41

COUNTY #

SOIL PROFILE

4
 orge
 brn
 cl lm

4
 tan beige
 gray
 si
 sa lm
 5-10%
 frags

14
 (422) (423)

4-4 1/2
 orge brn
 s. cl lm



13'
 tan gray
 sa &
 sa lm
 10-20%
 frags

(420)

1 1/2
 brn sa
 cl lm

14
 lt. orge
 tan gray
 lt. brn
 sand w/ quartz
 15-25%
 frags
 ↑ w/depth
 Bottom

SOIL PROFILE

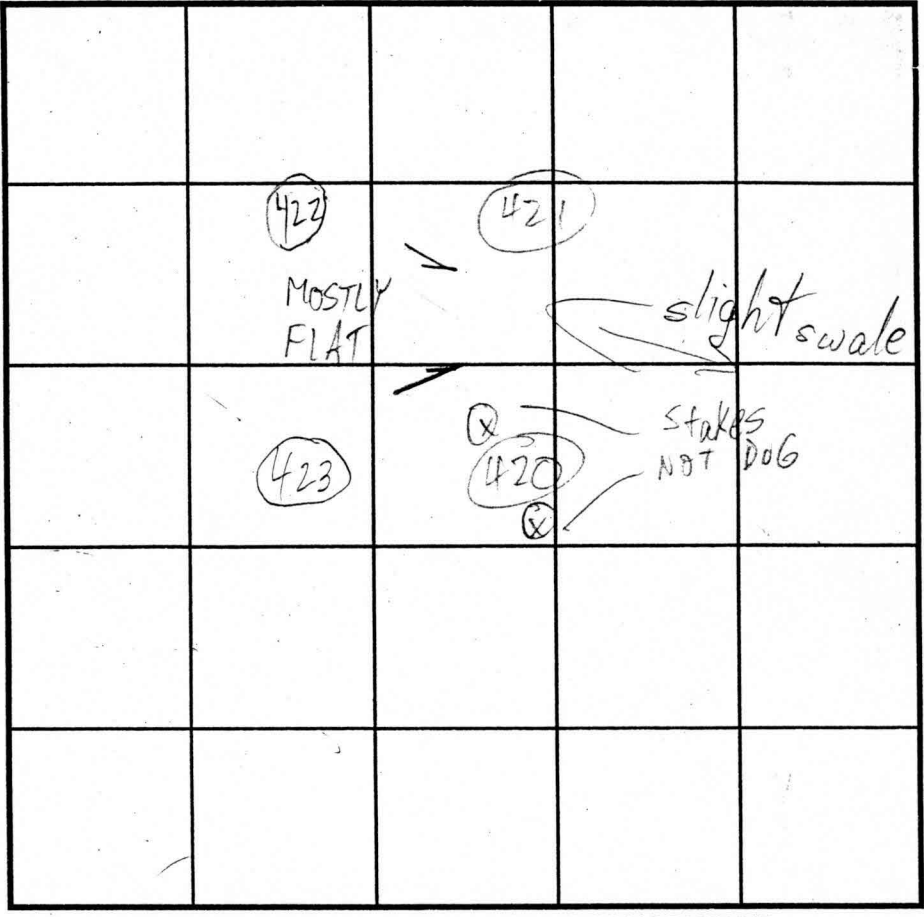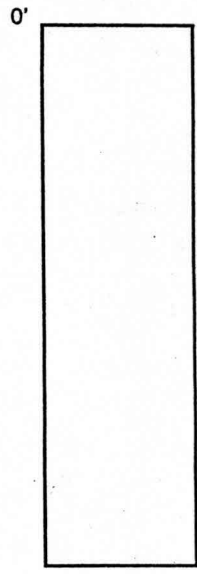

INDICATE NORTH - NAME ADJOINING ROADWAY AS BASE LINE.

DATE	TEST NO.	DEPTH	PRE-WET		TEST - 1" DROP		TIME
			START	STOP	START	STOP	
8/29/01	421	5' 14"	11:40	11:44	11:44	11:52	8
	422	4' 9" / 12' 9"	11:22	11:27	11:27	11:35	8
	420	4' 14"	12:09	12:12	12:12	12:18	6
	423	4 1/2' / 13 1/2"	12:21	12:26	12:26	12:34	8

REMARKS: (420) ALL HOLES PER PLAN

TESTED BY: Mark Riekin

ALSO PRESENT: Chuck Crovo, Mike's crew

TRENCH DESIGN DATA: AVERAGE PERCOLATION TIME: 8 TRENCH WIDTH:

INLET DEPTH: MAXIMUM BOTTOM DEPTH: SQ. FT./BEDROOM:



ITY NO. 1
OR WICK & CO.
REAINED BY HQA (D1)
7.88 NO WOODY
VEGETATION

ROAD 'A'
PUBLIC ACCESS STREET

NON-BUILDABLE
BULK PARCEL 'G'
2.97 AC.

MATCH
LINE
SEE
SHEET
2

NON-BUILDABLE
BULK PARCEL 'H'
5.41 AC.
1.254
601
40240 sq. ft.
390
PI 1253
340
PI 1255

LOT 31
40240 sq. ft.

NON-BUILDABLE
BULK PARCEL 'G'
2.97 AC.

LOT 32
40240 sq. ft.

LOT 33
40240 sq. ft.

LOT 34
40240 sq. ft.

LOT 35
40240 sq. ft.

LOT 36
40240 sq. ft.

LOT 37
40240 sq. ft.

LOT 38
40240 sq. ft.

LOT 39
40240 sq. ft.

LOT 40
40240 sq. ft.

LOT 41
40240 sq. ft.

LOT 42
40240 sq. ft.

LOT 43
40240 sq. ft.

LOT 44
40240 sq. ft.

LOT 45
40240 sq. ft.

LOT 46
40240 sq. ft.

LOT 47
40240 sq. ft.

LOT 48
40240 sq. ft.

LOT 49
40240 sq. ft.

LOT 50
40240 sq. ft.

LOT 51
40240 sq. ft.

LOT 52
40240 sq. ft.

LOT 53
40240 sq. ft.

LOT 54
40240 sq. ft.

LOT 55
40240 sq. ft.

LOT 56
40240 sq. ft.

LOT 57
40240 sq. ft.

LOT 58
40240 sq. ft.

LOT 59
40240 sq. ft.

LOT 60
40240 sq. ft.

LOT 61
40240 sq. ft.

LOT 62
40240 sq. ft.

LOT 63
40240 sq. ft.

LOT 64
40240 sq. ft.

LOT 65
40240 sq. ft.

LOT 66
40240 sq. ft.

LOT 67
40240 sq. ft.

LOT 68
40240 sq. ft.

LOT 69
40240 sq. ft.

LOT 70
40240 sq. ft.

LOT 71
40240 sq. ft.

LOT 72
40240 sq. ft.

LOT 73
40240 sq. ft.

LOT 74
40240 sq. ft.

LOT 75
40240 sq. ft.

LOT 76
40240 sq. ft.

LOT 77
40240 sq. ft.

LOT 78
40240 sq. ft.

LOT 79
40240 sq. ft.

LOT 80
40240 sq. ft.

LOT 81
40240 sq. ft.

LOT 82
40240 sq. ft.

LOT 83
40240 sq. ft.

LOT 84
40240 sq. ft.

LOT 85
40240 sq. ft.

LOT 86
40240 sq. ft.

LOT 87
40240 sq. ft.

LOT 88
40240 sq. ft.

LOT 89
40240 sq. ft.

LOT 90
40240 sq. ft.

LOT 91
40240 sq. ft.

LOT 92
40240 sq. ft.

LOT 93
40240 sq. ft.

LOT 94
40240 sq. ft.

LOT 95
40240 sq. ft.

LOT 236
40240 sq. ft.

LOT 237
40240 sq. ft.

LOT 238
40240 sq. ft.

LOT 239
40240 sq. ft.

LOT 240
40240 sq. ft.

LOT 241
40240 sq. ft.

LOT 242
40240 sq. ft.

LOT 243
40240 sq. ft.

LOT 244
40240 sq. ft.

LOT 245
40240 sq. ft.

LOT 246
40240 sq. ft.