

# APPLICATION

PERCOLATION TESTING

A 515042  
P \_\_\_\_\_

HOWARD COUNTY HEALTH DEPARTMENT  
BUREAU OF ENVIRONMENTAL HEALTH  
3525-H ELLICOTT MILLS DRIVE/ELLICOTT CITY, MARYLAND 21043  
TELEPHONE: 313-2640

DISTRICT \_\_\_\_\_  
DATE \_\_\_\_\_

TO: THE COUNTY HEALTH OFFICER  
ELLICOTT CITY, MARYLAND

I HEREBY APPLY FOR THE NECESSARY TEST PRIOR TO APPLICATION FOR PERMIT TO CONSTRUCT (OR RECONSTRUCT) A SEWAGE DISPOSAL SYSTEM.

PROPERTY OWNER \_\_\_\_\_

ADDRESS \_\_\_\_\_ PHONE \_\_\_\_\_

AGENT OR PROSPECTIVE BUYER \_\_\_\_\_

ADDRESS \_\_\_\_\_ PHONE \_\_\_\_\_

PROPERTY LOCATION:

SUBDIVISION \_\_\_\_\_ LOT NO. \_\_\_\_\_

ROAD AND DESCRIPTION Benedict Farm

TAX MAP \_\_\_\_\_ PARCEL # \_\_\_\_\_

SIZE OF LOT \_\_\_\_\_ TYPE BLDG. \_\_\_\_\_  
(SINGLE FAMILY DWELLING OR COMMERCIAL)

THE SYSTEM INSTALLED UNDER THIS APPLICATION IS ACCEPTABLE ONLY UNTIL PUBLIC FACILITIES BECOME AVAILABLE. I FULLY UNDERSTAND THE FEE CONNECTED WITH THE FILING OF THIS PERC TEST APPLICATION IS NON-REFUNDABLE UNDER ANY CIRCUMSTANCES. I ALSO AGREE TO COMPLY WITH ALL M.O.S.H.A. REQUIREMENTS IN TESTING THIS LOT. \_\_\_\_\_  
(SIGNATURE OF APPLICANT)

APPROVED BY \_\_\_\_\_ FOR \_\_\_\_\_ DATE \_\_\_\_\_

DISAPPROVED BY \_\_\_\_\_ FOR \_\_\_\_\_ DATE \_\_\_\_\_

HOLD PENDING FURTHER TESTS \_\_\_\_\_

REASONS FOR REJECTION OR HOLDING \_\_\_\_\_

PERCOLATION TEST PLAT/PRELIMINARY PLAT - TITLE OR I.D. # \_\_\_\_\_ DATE \_\_\_\_\_

SITE DEVELOPMENT PLAN/FINAL PLAT - TITLE OR I.D. # \_\_\_\_\_ DATE \_\_\_\_\_

# THIS IS NOT A PERMIT

# APPLICATION

PERCOLATION TESTING

A 515042

P \_\_\_\_\_

HOWARD COUNTY HEALTH DEPARTMENT  
BUREAU OF ENVIRONMENTAL HEALTH  
3525-H ELLICOTT MILLS DRIVE/ELLICOTT CITY, MARYLAND 21043  
TELEPHONE: 313-2640

DISTRICT \_\_\_\_\_

DATE \_\_\_\_\_

TO: THE COUNTY HEALTH OFFICER  
ELLICOTT CITY, MARYLAND

I HEREBY APPLY FOR THE NECESSARY TEST PRIOR TO APPLICATION FOR PERMIT TO CONSTRUCT (OR RECONSTRUCT) A SEWAGE DISPOSAL SYSTEM.

PROPERTY OWNER \_\_\_\_\_

ADDRESS \_\_\_\_\_ PHONE \_\_\_\_\_

AGENT OR PROSPECTIVE BUYER \_\_\_\_\_

ADDRESS \_\_\_\_\_ PHONE \_\_\_\_\_

PROPERTY LOCATION:

SUBDIVISION \_\_\_\_\_ LOT NO. \_\_\_\_\_

ROAD AND DESCRIPTION Benedict Farm

TAX MAP \_\_\_\_\_ PARCEL # \_\_\_\_\_

SIZE OF LOT \_\_\_\_\_ TYPE BLDG. \_\_\_\_\_  
(SINGLE FAMILY DWELLING OR COMMERCIAL)

THE SYSTEM INSTALLED UNDER THIS APPLICATION IS ACCEPTABLE ONLY UNTIL PUBLIC FACILITIES BECOME AVAILABLE. I FULLY UNDERSTAND THE FEE CONNECTED WITH THE FILING OF THIS PERC TEST APPLICATION IS NON-REFUNDABLE UNDER ANY CIRCUMSTANCES. I ALSO AGREE TO COMPLY WITH ALL M.O.S.H.A. REQUIREMENTS IN TESTING THIS LOT.

(SIGNATURE OF APPLICANT)

APPROVED BY \_\_\_\_\_ FOR \_\_\_\_\_ DATE \_\_\_\_\_

DISAPPROVED BY \_\_\_\_\_ FOR \_\_\_\_\_ DATE \_\_\_\_\_

HOLD PENDING FURTHER TESTS \_\_\_\_\_

REASONS FOR REJECTION OR HOLDING \_\_\_\_\_

PERCOLATION TEST PLAT/PRELIMINARY PLAT - TITLE OR I.D. # \_\_\_\_\_ DATE \_\_\_\_\_


SITE DEVELOPMENT PLAN/FINAL PLAT - TITLE OR I.D. # \_\_\_\_\_ DATE \_\_\_\_\_

# THIS IS NOT A PERMIT

Lot 37

COLINEY#  
394  
SOIL PROFILE  
395 (396)

brn sac 1m  
3'  
tan brn gray yel sand  
10-25% frags  
20-30%  
13' 4"

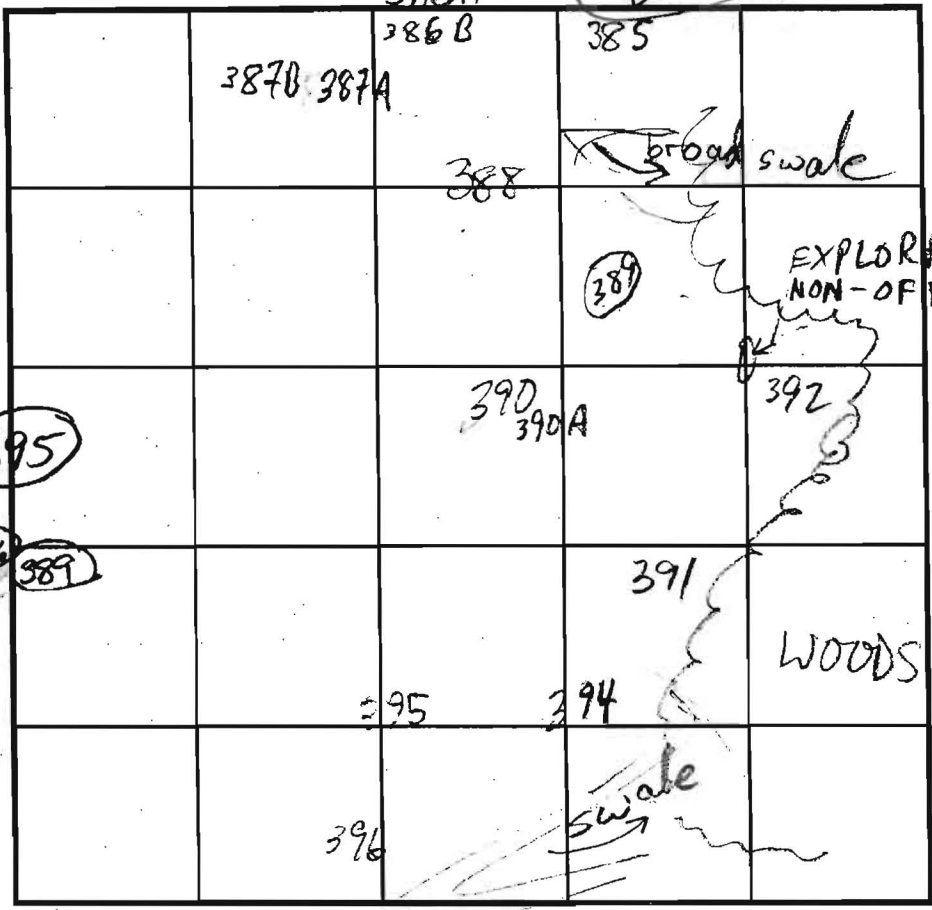

SOIL PROFILE

EXPLORATORY  
NON-OFFICIAL

WOODS

10-20% Rx  
in 394  
388  
20-25% Rx  
in  
392  
390A

(385)  
brn sac 1m  
15% frags  
2  
tan sa  
30-35% frags  
6  
25% frags  
8-9  
10% frags  
13

INDICATE NORTH - NAME ADJOINING ROADWAY AS BASE LINE.

DATE	TEST NO.	DEPTH	PRE-WET		TEST - 1" DROP		TIME	
			START	STOP	START	STOP		
9/12/01	395	4' / 13 1/2"	1:13:40	1:14:15	1:14:15	1:15:20	1	
	396	3 1/2' / 12 1/2"	1:15:40	1:17:00	1:17:00	1:19:00	2	
	394	4' / 14"	1:18:40	1:19:30	1:19:20	1:20:20	1	
	391	4' 4" / 13 1/2"	1:20:35	1:22:30	1:22:30	1:24:30	2	
	391	4' 4" / 13 1/2"	1:27:00	1:28:00	1:28:00	1:29:30	1 1/2	
	392	4' / 13 1/2"	1:29:45	1:31:00	1:31:00	1:33:00	2	
	392	4' / 13 1/2"	1:32:00	1:34	1:34	1:36	2	
	392	4' / 13 1/2"	1:38:00	1:39:15	1:31:15	1:40:15	1:15 FAIL	
	392	4' / 13 1/2"	1:40:45	1:42:15	1:42:15	1:43:30	1:15	
	392	4' / 13 1/2"	1:47:15	1:49:30	1:49:30	1:51:40	2	
	390A	3' 9" / 13"	1:42:45	1:48	1:48	1:56	8	
	389	3' / 13 1/2"	1:57:45	1:59:00	1:59:00	2:00:30	1 1/2	
	390	8'	2:00:45	2:03:00	2:03	2:06	3	
	390	8'	FAIL - REFUSAL - 30-50% Rx					
	385	3' / 13"	2:10:20	2:10:50	2:10:50	2:12:00	1:10	
	388	14'	2:12:10	2:14:00	2:14:00	2:16:00	2	


REMARKS: 388 14 VISUAL - OK  
 TYPE OF SOIL: 390A NOT PER PLAN, OTHERS PER PLAN  
 TESTED BY: H. RIFKIN / K. GoedeKing ALSO PRESENT: Chuck Crowe, Mike & Crew  
 TRENCH DESIGN DATA: AVERAGE PERCOLATION TIME \_\_\_\_\_ TRENCH WIDTH \_\_\_\_\_  
 INLET DEPTH \_\_\_\_\_ MAXIMUM BOTTOM DEPTH \_\_\_\_\_ SQ. FT./BEDROOM \_\_\_\_\_

13

COUNTY #

SOIL PROFILE

SOIL PROFILE

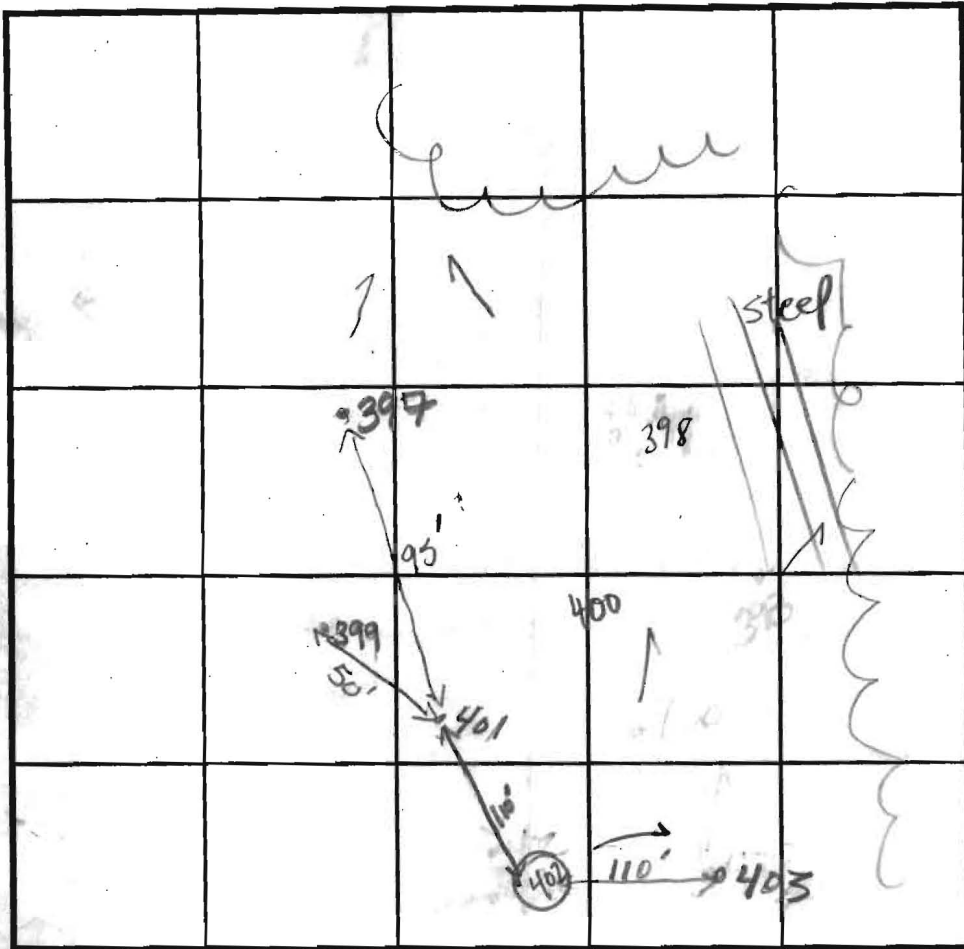

INDICATE NORTH - NAME ADJOINING ROADWAY AS BASE LINE.

0' (400)  
brn CL Lm  
15-20% rock frag  
2-3'  
brn Sa Lm  
Rock Frag  
25-35%  
Bottom

0' (398)  
Topsoil  
rd tan  
CL Lm  
3-5%  
Rock Frag  
2-3'  
org brn, tan, beige,  
grey w/ mica  
Rock Frag  
5-10%  
Bottom

13'10" (402)  
6" Topsoil  
tan brn  
CL Lm  
DK Rd CLAY  
org brn tan brn  
2' East  
5. CL Lm  
10-15% rock frag  
Bottom

14" (399)  
Topsoil  
lt brn CL Lm  
brn Sa Lm  
Rock Frag 10-15%  
Bottom 12'

4' (399)  
6" Topsoil  
DK Brn Rd.  
5-10% rock  
CL Lm  
4-4 1/2'  
tan brn dk brn  
SACL Lm  
15% Rock frag  
Saprolite  
Bottom

DATE	TEST NO.	DEPTH	PRE-WET		TEST - 1" DROP		TIME
			START	STOP	START	STOP	
9/12/01	400	4'3" S	1:11 <sup>15</sup>	1:13 <sup>10</sup>	1:13 <sup>10</sup>	1:16 <sup>15</sup>	3 min
		13'10" D					PASS
	402	4'2" S	1:20	1:22 <sup>15</sup>	1:22 <sup>15</sup>	1:25 <sup>00</sup>	3 min
		14" D					PASS
	399	5' S	1:34	1:42	1:42	1:53 <sup>00</sup>	11 min
		11" D					PASS
	398	5'7" S	1:44 <sup>20</sup>	1:45 <sup>30</sup>	1:45 <sup>30</sup>	1:47 <sup>50</sup>	2 min
		14" D					PASS
	397	4'8" S	1:51 <sup>10</sup>	1:53 <sup>00</sup>	1:53 <sup>00</sup>	1:56	3 min
		12" D					PASS

REMARKS: HOLES PER PLAN

TYPE OF SOIL \_\_\_\_\_

TESTED BY Goedeking ALSO PRESENT Chuck C. Miller & crew

TRENCH DESIGN DATA: AVERAGE PERCOLATION TIME \_\_\_\_\_ TRENCH WIDTH \_\_\_\_\_

INLET DEPTH \_\_\_\_\_ MAXIMUM BOTTOM DEPTH \_\_\_\_\_ SQ. FT./BEDROOM \_\_\_\_\_

13

COUNTY #

SOIL PROFILE

404

0' Topsoil

6" dk brn org. rd SA CULM

4 1/2' org brn dk brn yellow Grey

SA LM Rock 5-10% Saprolite Bottom

11' 379 mixed weeds off hole

Topsoil

4' H beige tan br LM

8' Rock Outcrop H tan H brn SA LM

SA LM Rock Frag 15-25% Bottom

11' NORTH SOUTH

Rock Outcrop

Topsoil

Topsoil


Topsoil

Topsoil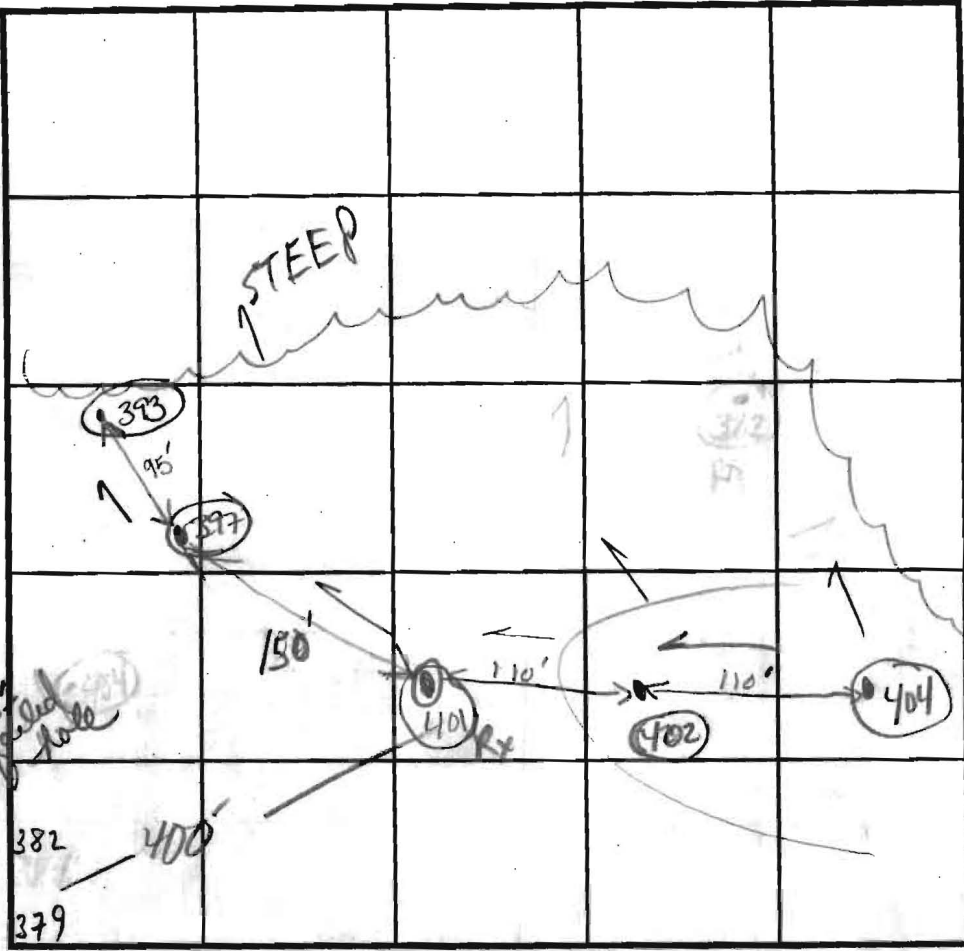

SOIL PROFILE

393

6" Topsoil

SW SIDE dk rd clay brn SA LM

2 1/2' H tan org S. lm

Rock Frag < 5%

Bottom

Bottom

INDICATE NORTH - NAME ADJOINING ROADWAY AS BASE LINE.

DATE	TEST NO.	DEPTH	PRE-WET		TEST - 1" DROP		TIME
			START	STOP	START	STOP	
9-12-01	401	Fail	Rock @ 3'	Refusal			Fail
	404	4' 5"	2:45	2:50	2:50	2:59	9 min
		11' D					PASS
	379	4' 5" / 14'	3:21	3:24	3:24	3:25	1 1/2 min
	382		EXCESSIVE	AX			Fail
	382	Refusal @ 3'					FAIL
	393	5' 5"	1:58	2:11	2:11	2:31	< 20 min
		14' D					PASS

REMARKS \_\_\_\_\_

TYPE OF SOIL \_\_\_\_\_ HOLES PER PLAN \_\_\_\_\_

TESTED BY Goedeking, K ALSO PRESENT Chuck

TRENCH DESIGN DATA: AVERAGE PERCOLATION TIME \_\_\_\_\_ TRENCH WIDTH Mike & crew

INLET DEPTH \_\_\_\_\_ MAXIMUM BOTTOM DEPTH \_\_\_\_\_ SQ. FT./BEDROOM \_\_\_\_\_



