

DEPARTMENT OF INSPECTIONS, LICENSES AND PERMITS 3430 COURT HOUSE DRIVE ELLICOTT CITY, MD 21043 PERMITS (410) 313-2655 INSPECTIONS (410) 313-1810 AUTOMATED INFORMATION (410) 313-3800	HOWARD COUNTY PERMIT APPLICATION	PERMIT NUMBER 807003900
---	-------------------------------------	----------------------------

Building Address 49602 Valley View overlook	Property Owner's Name Jall MD LLC Limited Partnership
Suite/Apt. #: _____ SDP/WP/Petition #: _____	Address 7164 Columbia gateway Dr.
Census Tract _____ Subdivision _____	City Columbia State MD Zip Code 21046
Section _____ Area _____ Lot 36	Home Phone N/A Work Phone 410-872-9105
Tax Map 29 Parcel 28 Grid 9	Applicant's Name & Mailing Address, (if other than stated hereon):
Zoning _____ Map Coordinates _____ Lot size _____	Phone _____ Fax _____
Existing Use SFD	Contractor Company ProBuilt Construction, Inc
Proposed Use SFD w/ Deck	Contact Person Edward Pacylowski
Estimated Construction Cost \$ 15,944	Address 13053 Long Days Ct.
Description of Work Build Approx 306 sf (21x18) deck w/ steps to grade	City Highland State MD Zip Code 20707
Occupant or Tenant _____	License No. 20247
Contact Name _____	Phone 301-854-0821 Fax 301-854-9632
Address _____	Engineer or Architect Company _____
City _____ State _____ Zip Code _____	Contact Person _____
Phone _____ Fax _____	Address _____
	City _____ State _____ Zip Code _____
	Phone _____ Fax _____

BUILDING DESCRIPTION - COMMERCIAL		BUILDING DESCRIPTION - RESIDENTIAL	
Building Characteristics	Utilities	Building Characteristics	Utilities
Height: _____	Water Supply: _____ Public _____ Private _____	SF Dwelling <input checked="" type="checkbox"/> SF Townhouse <input type="checkbox"/> Depth _____ Width _____	Water Supply: _____ Public _____ Private <input checked="" type="checkbox"/>
No. of stories: _____	Sewage Disposal: _____ Public _____ Private _____	1st floor: _____	Sewage Disposal: _____ Public _____ Private <input checked="" type="checkbox"/>
Gross area, sq. ft. per floor: _____	Electric Yes <input type="checkbox"/> No <input type="checkbox"/> Gas Yes <input type="checkbox"/> No <input type="checkbox"/>	2nd floor: _____	Electric Yes <input type="checkbox"/> No <input type="checkbox"/> Gas Yes <input type="checkbox"/> No <input type="checkbox"/>
Use group: _____	Heating System: _____ Electric <input type="checkbox"/> Oil <input type="checkbox"/> Natural Gas <input type="checkbox"/> Propane Gas <input type="checkbox"/>	Basement: _____	Heating System: _____ Electric <input type="checkbox"/> Oil <input type="checkbox"/> Natural Gas <input type="checkbox"/> Propane Gas <input type="checkbox"/>
Construction type: _____ Reinforced Concrete _____ Structural Steel _____ Masonry _____ Wood Frame _____	Sprinkler system: N/A <input type="checkbox"/> Full _____ Partial _____ Other Suppression _____ # of Heads _____	Finished Basement <input type="checkbox"/> Unfinished Basement <input type="checkbox"/> Crawl space <input type="checkbox"/> Slab on Grade <input type="checkbox"/> No. of Bedrooms _____	Sprinkler system: N/A <input type="checkbox"/> NFPA #13D _____ NFPA #13R _____ Other: _____
State Certified Modular <input type="checkbox"/>		Height: _____	
		Multi-family dwellings: _____	
		No. of efficiency units: _____	
		No. of 1 BR units: _____	
		No. of 2 BR units: _____	
		No. of 3 BR units: _____	
		Other Structure: _____	
		Dimensions: _____	
		Footings: posts + piers	
		Roof Height: _____	
		State Certified Modular <input type="checkbox"/>	
		Manufactured Home <input type="checkbox"/>	

THE UNDERSIGNED HEREBY CERTIFIES AND AGREES AS FOLLOWS: (1) THAT HE/SHE IS AUTHORIZED TO MAKE THIS APPLICATION; (2) THAT THE INFORMATION IS CORRECT; (3) THAT HE/SHE WILL COMPLY WITH ALL REGULATIONS OF HOWARD COUNTY WHICH ARE APPLICABLE THERETO; (4) THAT HE/SHE WILL PERFORM NO WORK ON THE ABOVE REFERENCED PROPERTY NOT SPECIFICALLY DESCRIBED IN THIS APPLICATION; (5) THAT HE/SHE GRANTS COUNTY OFFICIALS THE RIGHT TO ENTER ONTO THIS PROPERTY FOR THE PURPOSE OF INSPECTING THE WORK PERMITTED AND POSTING NOTICES.

Applicant's Signature President	Print Name Edward Pacylowski
Title/Company	Date 9/19/07

Checks payable to: DIRECTOR OF FINANCE OF HOWARD COUNTY
** PLEASE WRITE NEATLY AND LEGIBLY. **
- FOR OFFICE USE ONLY -

AGENCY	DATE	SIGNATURE APPROVAL	DPZ SETBACK INFORMATION	PROPERTY ID#
Land Development, DPZ			Front: _____	Filing fee \$ _____
State Highways			Rear: _____	Permit fee \$ _____
Building Official			Side: _____	Excise tax \$ _____
Dev. Engineering, DPZ	9/19/07	Stacy B...	Side St.: _____	Add'l per. fee \$ _____
Health			All minimum setbacks met?	TOTAL FEES \$ _____
Fire Protection			YES <input type="checkbox"/> NO <input type="checkbox"/>	Sub-total paid \$ _____
Is Sediment Control approval required prior to issuance?			Is Entrance Permit required?	Balance due \$ _____
YES <input type="checkbox"/> NO <input type="checkbox"/>			YES <input type="checkbox"/> NO <input type="checkbox"/>	Check # _____
CONTINGENCY CONSTRUCTION START: <input type="checkbox"/>			Historic District?	Validation # _____
ONE STOP SHOP: <input type="checkbox"/>			YES <input type="checkbox"/> NO <input type="checkbox"/>	
Distribution of Copies:	White: Building Official	Green: LDD, DPZ	Lot Coverage for NewTown Zone _____	
T:\forms\PERMIT.FRM			SDP/Red-line approval date _____	Accepted by _____
			Yellow: DED, DPZ	Pink: Health
				Gold: SHA

3. EXACT LENGTH OF SEPTIC TRENCHES ARE THE TIME OF PRECONSTRUCTION INSPECTION
4. SPOIL FROM THE TRENCHING OF THE SEI THE EXCAVATION FOR EACH INDIVIDUAL LOT.
5. SEDIMENT AND EROSION CONTROLS WERE UNDER F-05-031 AND GP-06-94 AND SH SPECIFICATIONS FOR SOIL EROSION AND SEI
6. STORMWATER MANAGEMENT FOR THIS LOT
7. THE EXISTING WELL (TAG NO. HO-95-03 BY BENCHMARK ENGINEERING, INC. ON 9-7
8. DRIVEWAY CULVERT COMPUTATIONS HAVE PLAN. THE CULVERT SHALL BE 15" CMP OR

INV. AT HOUSE	372.2
GRD. AT INV. AT HOUSE	382.0
INV. IN TANK	371.4
INV. OUT TANK	371.1
TOP OF TANK	372.4
GROUND OVER TANK	375.3
INV. IN DIST. BOX	370.3
INV. OUT DIST. BOX	370.0
GROUND AT BOX	374.0

LOT 36
49,218 S.F.


SEPTIC AREA
10,091 S.F.

**NON-BUILDABLE
BULK PARCEL H**

**HENLEY
CAROLINA**
FF=384.60
BF=373.79

**NON-BUILDABLE
PRESERVATION PARCEL A**

*deck ok
revised 08/00/3900
11/26/07 LL*

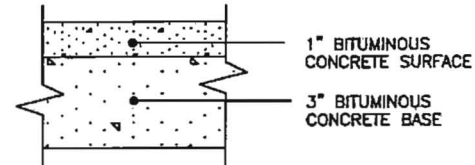

FULL DEPTH BIT. CONC. ALTERNATIVE
P-1 PAVING DETAIL
NOT TO SCALE

BENCHMARK
ENGINEERS ▲ LAND SURVEYORS ▲ PLANNERS
ENGINEERING, INC.
8480 BALTIMORE NATIONAL PIKE ▲ SUITE 418

DEPARTMENT OF INSPECTIONS, LICENSES AND PERMITS 3430 COURT HOUSE DRIVE ELICOTT CITY, MD 21043 PERMITS (410) 313-2455 INSPECTIONS (410) 313-1810 AUTOMATED INFORMATION (410) 313-3800	HOWARD COUNTY PERMIT APPLICATION	PERMIT NUMBER B07000836
--	-------------------------------------	----------------------------

Building Address <u>4962 Valley View Overlook</u> <u>Ellicott City, MD 21042</u> <u>FF889</u>	Property Owner's Name <u>Toll MD 3 LP</u>
Suite/Apt. #: _____ SDP/WP/Petition #: <u>E-05-031</u>	Address <u>7164 Columbia Gateway Dr #230</u>
Census Tract <u>605101</u> Subdivision <u>Wood Crossing</u>	City <u>Columbia</u> State <u>MD</u> Zip Code <u>21046</u>
Section _____ Area _____ Lot <u>36</u>	Home Phone _____ Work Phone <u>410-492-5276</u>
Tax Map <u>29</u> Parcel <u>28</u> Grid <u>9</u>	Applicant's Name & Mailing Address, (if other than stated herein): _____
Zoning <u>RC</u> Map Coordinates _____ Lot size <u>492164</u>	Phone _____ Fax _____

Existing Use <u>Office</u>	Contractor Company <u>Toll MD 3 LP</u>
Proposed Use <u>Residential</u>	Contact Person <u>Nathan Brite</u>
Estimated Construction Cost \$ <u>250,000</u>	Address <u>7164 Columbia Gateway Dr #230</u>
Description of Work <u>Henry Caroline</u>	City <u>Columbia</u> State <u>MD</u> Zip Code <u>21046</u>
_____	License No. <u>8048</u>
_____	Phone <u>410-492-5476</u> Fax <u>410-492-5230</u>

Occupant or Tenant <u>Toll MD 3 LP</u>	Engineer or Architect Company <u>Zachman Inc</u>
Contact Name <u>Nathan Brite</u>	Contact Person <u>Don Thompson</u>
Address <u>7164 Columbia Gateway Dr #230</u>	Address <u>4810 Balt. Ave #100</u>
City <u>Columbia</u> State <u>MD</u> Zip Code <u>21046</u>	City <u>Ellicott City</u> State <u>MD</u> Zip Code <u>21046</u>
Phone <u>410-492-5476</u> Fax <u>410-492-3230</u>	Phone <u>410-492-6105</u> Fax <u>410-492-6054</u>


BUILDING DESCRIPTION - <u>COMMERCIAL</u>		BUILDING DESCRIPTION - <u>RESIDENTIAL</u>	
Building Characteristics Height: _____ No. of stories: _____ Gross area, sq. ft. per floor: _____ Use group: _____ Construction type: <input type="checkbox"/> Reinforced Concrete <input type="checkbox"/> Structural Steel <input type="checkbox"/> Masonry <input type="checkbox"/> Wood Frame <input type="checkbox"/> State Certified Modular	Utilities Water Supply: _____ <input type="checkbox"/> Public <input type="checkbox"/> Private Sewage Disposal: _____ <input type="checkbox"/> Public <input type="checkbox"/> Private Electric Yes <input type="checkbox"/> No <input type="checkbox"/> Gas Yes <input type="checkbox"/> No <input type="checkbox"/> Heating System: Electric <input type="checkbox"/> Oil <input type="checkbox"/> Natural Gas <input type="checkbox"/> Propane Gas <input type="checkbox"/> Sprinkler system: <u>N/A</u> <input type="checkbox"/> <input type="checkbox"/> Full <input type="checkbox"/> Partial <input type="checkbox"/> Other Suppression # of Heads _____	Building Characteristics SF Dwelling <input checked="" type="checkbox"/> SF Townhouse <input type="checkbox"/> Depth <u>12'</u> Width <u>88'</u> 1st floor: <u>68'</u> 2nd floor: <u>68'</u> Basement: <u>68'</u> Finished Basement <input type="checkbox"/> Unfinished Basement <input type="checkbox"/> Crawl space <input type="checkbox"/> Slab on Grade <input type="checkbox"/> No. of Bedrooms <u>4</u> Height: <u>12'</u> Multi-family dwellings: No. of efficiency units: _____ No. of 1 BR units: _____ No. of 2 BR units: _____ No. of 3 BR units: _____ Other Structure: _____ Dimensions: _____ Footings: _____ Roof Height: _____ <input type="checkbox"/> State Certified Modular <input type="checkbox"/> Manufactured Home	Utilities Water Supply: _____ <input type="checkbox"/> Public <input checked="" type="checkbox"/> Private Sewage Disposal: _____ <input type="checkbox"/> Public <input checked="" type="checkbox"/> Private Electric Yes <input type="checkbox"/> No <input type="checkbox"/> Gas Yes <input type="checkbox"/> No <input type="checkbox"/> Heating System: Electric <input type="checkbox"/> Oil <input type="checkbox"/> Natural Gas <input checked="" type="checkbox"/> Propane Gas <input type="checkbox"/> Sprinkler system: <u>N/A</u> <input type="checkbox"/> <input type="checkbox"/> NFPA #13D <input type="checkbox"/> NFPA #13R <input type="checkbox"/> Other: _____

THE UNDERSIGNED HEREBY CERTIFIES AND AGREES AS FOLLOWS: (1) THAT HE/SHE IS AUTHORIZED TO MAKE THIS APPLICATION; (2) THAT THE INFORMATION IS CORRECT; (3) THAT HE/SHE WILL COMPLY WITH ALL REGULATIONS OF HOWARD COUNTY WHICH ARE APPLICABLE THERETO; (4) THAT HE/SHE WILL PERFORM NO WORK ON THE ABOVE REFERENCED PROPERTY NOT SPECIFICALLY DESCRIBED IN THIS APPLICATION; (5) THAT HE/SHE GRANTS COUNTY OFFICIALS THE RIGHT TO ENTER ONTO THIS PROPERTY FOR THE PURPOSE OF INSPECTING THE WORK PERMITTED AND POSTING NOTICES.

<u>Nathan Brite</u> Applicant's Signature	<u>Nathan Brite</u> Print Name
_____	<u>11/1/05</u> Date
_____	_____

Checks payable to: **DIRECTOR OF FINANCE OF HOWARD COUNTY**
** PLEASE WRITE NEATLY AND LEGIBLY. **
- FOR OFFICE USE ONLY -

AGENCY	DATE	SIGNATURE APPROVAL	DPZ SETBACK INFORMATION	PROPERTY ID#
Land Development, DPZ			Front: <u>80</u>	Filing fee \$ <u>100</u>
State Highways			Rear: <u>30</u>	Permit fee \$ _____
Building Official			Side: <u>10</u>	Excise tax \$ _____
Dev. Engineering, DPZ			Side St.: _____	Add'l per. fee \$ _____
Health	<u>4/5/07</u>	<u>[Signature]</u>	All minimum setbacks met? YES <input checked="" type="checkbox"/> NO <input type="checkbox"/>	TOTAL FEES \$ _____
Fire Protection			Is Entrance Permit required? YES <input checked="" type="checkbox"/> NO <input type="checkbox"/>	Sub-total paid \$ _____
Is Sediment Control approval required prior to issuance?			Historic District? YES <input type="checkbox"/> NO <input type="checkbox"/>	Balance due \$ _____
YES <input type="checkbox"/> NO <input type="checkbox"/>			Lot Coverage for NewTown Zone _____	Check # _____
CONTINGENCY CONSTRUCTION START: <input type="checkbox"/>			SDP/Red-line approval date _____	Validation # _____
ONE STOP SHOP: <input type="checkbox"/>			Accepted by _____	
Distribution of Copies:	White: Building Official	Green: LDD, DPZ	Yellow: DED, DPZ	Pink: Health
T:\norma\PERMIT.FRM				Gold: SHA

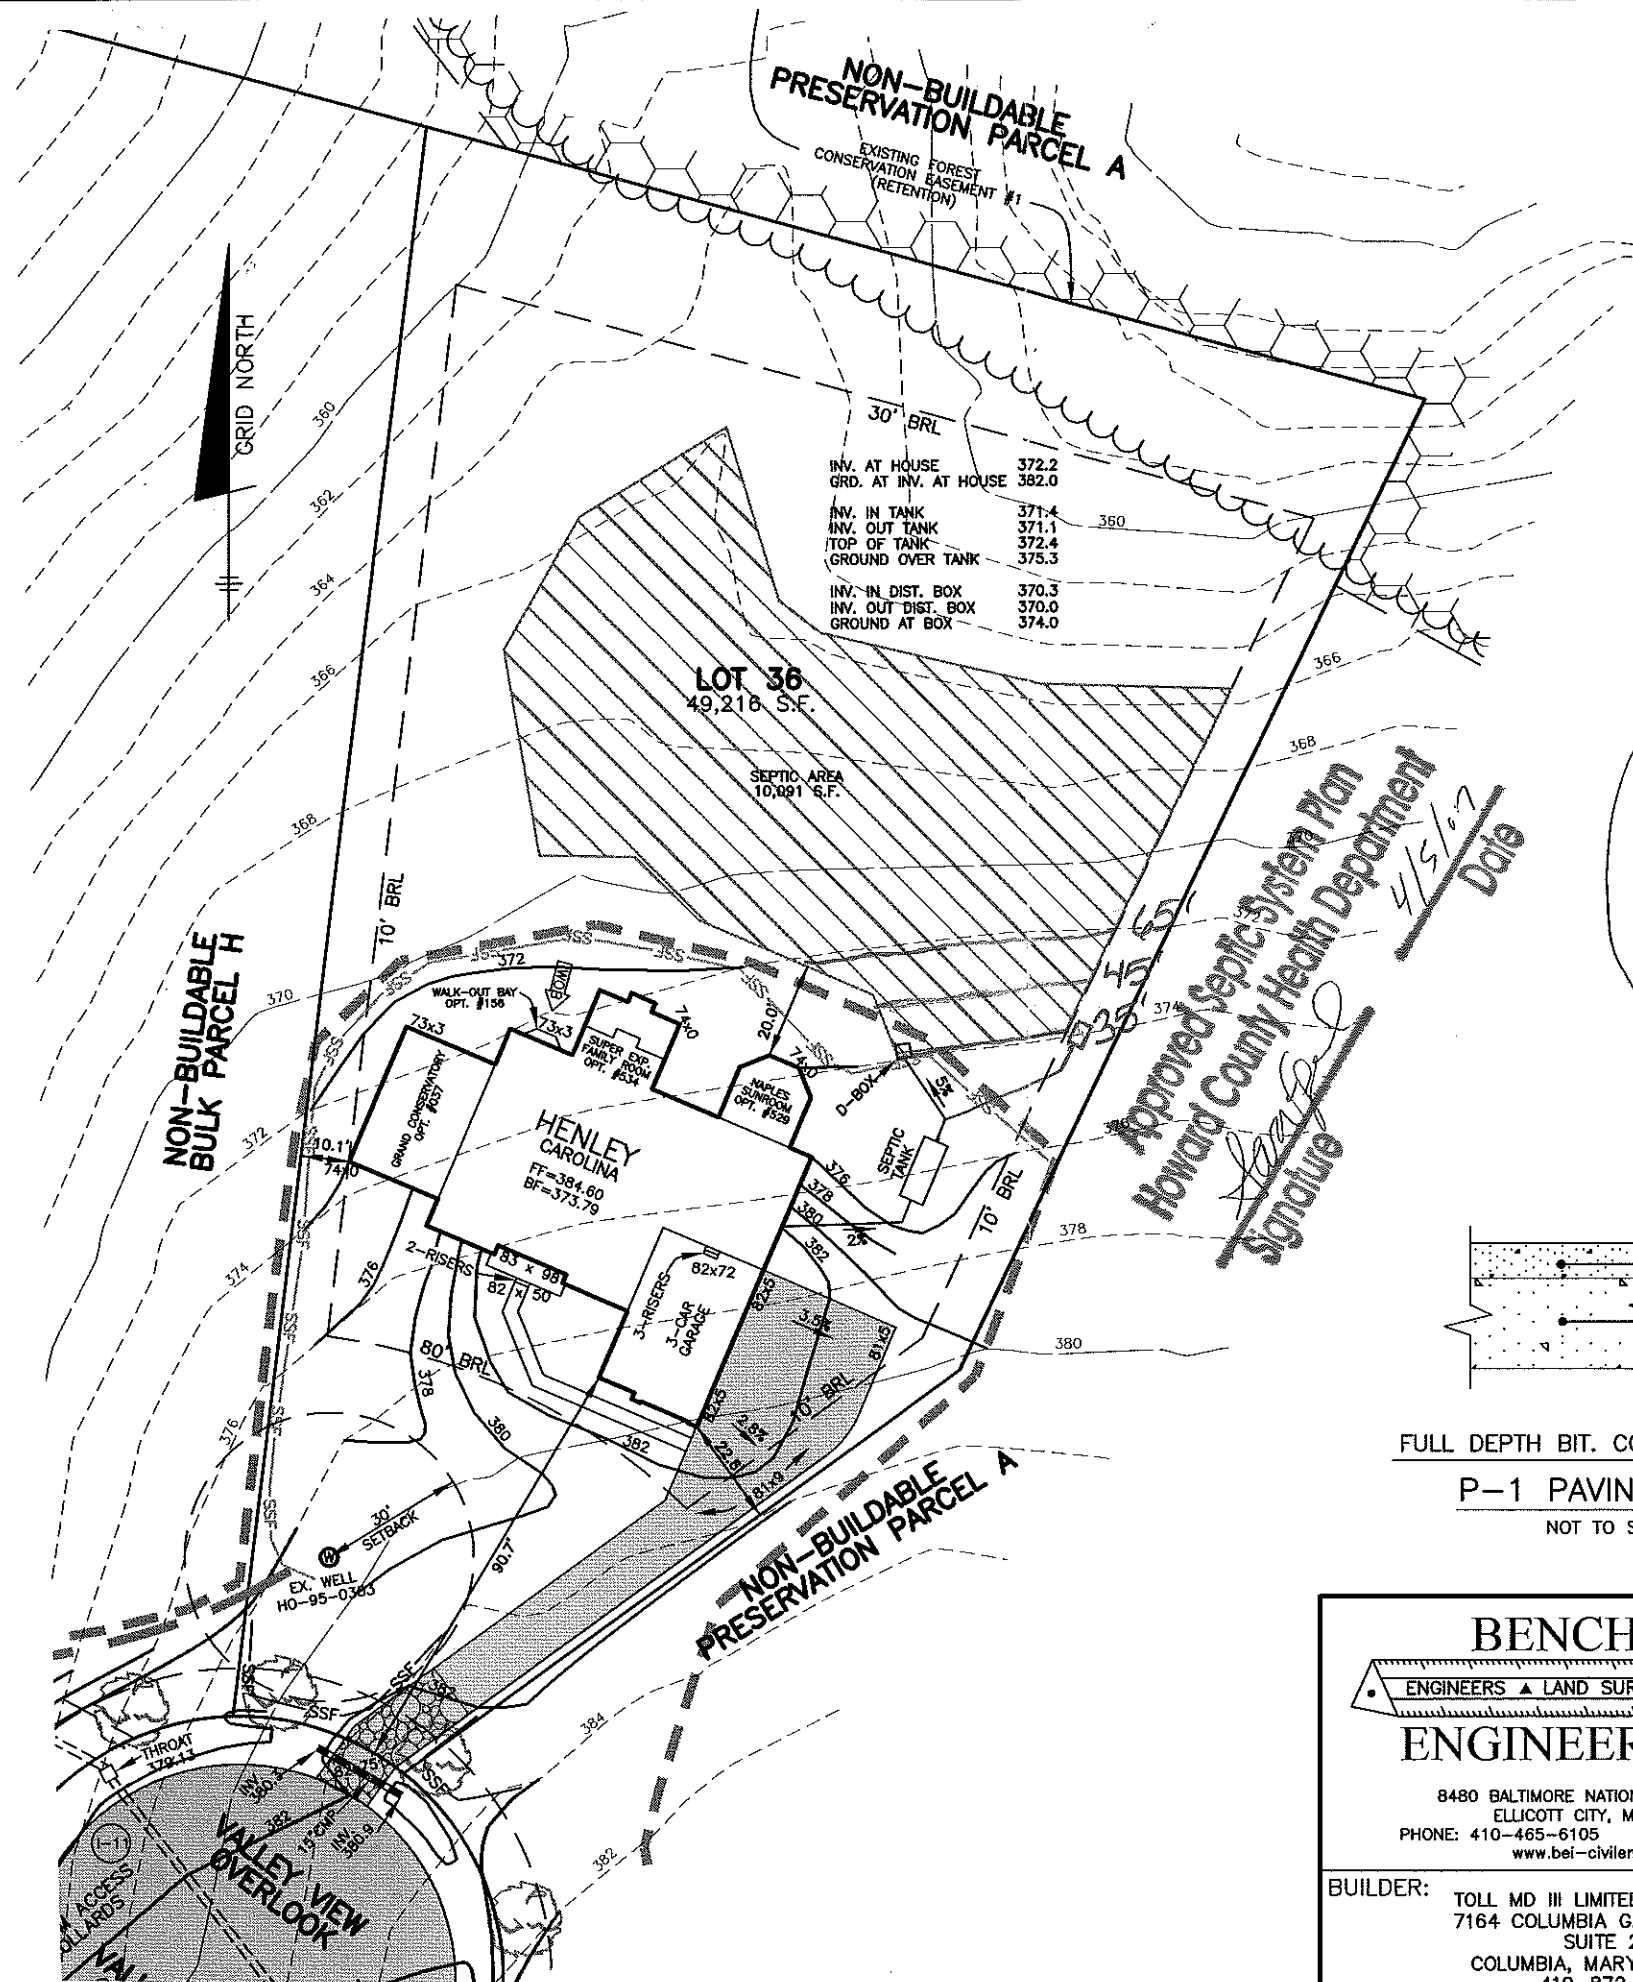


NOTES:

1. THE LOT SHOWN HEREON WAS RECORDED ON 12-13-05 AS PLAT NUMBER 17889. REFER TO THIS PLAT FOR LOT DIMENSIONS, LOT AREAS, ALL EASEMENTS AND BUILDING RESTRICTIONS.
2. THIS AREA DESIGNATES A PRIVATE SEWERAGE EASEMENT OF 10,000 SQUARE FEET AS REQUIRED BY THE STATE DEPARTMENT OF THE ENVIRONMENT FOR INDIVIDUAL SEWERAGE DISPOSAL. IMPROVEMENTS OF ANY NATURE IN THIS AREA IS RESTRICTED UNTIL PUBLIC SEWER IS AVAILABLE. THIS EASEMENT SHALL BECOME NULL AND VOID UPON CONNECTION TO A PUBLIC SEWERAGE SYSTEM. THE COUNTY HEALTH OFFICER SHALL HAVE THE AUTHORITY TO GRANT ADJUSTMENTS TO THE PRIVATE SEWERAGE EASEMENT. RECORDATION OF A MODIFIED SEWERAGE EASEMENT PLAT SHALL NOT BE NECESSARY.
3. EXACT LENGTH OF SEPTIC TRENCHES ARE BE DETERMINED BY THE HEALTH DEPARTMENT AT THE TIME OF PRECONSTRUCTION INSPECTION.
4. SPOIL FROM THE TRENCHING OF THE SEPTIC AREA IS TO BE PLACED ON THE UPHILL SIDE OF THE EXCAVATION FOR EACH INDIVIDUAL LOT.
5. SEDIMENT AND EROSION CONTROLS WERE APPROVED BY HOWARD SOIL CONSERVATION DISTRICT UNDER F-05-031 AND GP-06-94 AND SHALL COMPLY WITH THE 1994 MARYLAND STANDARDS AND SPECIFICATIONS FOR SOIL EROSION AND SEDIMENT CONTROL.
6. STORMWATER MANAGEMENT FOR THIS LOT WAS PROVIDED UNDER F-05-031.
7. THE EXISTING WELL (TAG NO. HO-95-0353) SHOWN ON THIS PLAN HAS BEEN FIELD LOCATED BY BENCHMARK ENGINEERING, INC. ON 9-7-06 AND IS ACCURATELY SHOWN.
8. DRIVEWAY CULVERT COMPUTATIONS HAVE BEEN PROVIDED WITH THIS BUILDING PERMIT PLOT PLAN. THE CULVERT SHALL BE 15" CMP OR ELLIPTICAL EQUIVALENT.

35'
45'
65'
145'

LEGEND

- EXISTING CONTOURS ESTABLISHED UNDER F-05-031
- FIELD SURVEYED WELL LOCATION
- STREET TREES INSTALLED UNDER F-05-031
- INDICATES WALK-OUT BASEMENT LOCATION
- STABILIZED CONSTRUCTION ENTRANCE INSTALLED UNDER GP-06-94
- SUPER SILT FENCE INSTALLED UNDER F-05-031
- SUPER SILT FENCE INSTALLED UNDER GP-06-94
- SILT FENCE INSTALLED UNDER F-05-031
- LIMIT OF DISTURBANCE UNDER F-05-031

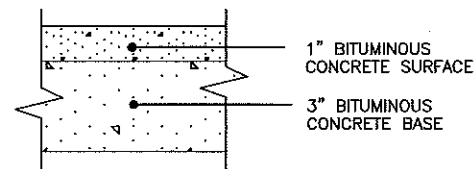

FULL DEPTH BIT. CONC. ALTERNATIVE
P-1 PAVING DETAIL
NOT TO SCALE

BENCHMARK
ENGINEERS ▲ LAND SURVEYORS ▲ PLANNERS
ENGINEERING, INC.

8480 BALTIMORE NATIONAL PIKE ▲ SUITE 418
ELLICOTT CITY, MARYLAND 21043
PHONE: 410-465-6105 FAX: 410-465-6644
www.bei-civilengineering.com

BUILDER: TOLL MD III LIMITED PARTNERSHIP
7164 COLUMBIA GATEWAY DRIVE
SUITE 230
COLUMBIA, MARYLAND 21046
410-872-9105

HOMEWOOD CROSSING PLOT PLAN LOT 36

4962 VALLEY VIEW OVERLOOK
TAX MAP 29, GRID 9 - PARCEL 28
3rd ELECTION DISTRICT
HOWARD COUNTY, MARYLAND

HOUSE TYPE: HENLEY
CAROLINA ELEVATION

DATE: MARCH 14, 2007 **PROJECT NO.** 1913
SCALE: 1" = 40' **DRAWING** 1 OF 1

PROBUILT
CONSTRUCTION, INC.

13453 Long Days Court
Highland MD 20777
ph. 301-854-0821
Fax 301-854-9632
www.probuiltconstruction.com
M.H.I.C. 20247

October 10, 2007

Ms. Avis Corbin
Department of Inspections, Licenses, and Permits
George Howard Building
3430 Court House Drive
Ellicott City, MD 21043
P. 410.313.2455
F. 410.313.3298

CK #	10813
CR #	123103
DATE #	10/10/07

Re: Revision to permit #B07003900, 4962 Valley view Overlook, Ellicott City, MD 21042.

Dear Ms. Corbin:

Per the request of Toll MD II Limited Partnership (the property owner at the above address), I would like to revise building permit number B07003900. It is currently for a 12'x18' deck with steps to grade, and the property owner is requesting to make it larger. The deck is going to increase to be an irregularly shaped deck measuring approx. 30'x68' (1,088 total square feet). It is also going to have an open gazebo on it (detached from home) and two sets of steps to grade as drawn on site plan.


If you have any questions about this project, please do not hesitate to contact me at 301.854.0821. Thank you for your time and consideration in this revision request.

Sincerely,



Edward Pacylowski
President, Pro-Built Construction, Inc.

OK Scotty 11/26/07

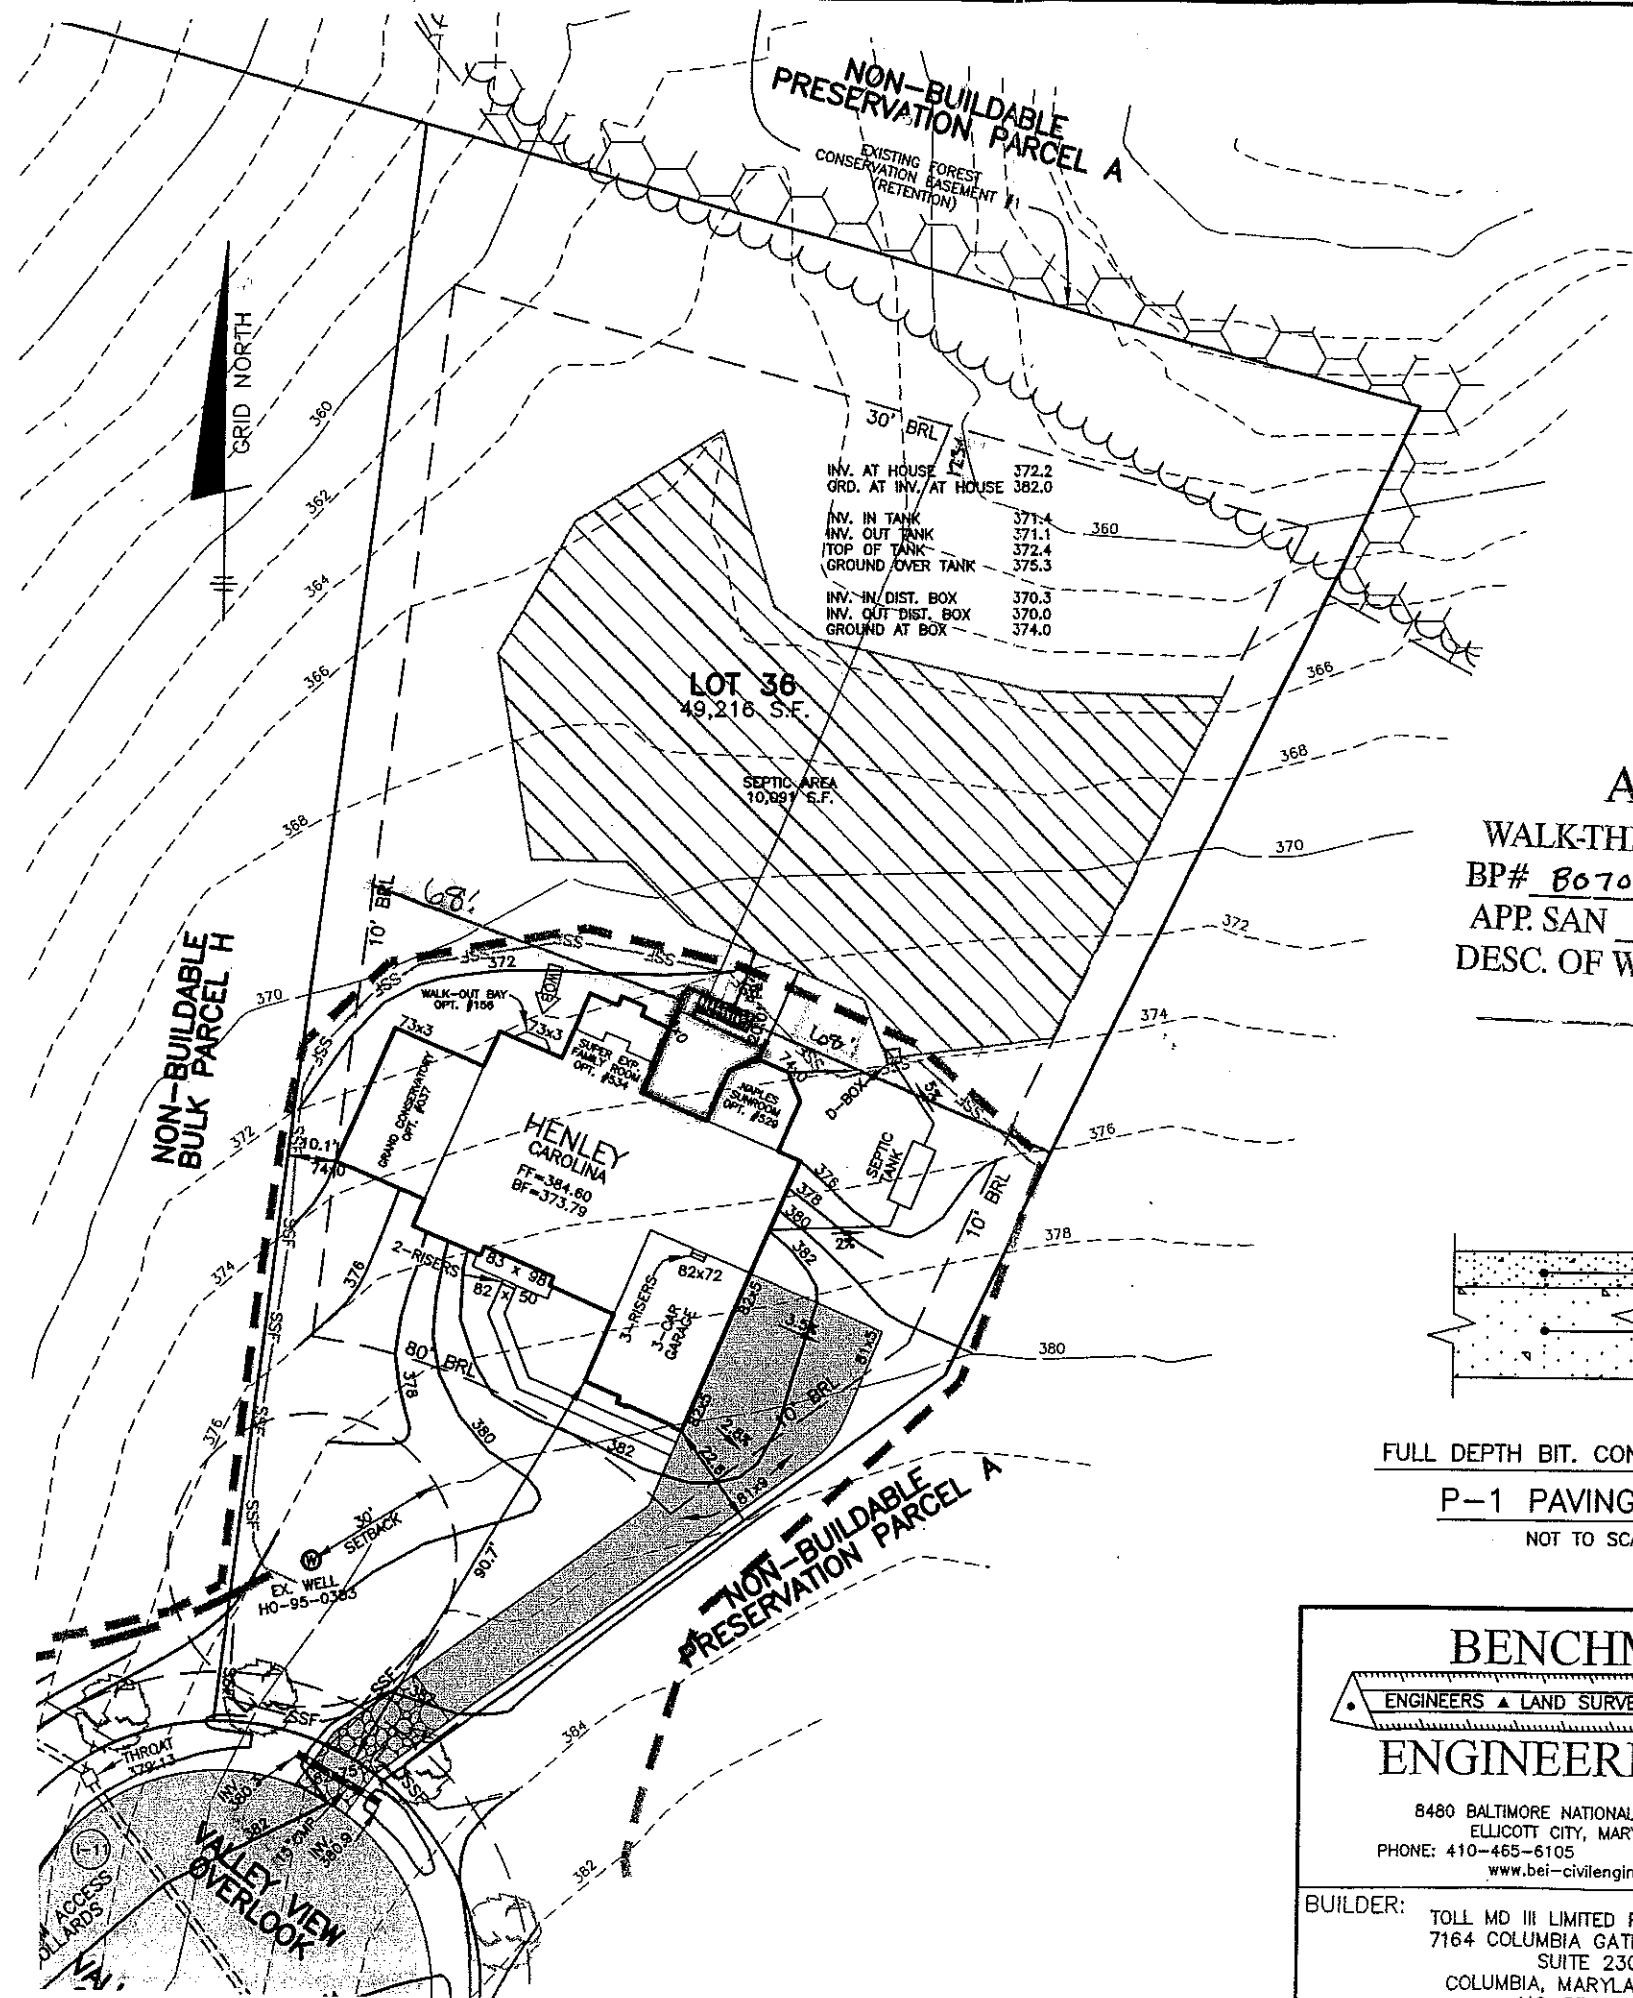

NOTES:

1. THE LOT SHOWN HEREON WAS RECORDED ON 12-13-05 AS PLAT NUMBER 17889. REFER TO THIS PLAT FOR LOT DIMENSIONS, LOT AREAS, ALL EASEMENTS AND BUILDING RESTRICTIONS.
2. THIS AREA DESIGNATES A PRIVATE SEWERAGE EASEMENT OF 10,000 SQUARE FEET AS REQUIRED BY THE STATE DEPARTMENT OF THE ENVIRONMENT FOR INDIVIDUAL SEWERAGE DISPOSAL. IMPROVEMENTS OF ANY NATURE IN THIS AREA IS RESTRICTED UNTIL PUBLIC SEWER IS AVAILABLE. THIS EASEMENT SHALL BECOME NULL AND VOID UPON CONNECTION TO A PUBLIC SEWERAGE SYSTEM. THE COUNTY HEALTH OFFICER SHALL HAVE THE AUTHORITY TO GRANT ADJUSTMENTS TO THE PRIVATE SEWERAGE EASEMENT. RECORDATION OF A MODIFIED SEWERAGE EASEMENT PLAT SHALL NOT BE NECESSARY.
3. EXACT LENGTH OF SEPTIC TRENCHES ARE BE DETERMINED BY THE HEALTH DEPARTMENT AT THE TIME OF PRECONSTRUCTION INSPECTION.
4. SPOIL FROM THE TRENCHING OF THE SEPTIC AREA IS TO BE PLACED ON THE UPHILL SIDE OF THE EXCAVATION FOR EACH INDIVIDUAL LOT.
5. SEDIMENT AND EROSION CONTROLS WERE APPROVED BY HOWARD SOIL CONSERVATION DISTRICT UNDER F-05-031 AND GP-06-94 AND SHALL COMPLY WITH THE 1994 MARYLAND STANDARDS AND SPECIFICATIONS FOR SOIL EROSION AND SEDIMENT CONTROL.
6. STORMWATER MANAGEMENT FOR THIS LOT WAS PROVIDED UNDER F-05-031.
7. THE EXISTING WELL (TAG NO. HO-95-0353) SHOWN ON THIS PLAN HAS BEEN FIELD LOCATED BY BENCHMARK ENGINEERING, INC. ON 9-7-06 AND IS ACCURATELY SHOWN.
8. DRIVEWAY CULVERT COMPUTATIONS HAVE BEEN PROVIDED WITH THIS BUILDING PERMIT PLOT PLAN. THE CULVERT SHALL BE 15" CMP OR ELLIPTICAL EQUIVALENT.

APPROVED

WALK-THRU BUILDING PERMIT

BP# B07003900 A# 515042-JJ

APP. SAN SFD DATE: 9/19/07

DESC. OF WORK: 21' x 18' Deck

LEGEND

- EXISTING CONTOURS ESTABLISHED UNDER F-05-031
 - FIELD SURVEYED WELL LOCATION
 - STREET TREES INSTALLED UNDER F-05-031
 - INDICATES WALK-OUT BASEMENT LOCATION
 - STABILIZED CONSTRUCTION ENTRANCE INSTALLED UNDER GP-06-94
 - SUPER SILT FENCE INSTALLED UNDER F-05-031
 - SUPER SILT FENCE INSTALLED UNDER GP-06-94
 - SILT FENCE INSTALLED UNDER F-05-031
 - LIMIT OF DISTURBANCE UNDER F-05-031
- 1" BITUMINOUS CONCRETE SURFACE
3" BITUMINOUS CONCRETE BASE
- FULL DEPTH BIT. CONC. ALTERNATIVE
P-1 PAVING DETAIL
NOT TO SCALE

BENCHMARK
ENGINEERS • LAND SURVEYORS • PLANNERS
ENGINEERING, INC.
8480 BALTIMORE NATIONAL PIKE • SUITE 418
ELLICOTT CITY, MARYLAND 21043
PHONE: 410-465-6105 FAX: 410-465-6644
www.bei-civilengineering.com

BUILDER: TOLL MD III LIMITED PARTNERSHIP
7164 COLUMBIA GATEWAY DRIVE
SUITE 230
COLUMBIA, MARYLAND 21046
410-872-9105

**HOMEWOOD CROSSING
PLOT PLAN
LOT 36**

4962 VALLEY VIEW OVERLOOK
TAX MAP 29, GRID 9 - PARCEL 28
3rd ELECTION DISTRICT
HOWARD COUNTY, MARYLAND

HOUSE TYPE: **HENLEY
CAROLINA ELEVATION**

DATE: MARCH 14, 2007	PROJECT NO. 1913
SCALE: 1" = 40'	DRAWING 1 OF 1