

APPLICATION

PERCOLATION TESTING

A 36984

P _____

HOWARD COUNTY HEALTH DEPARTMENT
BUREAU OF ENVIRONMENTAL HEALTH
P.O. BOX 476 ELLICOTT CITY, MARYLAND 21043
TELEPHONE: 461-9933

DISTRICT 5

DATE 5/15/86

TO: THE COUNTY HEALTH OFFICER
ELLICOTT CITY, MARYLAND

I HEREBY APPLY FOR THE NECESSARY TEST IN ORDER TO CONSTRUCT (OR RECONSTRUCT) A SEWAGE DISPOSAL SYSTEM.

PROPERTY OWNER Wayback Corporation

ADDRESS P.O. Box 1018, Columbia, MD. 21044 PHONE 997-8800

PROSPECTIVE BUYER NONE

ADDRESS _____ PHONE _____

PROPERTY LOCATION:


SUBDIVISION The Chase - formerly The Paddock LOT NO. 8

ROAD AND DESCRIPTION Homewood Road

TAX MAP 29 PARCEL # 24

SIZE OF LOT 3 acres TYPE BLDG. S.F.D.
(SINGLE FAMILY DWELLING OR COMMERCIAL)

THE SYSTEM INSTALLED UNDER THIS APPLICATION IS ACCEPTABLE ONLY UNTIL PUBLIC FACILITIES BECOME AVAILABLE. I FULLY UNDERSTAND THE FEE CONNECTED WITH THE FILING OF THIS PERC TEST APPLICATION IS NON-REFUNDABLE UNDER ANY CIRCUMSTANCES. I ALSO AGREE TO COMPLY WITH ALL M.O.S.H.A. REQUIREMENTS IN TESTING THIS LOT.

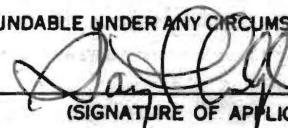
(SIGNATURE OF APPLICANT)

APPROVED BY Sid Abel FOR Shallow tel. fields DATE 1-2-87

REJECTED BY _____ FOR _____ DATE _____

HOLD PENDING FURTHER TESTS _____ DATE _____


REASONS FOR REJECTION OR HOLDING 6/24/86 Perc. Satisfactory Hold for Subdivision Permit, Shallow Syst. only. S. Abel

THIS IS NOT A PERMIT

① ⑤
SOIL PROFILE

0'
4"
3'
12'

A-1-3
RED YELLOW SAND LOAM 9-12% CLAY <10% FRAGMENTS
STRONG BR SAND SILT LOAM <10% FRAGMENTS

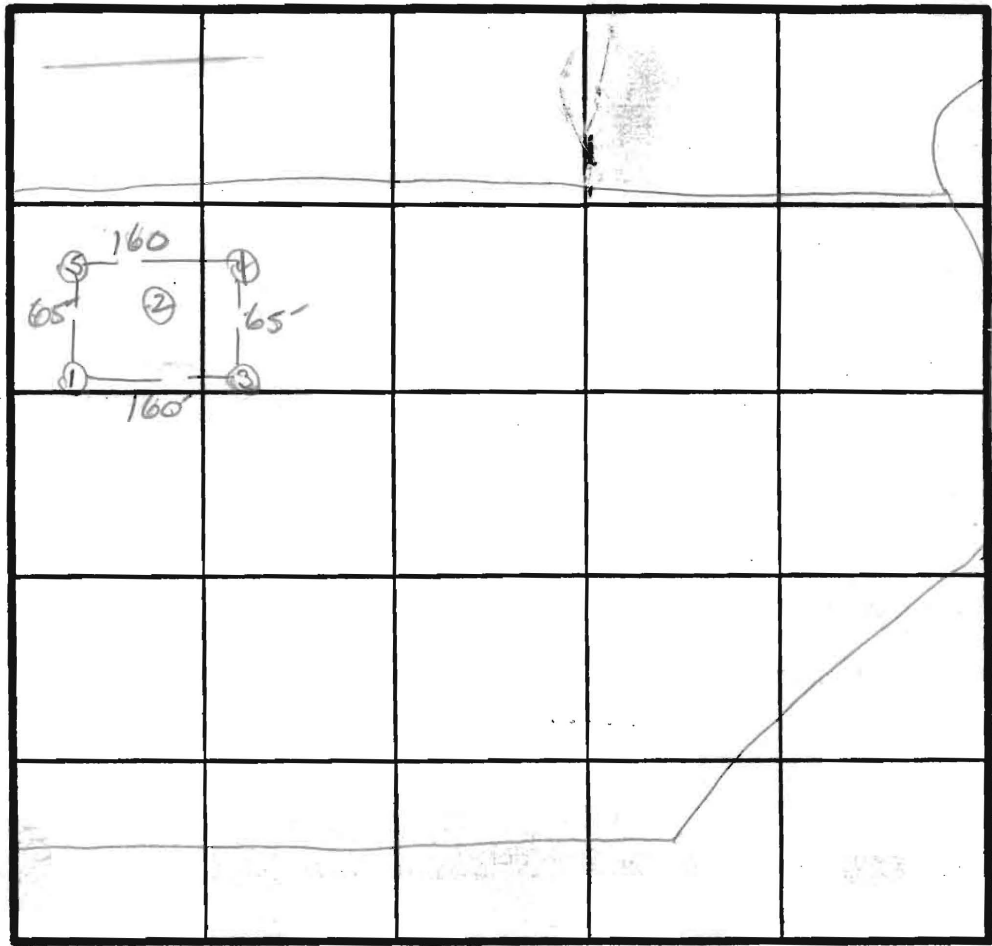

COUNT
ROAD B
X PERC 3 MIN
INLET 3.5'
BOTTOM 5.0'
180 Φ / BR

INDICATE NORTH - NAME ADJOINING ROADWAY AS BASE LINE.
Hampwoods Rd.

② ③ ④
4"
3'
10'

A-1-3
YELLOW BR SAND LOAM 2% CLAY <10% FRAG
YELLOW BR TO STRONG BR w/oleprr SAND LOAM <10% FRAGMENTS

DATE	TEST NO.	DEPTH	PRE-WET		TEST - 1" DROP		TIME	
			START	STOP	START	STOP		
4/24/86	1 S V	4.5" 12"	11:25	11:26	11:26	11:27	1 min	
	2 V	10"	UNIFORM SOIL Below 3" ROCK BOTTOM - UNIFORM SAND LOAM 3-10"					
	3 S M	3.5" 6"	11:28	11:29	11:29	11:31	2 min	
			11:32	11:33	11:33	11:36	3 min	
	3 V	same as hole 3 w/ROCK AT 11.5"						
	4 V	same as hole 2+4 w/ROCK AT 11.5-12"						
	5 S V	3.5" 13"	11:38	11:40	11:40	11:43	3 min	
			UNIFORM Below 3" same as #1					

REMARKS Hole Dug Per PLAT / Shallow System only

TYPE OF SOIL S. Abel Jeff

