

11/14/67
Randy

PERMIT

SEWAGE DISPOSAL SYSTEM

MARYLAND STATE DEPARTMENT OF HEALTH

HOWARD COUNTY

ELLICOTT CITY

DISTRICT 3

DATE 10/6/67

INDEXED

03-290409

P 15144

A 12798

A515240-C

Walter A. Shank

IS PERMITTED TO INSTALL X ALTER

ADDRESS Folly Quarter Rd., Ellicott City, Md. PHONE 531-5631

A SEWAGE DISPOSAL SYSTEM LOCATED AT _____

SUBDIVISION _____ ROAD 3921 Walt Ann Drive

Old Rolling Rd. - 1st LOT a

dirt road on right after entering Shepherd's
Glen

PROPERTY OWNER Walter A. Shank

ADDRESS Ludicke

SPECIFICATIONS - 4 bedrooms

DRAIN FIELD _____ DEPTH _____ FEET, BOTTOM AREA _____ SQ. FT.

SEEPAGE PITS _____ ABSORBENT SIDE-WALL AREA _____ SQ. FT.

SEPTIC TANK CAPACITY 1,000 GALLONS

FOR GARBAGE GRINDER, INCREASE DISPOSAL AREA 22% & TANK CAPACITY 80%.

OTHER Dry well - 400 sq. ft. sidewall area below inlet with a maximum depth
of 10 ft. OR Tile field with 400 sq. ft. bottom area installed no deeper than 5 ft.
below grade.

If dry well used place it 270 ft. from the back lot line and 160 ft. from the right
side of the lot as seen when facing the lot from Old Rolling Rd. If tile field
used place it 250 ft. to 340 ft. from the back lot line and 150 ft. to 175 ft.
from the right side of the lot as seen when facing the lot from Folly Quarter Road.

PERMIT VOID AFTER THREE YEARS.

PLANS APPROVED BY Raymond Hodges DATE 7/6/67

FILL SEPTIC TANK AND DISTRIBUTION BOX WITH WATER BEFORE CALLING FOR AN INSPECTION. COVER NO WORK
UNTIL INSPECTED AND APPROVED.

NEITHER THE HOWARD COUNTY COMMISSIONERS NOR THE HEALTH DEPARTMENT IS RESPONSIBLE FOR THE
SUCCESSFUL OPERATION OF ANY SYSTEM.

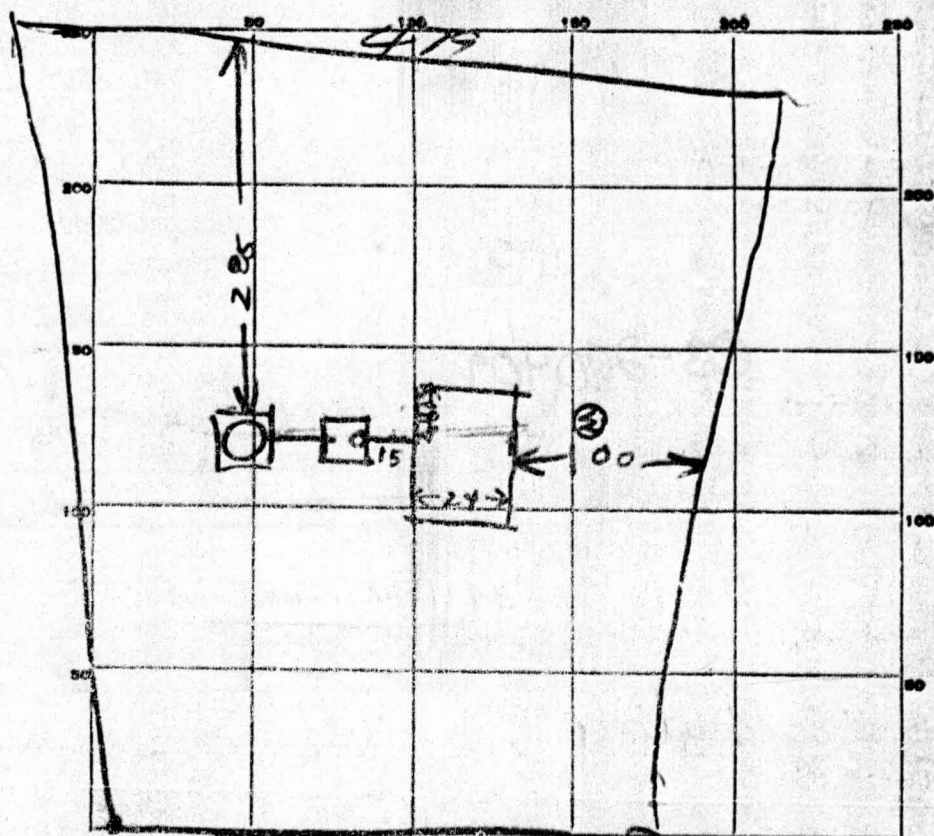
SEAL PERMIT SIGNED
AND RETURNED 3/21/2001

800 129 094 WOODSHED

NOTIFY THE HEALTH DEPARTMENT 48 HOURS
BEFORE EXCAVATIONS ARE TO BE BACK FILLED.

A 12798

A515240-C

**PERMIT CARD**

0/1000 சென்னை

DISTRIBUTION BOX, LEVEL

GRAVEL DEPTH _____ IN. TOTAL LENGTH _____ FT.

NUMBER OF TRENCHES _____ TOTAL BOTTOM AREA _____

SEEPAGE PITS, INSIDE DIAMETER 12 FT. DEPTH BELOW INLET 92 FT.

ABSORBENT AREA 351 SQ. FT. not counting stone

REMARKS

REMARKS: Day Well inlet is 3' 7" to 5' 7" below grade.
Depth below grade is 12' 5"

Perimeter of Hole is 52 FT 495 sq ft

Told well diller log out well Arthur Edmonson
Furnburg Route # 2

DATE SYSTEM APPROVED

INSPECTOR

R. Hodge