

Well tag # Ho-94-1224

APPLICATION

PERCOLATION TESTING

A 43327

P _____

HOWARD COUNTY HEALTH DEPARTMENT
BUREAU OF ENVIRONMENTAL HEALTH
P.O. BOX 476 ELLICOTT CITY, MARYLAND 21043
TELEPHONE: 461-9933

DISTRICT 4TH

DATE 1-4-89

TO: THE COUNTY HEALTH OFFICER
ELLICOTT CITY, MARYLAND

I HEREBY APPLY FOR THE NECESSARY TEST IN ORDER TO CONSTRUCT (OR RECONSTRUCT) A SEWAGE DISPOSAL SYSTEM.

PROPERTY OWNER Nelvon M. Watkins

ADDRESS 26311 Howard Chapel Road PHONE (301) 859-0563
Damscas, MD 20878

PROSPECTIVE BUYER Standard Management Corporation

ADDRESS 10324-B Baltimore National Pike PHONE (301) 461-6777
Ellicott City, MD 21043

PROPERTY LOCATION:

SUBDIVISION Pleasant Hills LOT NO. # 12 on final

ROAD AND DESCRIPTION Off of Long Corner Road

TAX MAP 12 PARCEL # 5

SIZE OF LOT 3.43 Ac. TYPE BLDG. Single Family
(SINGLE FAMILY DWELLING OR COMMERCIAL)

THE SYSTEM INSTALLED UNDER THIS APPLICATION IS ACCEPTABLE ONLY UNTIL PUBLIC FACILITIES BECOME AVAILABLE. I FULLY UNDERSTAND THE FEE CONNECTED WITH THE FILING OF THIS PERC TEST APPLICATION IS NON-REFUNDABLE UNDER ANY CIRCUMSTANCES. I ALSO AGREE TO COMPLY WITH ALL M.O.S.H.A. REQUIREMENTS IN TESTING THIS LOT.

Ford K...
(SIGNATURE OF APPLICANT)

APPROVED BY _____ FOR _____ DATE _____

REJECTED BY _____ FOR _____ DATE _____

HOLD PENDING FURTHER TESTS _____ DATE _____

REASONS FOR REJECTION OR HOLDING 1-27-89 Perc Satisfactory hold for Subst plan. sub

HD-216

THIS IS NOT A PERMIT

A-43327


(C)
SOIL PROFILE

AD

8'1" Brown yellow silty clay loam 15-20% Chato frag

3.5' Blown to yellow silty loam 20-30% Frag

13'

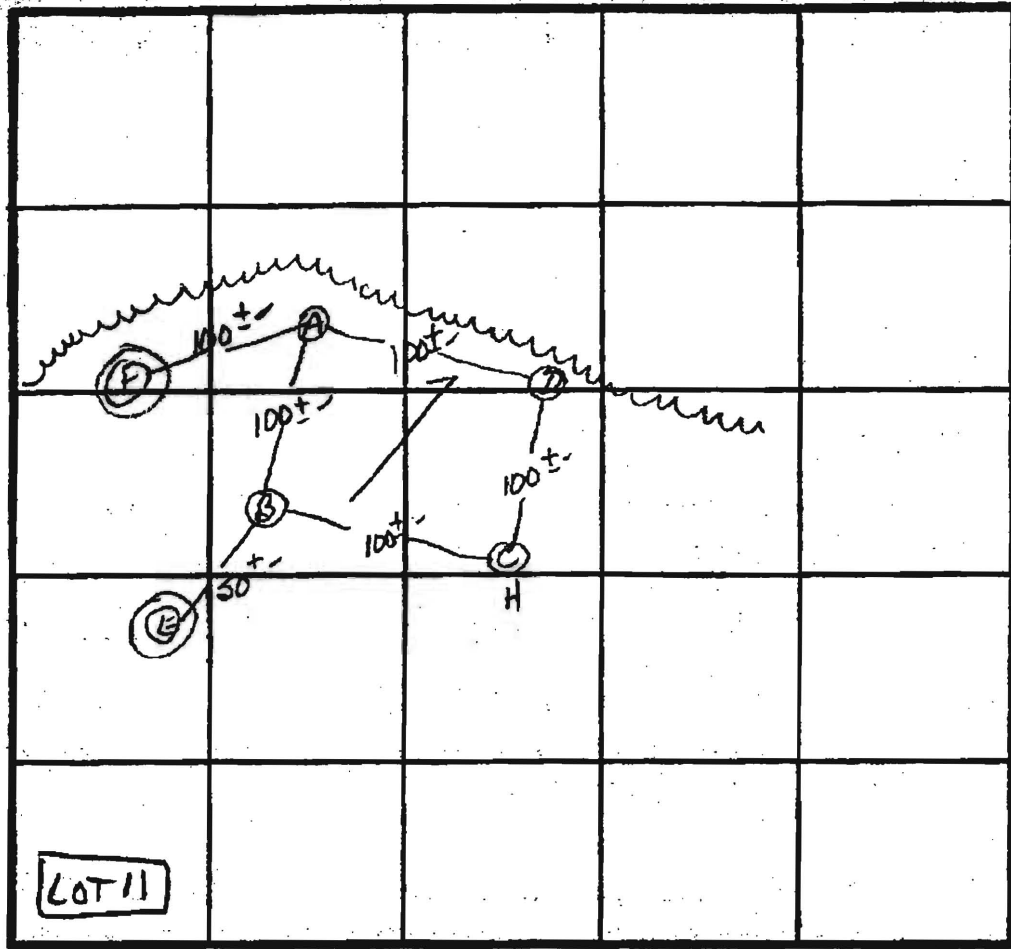

X Perc 8mi
210φ16R
Inlet 3.0'
Bottom 4.5'

INDICATE NORTH - NAME ADJOINING ROADWAY AS BASE LINE.

LONG CORNER Rd.

DATE	TEST NO.	DEPTH	PRE-WET		TEST - 1" DROP		TIME
			START	STOP	START	STOP	
1/27/89	C S	3.5'	9:47	9:50	9:50	9:54	4min
		8.0'	9:47	9:52	9:52	10:07	10min
	CV	13'	As profiled				
	D S	3.5'	9:48	9:56	9:56	10:05	4min
	D V	11.5'	Reheat at 11.5'		Frag 40% at 11'		
	A S	4.0'	9:54	9:57	9:57	10:05	8min
	A V	12.5'	Similar to profile w/less frag				
	B S	5.0'	10:00	10:04	10:04	10:13	9min
	B V	12'	SAMP AS D				
	X EV	Refusal 5'					
	X FV	Refusal 5'					
	E						

REMARKS Perced AS STAKE AND APPROX PLAT

TYPE OF SOIL Mt Airy

TESTED BY S. Abel

ALSO PRESENT JACK F. ROEHL, Jeff M.

