

APPLICATION

PERCOLATION TESTING

A 58096

HOWARD COUNTY HEALTH DEPARTMENT
BUREAU OF ENVIRONMENTAL HEALTH

3525-H ELLICOTT MILLS DRIVE/ELLICOTT CITY, MARYLAND 21043
TELEPHONE: 313-2640

TO: THE COUNTY HEALTH OFFICER
ELLICOTT CITY, MARYLAND

PREVIOUS OK -
PROPOSED RECONFIGURATION
OF MULTIPLE PARCEL FARM
TREAT AS SUBDIVISION;
POST-TEST REVIEW SHOULD
INCLUDE CONSIDERATION
OF PREVIOUS (1976?)
TEST HISTORY ON THIS FARM (CW)

DISTRICT _____

DATE _____

I HEREBY APPLY FOR THE NECESSARY TEST PRIOR TO APPLICATION FOR PERMIT TO CONSTRUCT (OR RECONSTRUCT) A SEWAGE DISPOSAL SYSTEM.

PROPERTY OWNER D. Starn

ADDRESS West Waverly

PHONE _____

AGENT OR PROSPECTIVE BUYER C. Sharp

ADDRESS 3779 Sharp Rd Glenwood

PHONE 410 4894630

PROPERTY LOCATION:

SUBDIVISION STIRN

LOT NO. (1)

ROAD AND DESCRIPTION Old Frederick Rd.

TAX MAP 2

PARCEL # 180

AB parcel

SIZE OF LOT 1.21 to 3 ac.

TYPE BLDG. _____

(SINGLE FAMILY DWELLING OR COMMERCIAL)

THE SYSTEM INSTALLED UNDER THIS APPLICATION IS ACCEPTABLE ONLY UNTIL PUBLIC FACILITIES BECOME AVAILABLE. I FULLY UNDERSTAND THE FEE CONNECTED WITH THE FILING OF THIS PERC TEST APPLICATION IS NON-REFUNDABLE UNDER ANY CIRCUMSTANCES. I ALSO AGREE TO COMPLY WITH ALL M.O.S.H.A. REQUIREMENTS IN TESTING THIS LOT. Charles Sharp

(SIGNATURE OF APPLICANT)

APPROVED BY _____

FOR _____

DATE _____

DISAPPROVED BY _____

FOR _____

DATE _____

HOLD PENDING FURTHER TESTS _____

REASONS FOR REJECTION OR HOLDING _____

PERCOLATION TEST PLAT/PRELIMINARY PLAT - TITLE OR I.D. # _____

DATE _____

SITE DEVELOPMENT PLAN/FINAL PLAT - TITLE OR I.D. # _____

DATE _____

THIS IS NOT A PERMIT

58096

COUNTY #


SOIL PROFILE

(E)

0' topsoil
 1' org brn
 cl lm
 5' pale
 3' org brn
 to lt
 8' org wh
 si sa lm
 5' Rx patch
 15-20%
 Rx
 5'


SOIL PROFILE

0'

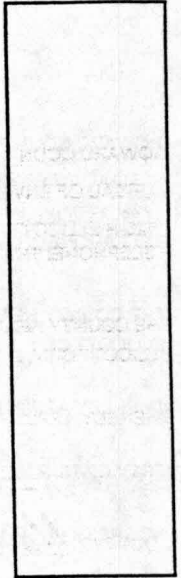

0' (F)
 1' topsoil
 org brn
 cl lm
 5' pale
 3' org brn
 si sa
 lm
 5' >50%
 Rx
 11'

0' G/H
 1' topsoil
 org red
 brn
 cl lm
 pale org
 brn
 si sa lm
 5' >50%
 Rx

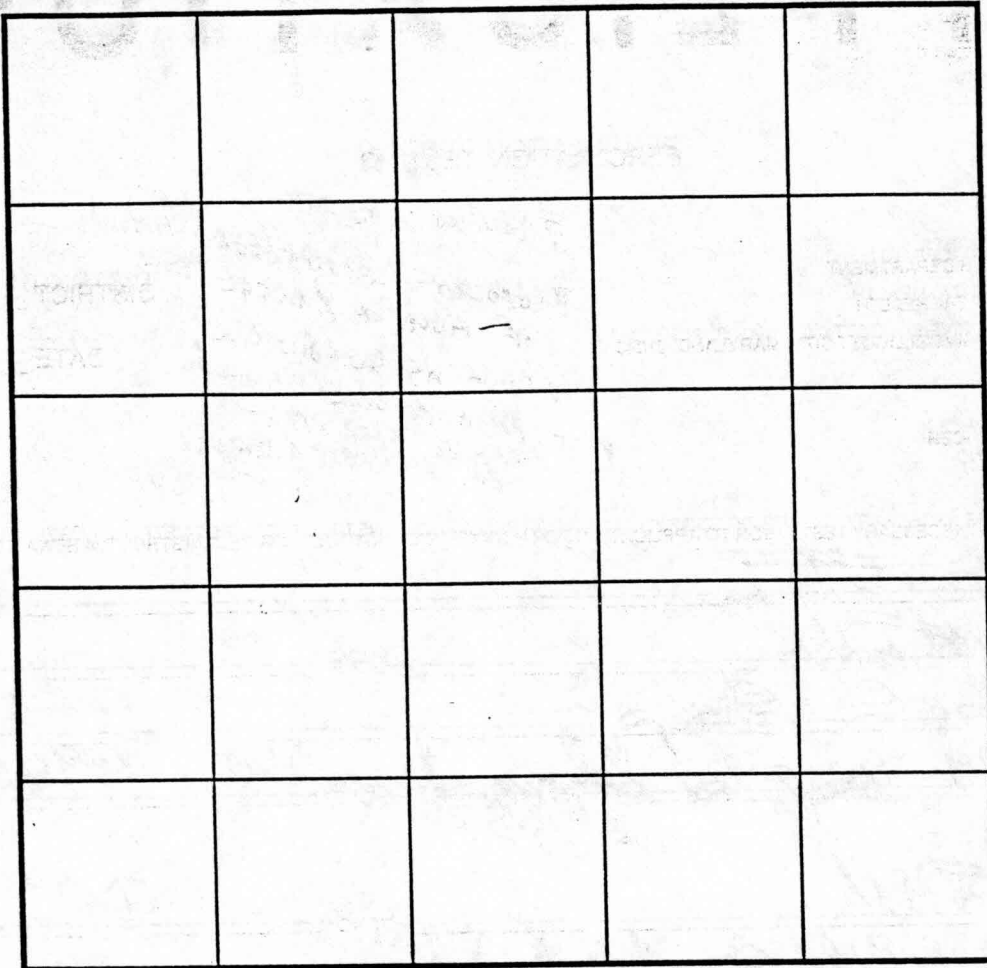

INDICATE NORTH - NAME ADJOINING ROADWAY AS BASE LINE.

DATE	TEST NO.	DEPTH	PRE-WET		TEST - 1" DROP		TIME
			START	STOP	START	STOP	
6-4-97	E	4.0'S	10:58 ₃	11:00	11:00	11:03	3
		11.5'D	Visual	OK			
	F	3.5'S	11:07 ₃	11:09	11:09	11:11	2
		11.0'D	Visual	OK			
	G	10'8"D	Insuff depth to bedrock				F
	H	10.0'D	"	"	"	"	F

REMARKS

TYPE OF SOIL

TESTED BY D. Soc

ALSO PRESENT C Sharp

TRENCH DESIGN DATA: AVERAGE PERCOLATION TIME

TRENCH WIDTH

APPLICATION

PERCOLATION TESTING

A 58096

HOWARD COUNTY HEALTH DEPARTMENT
BUREAU OF ENVIRONMENTAL HEALTH
3525-H ELLICOTT MILLS DRIVE/ELLICOTT CITY, MARYLAND 21043
TELEPHONE: 313-2640

PREVIEW OK -
PROPOSED RECONFIGURATION
OF MULTIPLE PARCEL FARM
THAT AS SUBDIVISION;
POST-TEST REVIEW SHOULD
INCLUDE CONSIDERATION
OF PREVIOUS (1976?)
TEST HISTORY ON THIS FARM (CW)

P _____

DISTRICT _____

DATE _____

TO: THE COUNTY HEALTH OFFICER
ELLICOTT CITY, MARYLAND

I HEREBY APPLY FOR THE NECESSARY TEST PRIOR TO APPLICATION FOR PERMIT TO CONSTRUCT (OR RECONSTRUCT) A SEWAGE DISPOSAL SYSTEM.

PROPERTY OWNER D. Storn

ADDRESS West Waterville PHONE _____

AGENT OR PROSPECTIVE BUYER C. Sharp

ADDRESS 3779 Sharp Rd Glenwood PHONE 410 4894630
21738

PROPERTY LOCATION:

SUBDIVISION STIRN LOT NO. (1)

ROAD AND DESCRIPTION Old Frederick Rd.

TAX MAP 2 PARCEL # 180 (B parcel)

SIZE OF LOT 1.21 To 3 acs TYPE BLDG. _____

(SINGLE FAMILY DWELLING OR COMMERCIAL)

THE SYSTEM INSTALLED UNDER THIS APPLICATION IS ACCEPTABLE ONLY UNTIL PUBLIC FACILITIES BECOME AVAILABLE. I FULLY UNDERSTAND THE FEE CONNECTED WITH THE FILING OF THIS PERC TEST APPLICATION IS NON-REFUNDABLE UNDER ANY CIRCUMSTANCES. I ALSO AGREE TO COMPLY WITH ALL M.O.S.H.A. REQUIREMENTS IN TESTING THIS LOT.

Charles L. Sharp
(SIGNATURE OF APPLICANT)

APPROVED BY _____ FOR _____ DATE _____

DISAPPROVED BY _____ FOR _____ DATE _____

HOLD PENDING FURTHER TESTS _____

REASONS FOR REJECTION OR HOLDING _____

PERCOLATION TEST PLAT/PRELIMINARY PLAT - TITLE OR I.D. # _____ DATE _____

SITE DEVELOPMENT PLAN/FINAL PLAT - TITLE OR I.D. # _____ DATE _____

THIS IS NOT A PERMIT

580910


COUNTY #

SOIL PROFILE

0' 1' topsoil
red org
brn
cl 1m
5' 14 org
brn
to tan
si 1m
30%
shale
frag

0' 1' topsoil
org brn
cl 1m
2' 14 org
brn
si 1m
25%
frag

0' 1' topsoil
org brn
cl 1m
14 org
brn
to beige
si 1m
20%
frag

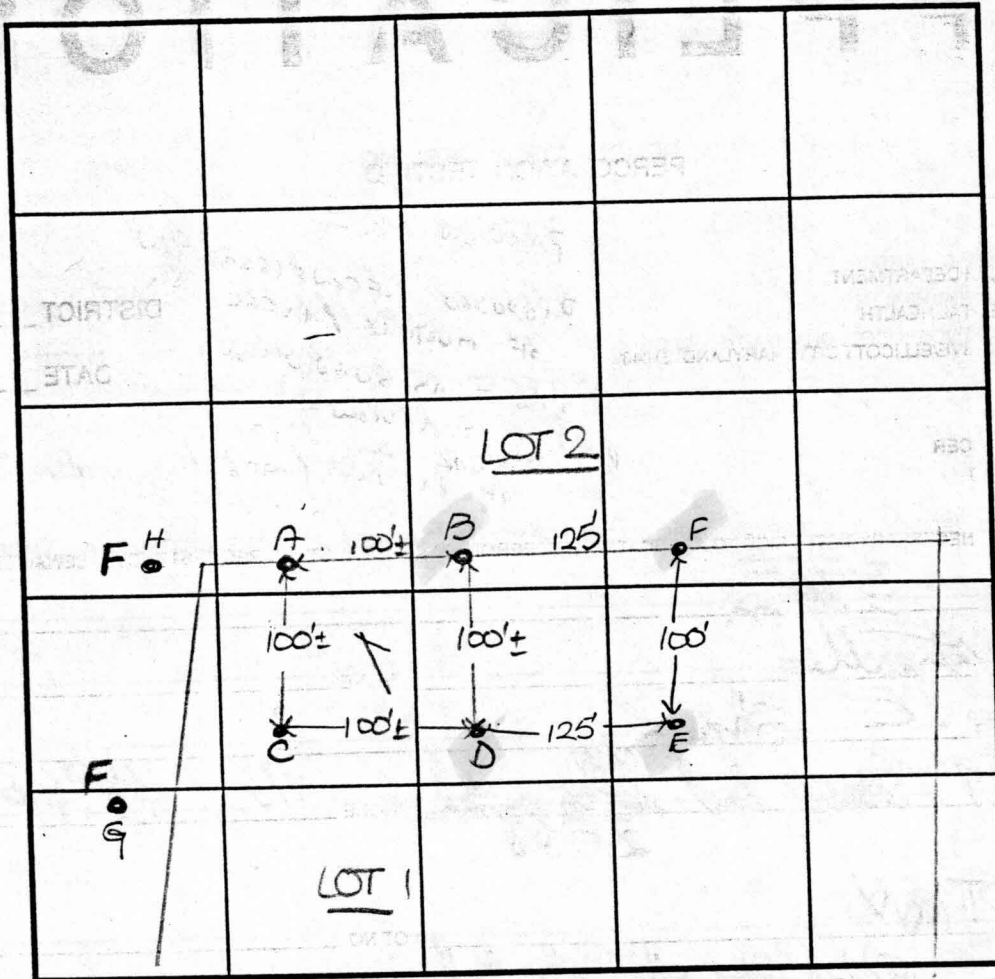

SOIL PROFILE

0' 1' topsoil
red org
brn
cl 1m
3' 14 med red
brn
si 1m
20%
frag

INDICATE NORTH - NAME ADJOINING ROADWAY AS BASE LINE.

West Waterville Road

DATE	TEST NO.	DEPTH	PRE-WET		TEST - 1" DROP		TIME
			START	STOP	START	STOP	
5-2-97	A	3' 4" S	10:40 ₃	10:41 ₃	10:41 ₃	10:43 ₃	2
		7.5' M	10:44	11:04	11:04	11:27	23
		12.0' D	Visual	OK			
	B	3' 4" S	10:52 ₃	10:53 ₃	10:53 ₃	10:55 ₃	~2
		10.0' D	Visual	OK			
	C	5.0' S	11:02	11:12	11:12	11:28	16
		12.5' D	Visual	OK			
	D	4' 2" S	10:57 ₃	10:59	10:59	11:01	2
		11.5' D	Visual	OK			

REMARKS: holes tested as staked

TYPE OF SOIL

TESTED BY: D. See

ALSO PRESENT

C. Sharp

TRENCH DESIGN DATA: AVERAGE PERCOLATION TIME

9

TRENCH WIDTH

3

MAXIMUM BOTTOM DEPTH

4.5

SQ FT/BEDROOM

210

CHARLES ALAN SHARP
and
DENISE DOERER SHARP
Liber 4252 Folio 208
52,500 sq. ft.
or
1.2052 Acres

