


Site Plan  
 Lot 2  
 Lower Trail  
 Lisbon Sage

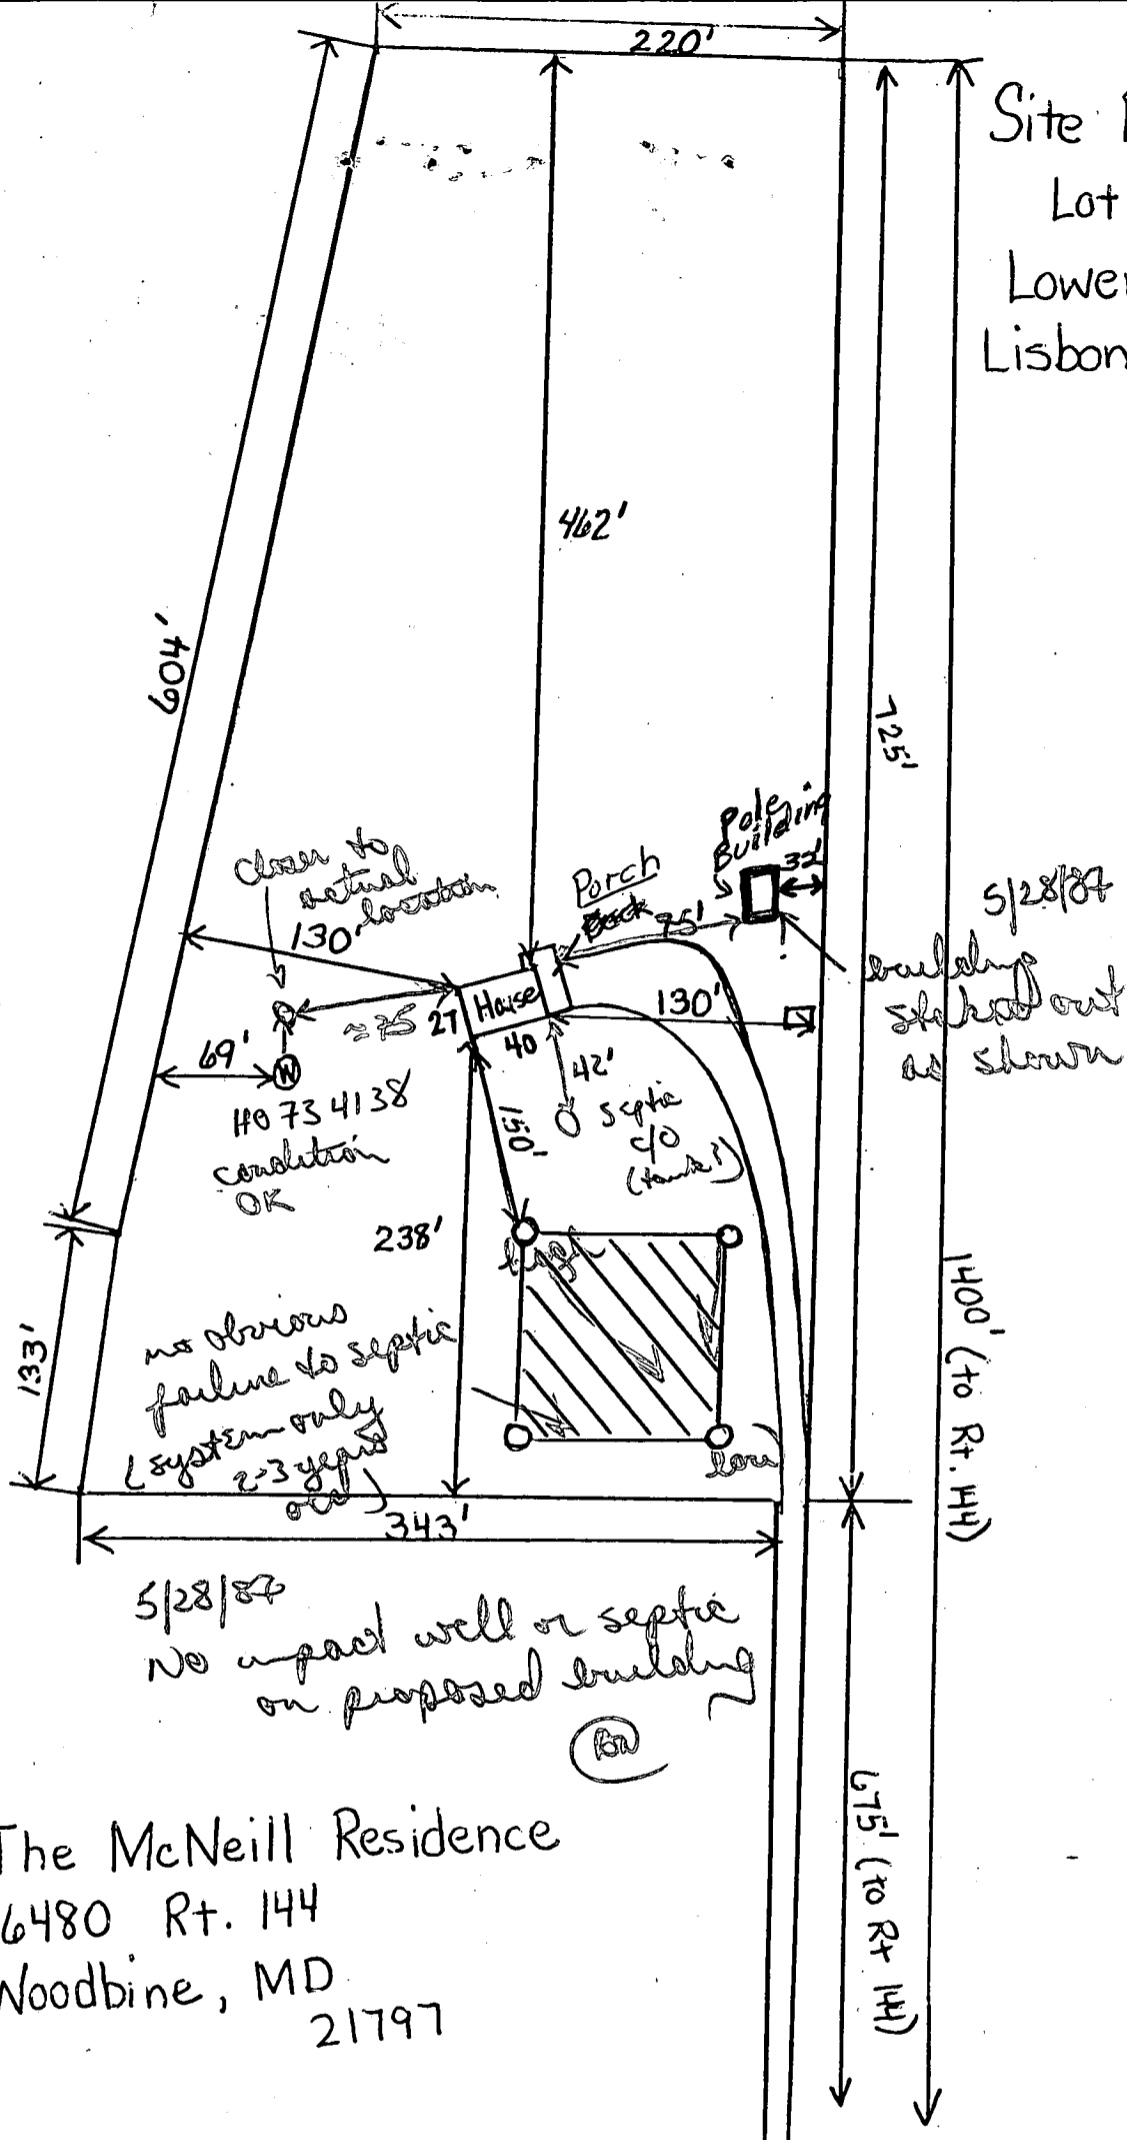

The McNeill Residence  
 16480 Rt. 144  
 Woodbine, MD  
 21797