

Viking Dec. 1
driver
like MD
colon

SEPTIC SYSTEM DATA

INV. AT HOUSE 739.7

SEPTIC TANK


EX. GRADE 742.3
FIN. GRADE 742.3
INV. IN 739.3
INV. OUT 739.0

DISTRIBUTION BOX

EX. GRADE 733.5
FIN. GRADE 733.5
INV. IN 731.8
INV. OUT 731.6

TRENCHES

	#1	#2	#3
EX. GRADE	733.5	733.0	732.5
FIN. GRADE	733.5	733.0	732.5
INV. IN	731.5	731.0	730.5
BOTTOM LENGTH	50	85	65

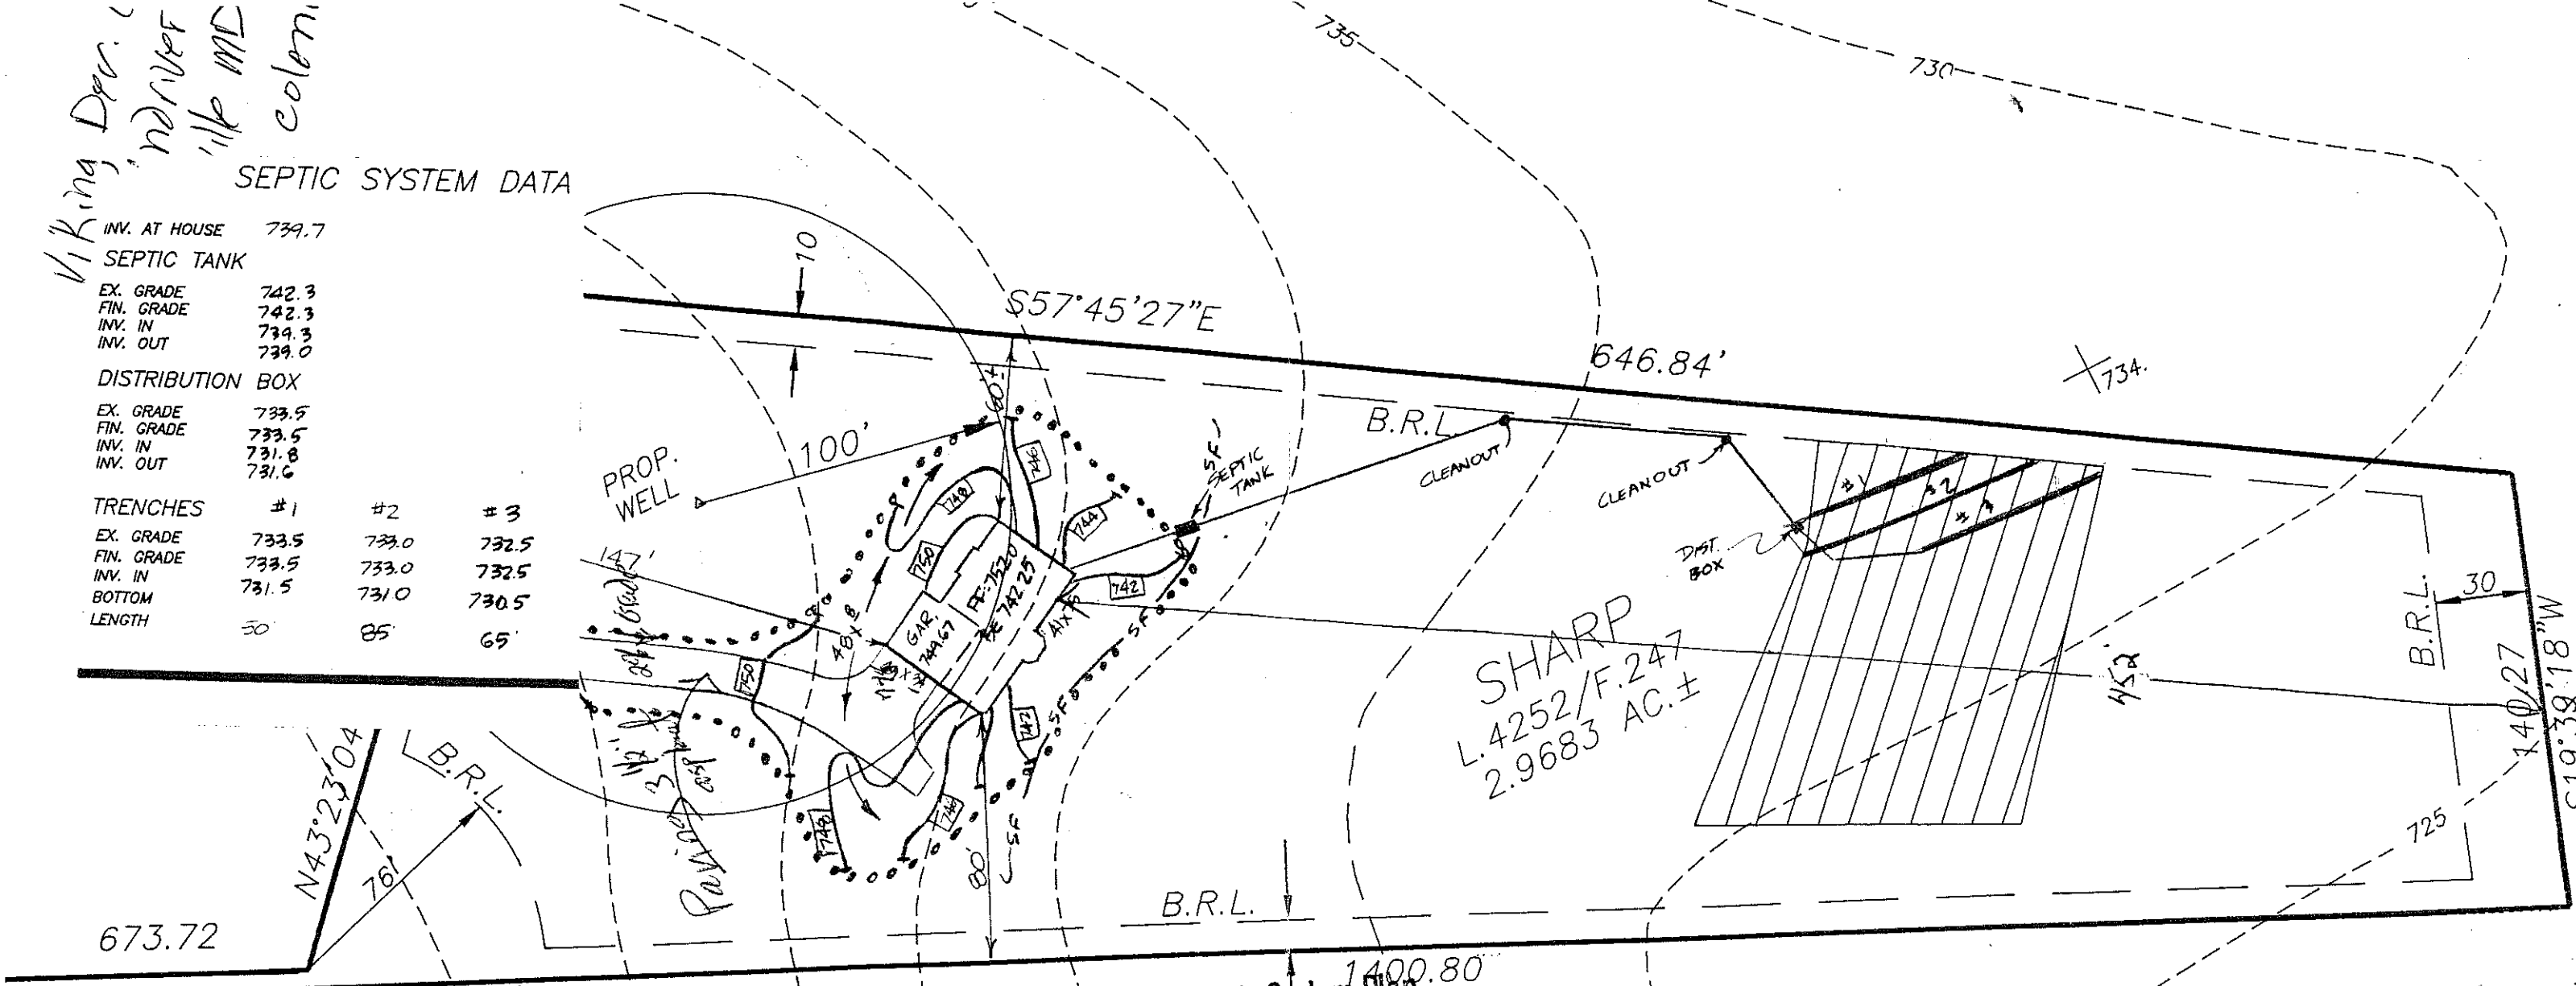

673.72

N65°05'37"W

width of trench(es) 3.0 feet
depth of trench(es) 4.0 feet
depth of stone required below distribution pipe 2.0 feet

280' of TRENCH REQUIRED

Approved Septic System Plan
Howard County Health Department

[Signature] Date 4/7/01

REvised
Date: 5-15-01
Comments: 4-97
West watersville Rd
B00130070
Revised location


SHANABERGER & LANE
8726 TOWN & COUNTRY BLVD.
SUITE 201
ELLICOTT CITY, MD. 21043
PHONE: 410-461-9563
FAX: 410-461-9693

NOTES:

1. THE TOPOGRAPHY SHOWN HEREON IS TAKEN FROM HOWARD COUNTY 1"=200' AERIAL PHOTOGRAMMETRY.
2. B.R.L. DESIGNATES BUILDING RESTRICTION LINE
- DESIGNATES LIMIT OF DISTURBANCE
- ① DESIGNATES APPROVED PERC TEST
3. THIS AREA DESIGNATES A PROPOSED REVISED PRIVATE SEWAGE EASEMENT AS REQUIRED BY THE MARYLAND STATE DEPARTMENT OF THE ENVIRONMENT FOR INDIVIDUAL SEWAGE DISPOSAL IMPROVEMENTS OF ANY NATURE IN THIS AREA ARE RESTRICTED UNTIL PUBLIC SEWAGE IS AVAILABLE. THESE EASEMENTS SHALL BECOME NULL AND VOID UPON CONNECTION TO A PUBLIC SEWAGE SYSTEM. THE COUNTY HEALTH OFFICER SHALL HAVE THE AUTHORITY TO GRANT VARIANCES FOR ENCROACHMENTS INTO THE PRIVATE SEWAGE EASEMENT. RECORDATION OF A MODIFIED SEWAGE EASEMENT SHALL NOT BE NECESSARY. THERE IS A 10,000 S.F. MINIMUM RESTRICTION ON THE SEWAGE EASEMENT.
4. TOTAL AREA DISTURBED: 14,503 S.F.
5. SEWER SERVICE TO BASEMENT IS AVAILABLE.

BPH#0013256
11/19/01

11/19/01-
propane tank
location OK
(SRM)

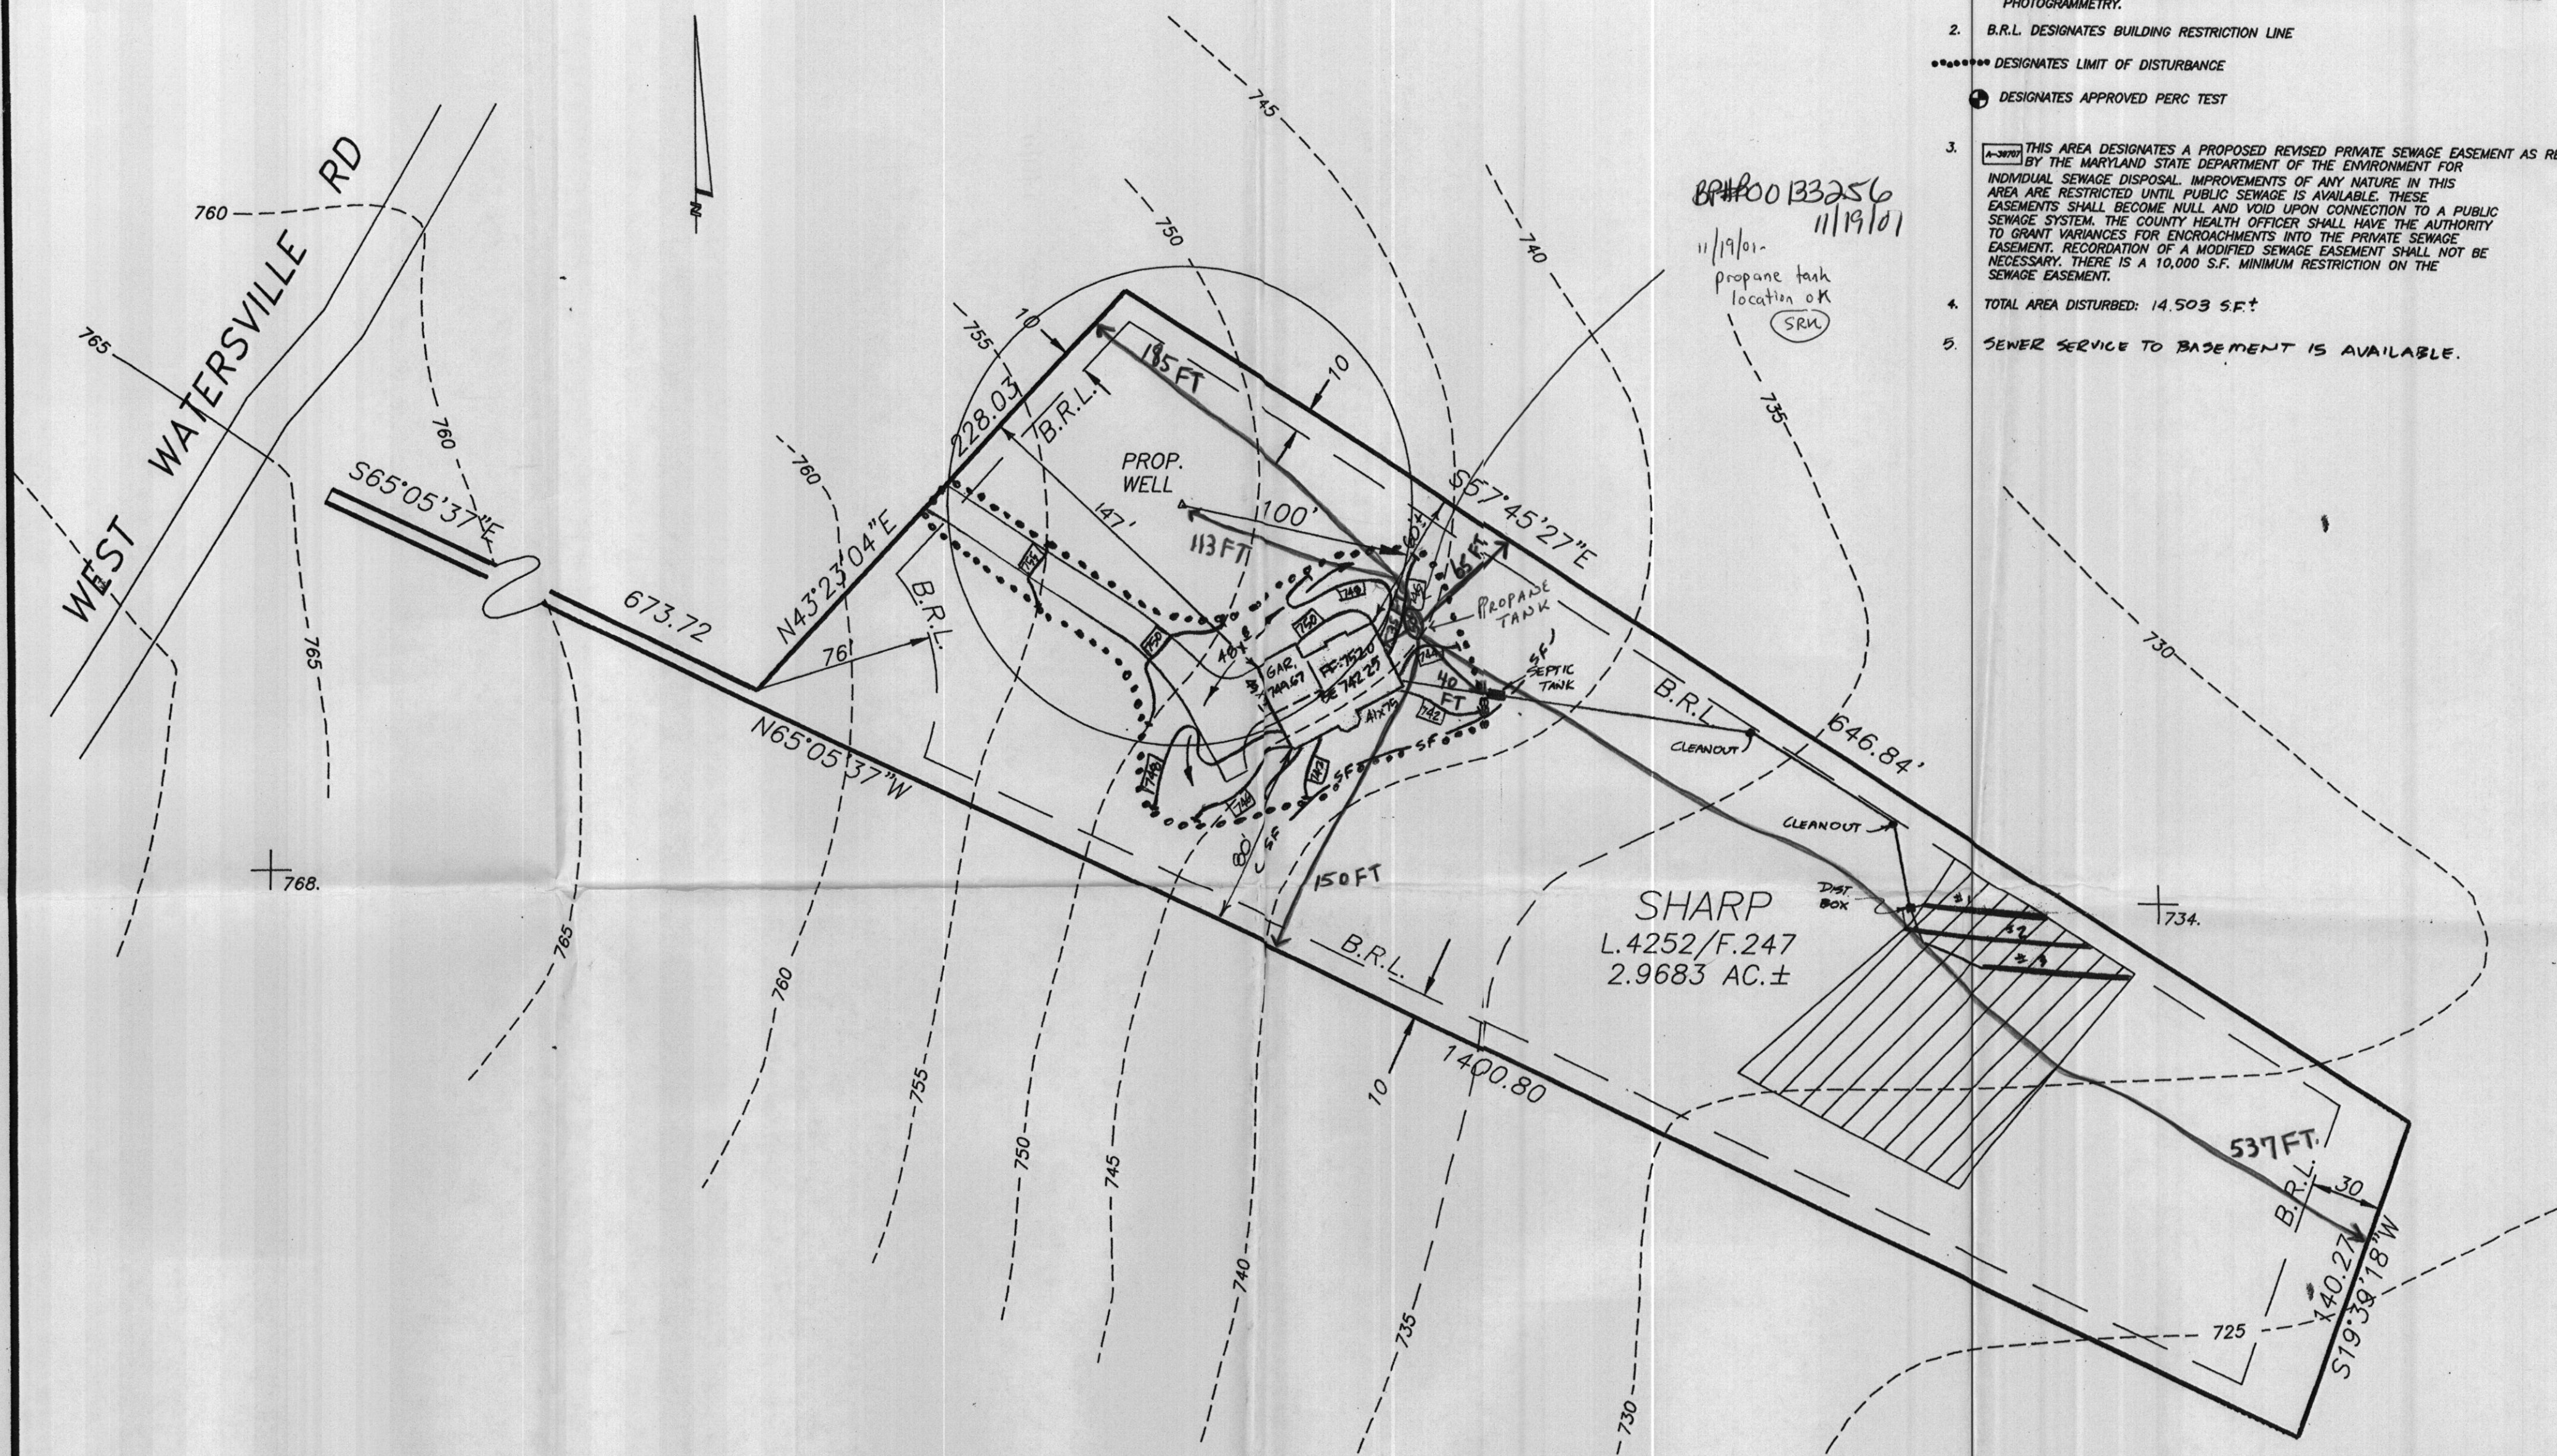

SEPTIC SYSTEM DATA

INV. AT HOUSE	739.7		
SEPTIC TANK			
EX. GRADE	742.3		
FIN. GRADE	742.3		
INV. IN	734.3		
INV. OUT	739.0		
DISTRIBUTION BOX			
EX. GRADE	733.5		
FIN. GRADE	733.5		
INV. IN	731.8		
INV. OUT	731.6		
TRENCHES	#1	#2	#3
EX. GRADE	733.5	733.0	732.5
FIN. GRADE	733.5	733.0	732.5
INV. IN	731.5	731.0	730.5
BOTTOM LENGTH	50	85	65

SHANABERGER & LANE
8726 TOWN & COUNTRY BLVD.
SUITE 201
ELLCOTT CITY, MD. 21043
PHONE: 410-461-9563
FAX: 410-461-9693

SITE PLAN
SHARP PROPERTY

L.4252/F.247
FOURTH ELECTION DISTRICT, HOWARD COUNTY,
TAX MAP 2, PARCEL 242

ZONED: RC-DEO
SCALE: 1"=50'
DATE: 5/14/01