

# APPLICATION

PERCOLATION TESTING

A 58096

P \_\_\_\_\_

HOWARD COUNTY HEALTH DEPARTMENT  
BUREAU OF ENVIRONMENTAL HEALTH  
3525-H ELLICOTT MILLS DRIVE/ELLICOTT CITY, MARYLAND 21043  
TELEPHONE: 313-2640

PREVIOUS OK -  
PROPOSED RECONFIGURATION  
OF MULTIPLE PARCEL FARM  
TRACT AS SUBDIVISION;  
POST-TEST REVIEW SHOULD  
INCLUDE CONSIDERATION  
OF PREVIOUS (1976?)  
TEST HISTORY ON THIS FARM (CW)

DISTRICT \_\_\_\_\_

DATE \_\_\_\_\_

TO: THE COUNTY HEALTH OFFICER  
ELLICOTT CITY, MARYLAND

I HEREBY APPLY FOR THE NECESSARY TEST PRIOR TO APPLICATION FOR PERMIT TO CONSTRUCT (OR RECONSTRUCT) A SEWAGE DISPOSAL SYSTEM.

PROPERTY OWNER D. Storn

ADDRESS West Waterville PHONE \_\_\_\_\_

AGENT OR PROSPECTIVE BUYER C. Shamp

ADDRESS 3779 Shamp Rd Glenwood PHONE 410 4894630  
21738

PROPERTY LOCATION:

SUBDIVISION STIRN LOT NO. (5)

ROAD AND DESCRIPTION Old Frederick Rd.

TAX MAP 2 PARCEL # 180 Abpanel

SIZE OF LOT 1.21 To 3 acs TYPE BLDG. \_\_\_\_\_  
(SINGLE FAMILY DWELLING OR COMMERCIAL)

THE SYSTEM INSTALLED UNDER THIS APPLICATION IS ACCEPTABLE ONLY UNTIL PUBLIC FACILITIES BECOME AVAILABLE. I FULLY UNDERSTAND THE  
FEE CONNECTED WITH THE FILING OF THIS PERC TEST APPLICATION IS NON-REFUNDABLE UNDER ANY CIRCUMSTANCES. I ALSO AGREE TO  
COMPLY WITH ALL M.O.S.H.A. REQUIREMENTS IN TESTING THIS LOT. Charles C. Shamp  
(SIGNATURE OF APPLICANT)

APPROVED BY \_\_\_\_\_ FOR \_\_\_\_\_ DATE \_\_\_\_\_

DISAPPROVED BY \_\_\_\_\_ FOR \_\_\_\_\_ DATE \_\_\_\_\_

HOLD PENDING FURTHER TESTS \_\_\_\_\_

REASONS FOR REJECTION OR HOLDING \_\_\_\_\_

PERCOLATION TEST PLAT/PRELIMINARY PLAT - TITLE OR I.D. # \_\_\_\_\_ DATE \_\_\_\_\_

SITE DEVELOPMENT PLAN/FINAL PLAT - TITLE OR I.D. # \_\_\_\_\_ DATE \_\_\_\_\_

## THIS IS NOT A PERMIT



# APPLICATION

PERCOLATION TESTING

A 58096

HOWARD COUNTY HEALTH DEPARTMENT  
BUREAU OF ENVIRONMENTAL HEALTH  
3525-H ELLICOTT MILLS DRIVE/ELLICOTT CITY, MARYLAND 21043  
TELEPHONE: 313-2640

PREVIEW OK -  
PROPOSED RECONFIGURATION  
OF MULTIPLE PARCEL FARM  
THAT AS SUBDIVISION;  
POST-TEST REVIEW SHOULD  
INCLUDE CONSIDERATION  
OF PREVIOUS (1976?)  
TESTING ON THIS FARM (CW)

P \_\_\_\_\_

DISTRICT \_\_\_\_\_

DATE \_\_\_\_\_

TO: THE COUNTY HEALTH OFFICER  
ELLICOTT CITY, MARYLAND

I HEREBY APPLY FOR THE NECESSARY TEST PRIOR TO APPLICATION FOR PERMIT TO CONSTRUCT (OR RECONSTRUCT) A SEWAGE DISPOSAL SYSTEM.

PROPERTY OWNER D. Storn

ADDRESS West Waterville PHONE \_\_\_\_\_

AGENT OR PROSPECTIVE BUYER C. Shamp

ADDRESS 3779 Shamp Rd Glenwood PHONE 410 4894630  
21738

PROPERTY LOCATION:

SUBDIVISION STIRN LOT NO. 6

ROAD AND DESCRIPTION Old Frederick Rd.

TAX MAP 2 PARCEL # 180 Abpanel

SIZE OF LOT 1.21 To 3 ac. TYPE BLDG. \_\_\_\_\_  
(SINGLE FAMILY DWELLING OR COMMERCIAL)

THE SYSTEM INSTALLED UNDER THIS APPLICATION IS ACCEPTABLE ONLY UNTIL PUBLIC FACILITIES BECOME AVAILABLE. I FULLY UNDERSTAND THE FEE CONNECTED WITH THE FILING OF THIS PERC TEST APPLICATION IS NON-REFUNDABLE UNDER ANY CIRCUMSTANCES. I ALSO AGREE TO COMPLY WITH ALL M.O.S.H.A. REQUIREMENTS IN TESTING THIS LOT. Charles Shamp  
(SIGNATURE OF APPLICANT)

APPROVED BY \_\_\_\_\_ FOR \_\_\_\_\_ DATE \_\_\_\_\_

DISAPPROVED BY \_\_\_\_\_ FOR \_\_\_\_\_ DATE \_\_\_\_\_

HOLD PENDING FURTHER TESTS \_\_\_\_\_

REASONS FOR REJECTION OR HOLDING \_\_\_\_\_

PERCOLATION TEST PLAT/PRELIMINARY PLAT - TITLE OR I.D. # \_\_\_\_\_ DATE \_\_\_\_\_

SITE DEVELOPMENT PLAN/FINAL PLAT - TITLE OR I.D. # \_\_\_\_\_ DATE \_\_\_\_\_


## THIS IS NOT A PERMIT

580910  
COUNTY #

SOIL PROFILE

0'  
1'  
topsoil  
org brn  
cl lm  
1+ org  
brn  
cl lm  
5'  
↓  
>50%  
shale  
frags  
1.5'

0'  
1'  
(E)/(F)  
topsoil  
org brn  
cl lm  
1+ org  
brn  
cl lm  
1.0'  
>50%  
frags

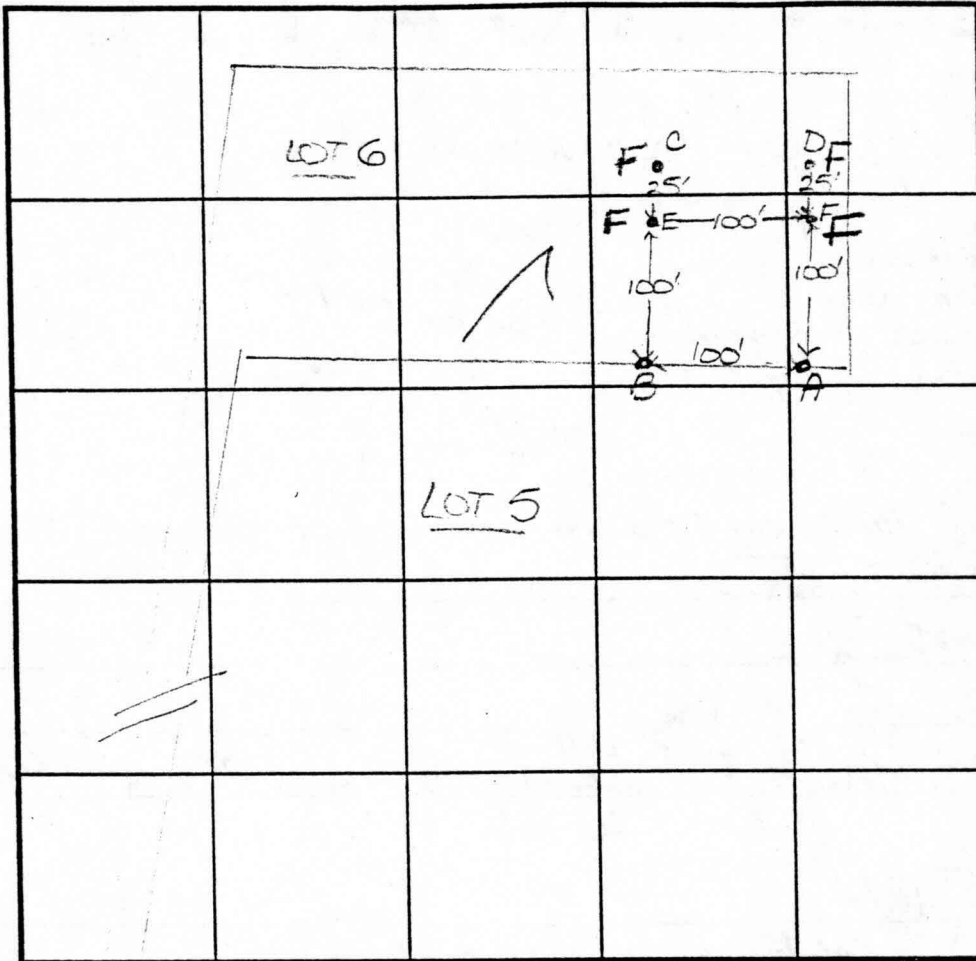

SOIL PROFILE

0'

INDICATE NORTH - NAME ADJOINING ROADWAY AS BASE LINE.

West Watersville Road

| DATE   | TEST NO. | DEPTH | PRE-WET |               | TEST - 1" DROP |      | TIME |
|--------|----------|-------|---------|---------------|----------------|------|------|
|        |          |       | START   | STOP          | START          | STOP |      |
| 5-2-97 | C        | 9.5'D | Refusal | - See profile | →              |      | F    |
|        | D        | 9.5'D | Refusal | - See profile | →              |      | F    |
|        | E        | 7.0'D | Refusal | - See profile | →              |      | F    |
|        | F        | 7.0'D | Refusal | - See profile | →              |      | F    |
|        |          |       |         |               |                |      |      |
|        |          |       |         |               |                |      |      |
REMARKS


TYPE OF SOIL

TESTED BY D. SOE ALSO PRESENT C. Sharp

TRENCH DESIGN DATA: AVERAGE PERCOLATION TIME TRENCH WIDTH


INLET DEPTH MAXIMUM BOTTOM DEPTH SO. FT./BEDROOM

51.0000 Acres±

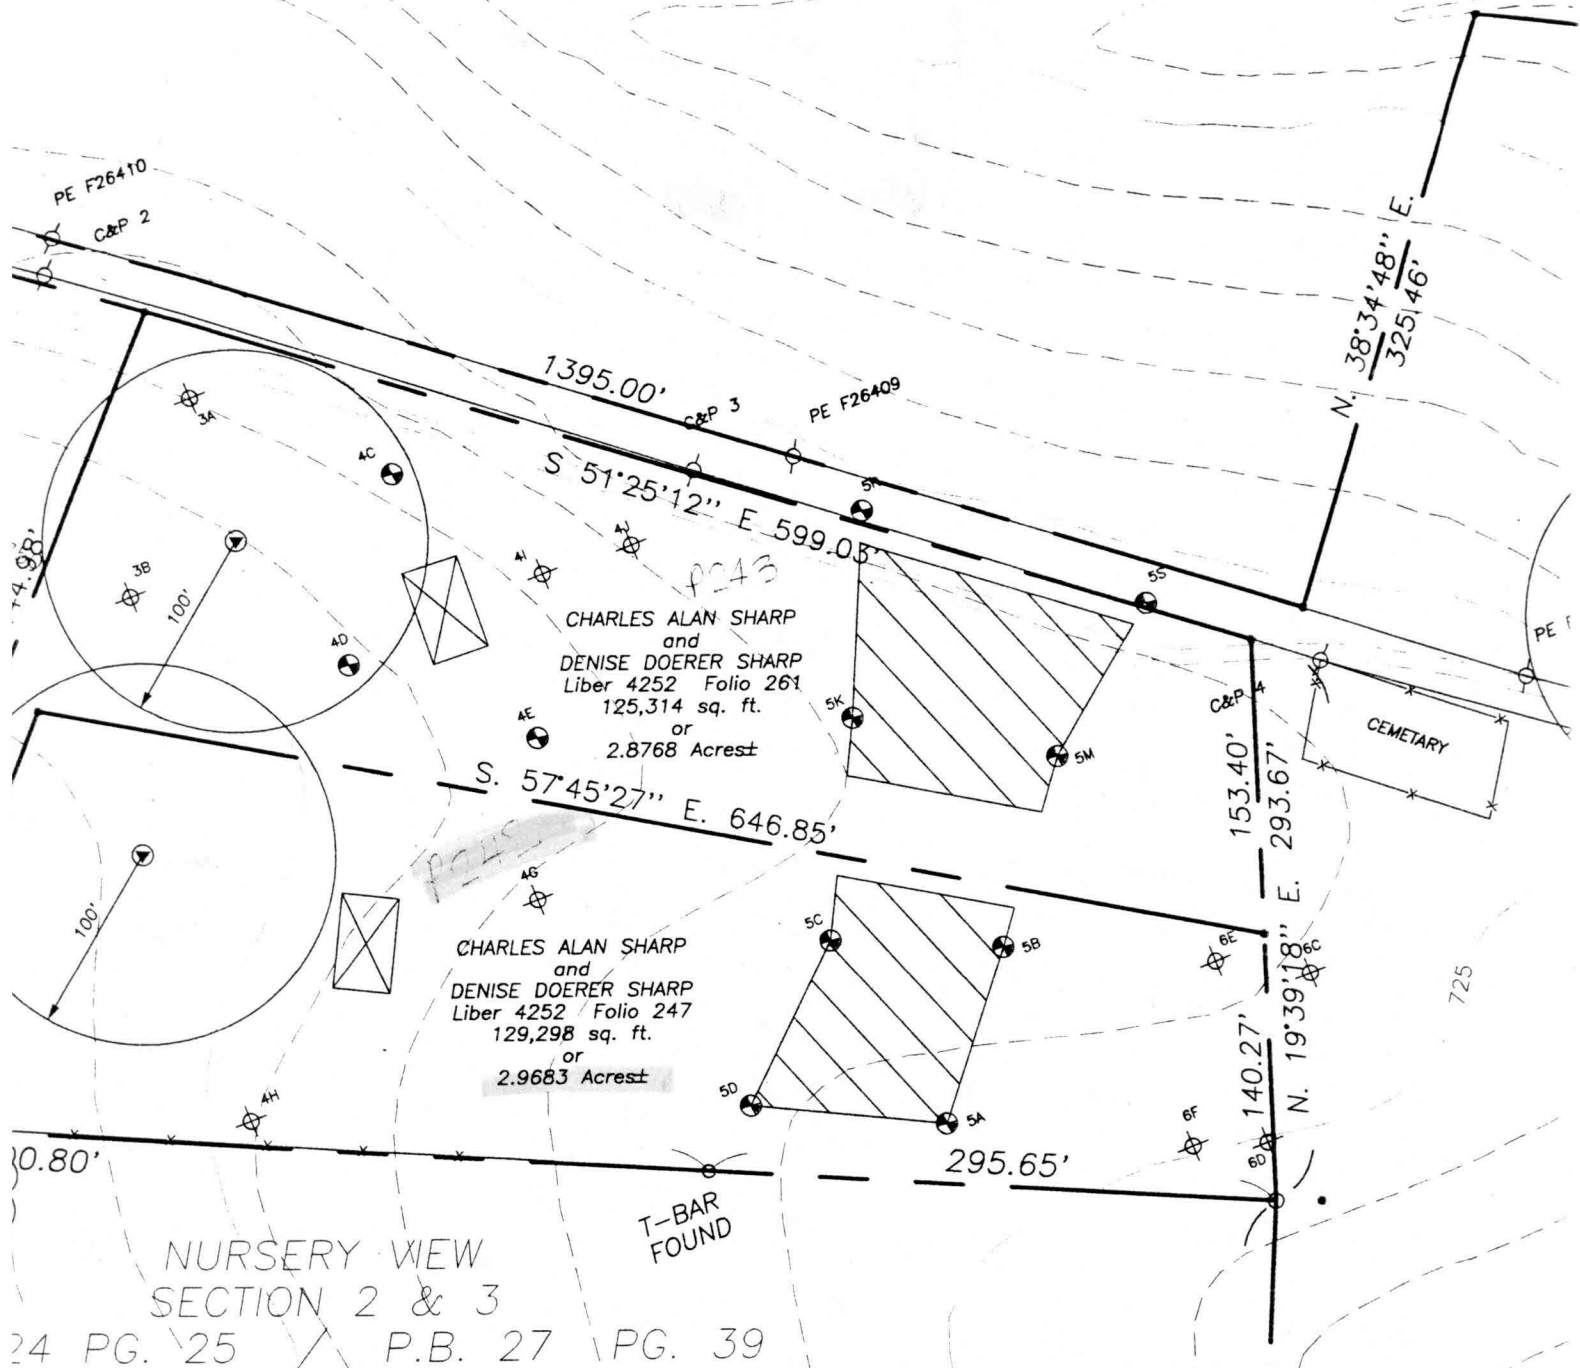

THIS AREA DESIGNATES A PRIVATE SEWERAGE EASEMENT  
OF 10,000 SQUARE FEET AS REQUIRED BY MARYLAND  
STATE DEPARTMENT OF ENVIRONMENT FOR INDIVIDUAL  
SEWERAGE DISPOSAL.

RE IN THIS AREA ARE RESTRICTED UNTIL PUBLIC SEW-  
ERAGE EASEMENTS SHALL BECOME NULL AND VOID UPON CON-  
NECTION TO A PUBLIC SEWERAGE SYSTEM. THE COUNTY HEALTH OFFICER SHALL HAVE  
PRIORITIES FOR ENCROACHMENTS. RECORDATION OF A  
DEED IT SHALL NOT BE NECESSARY.

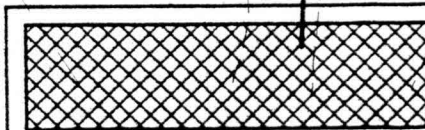

THIS AREA  
IS NOT  
FOR LOT CON

GENERAL NOTE: