

10/26/01 12 NOON Layout
10/29/01 Anytime Final

ISSUE DATE: 10/24/2001

APPROVAL DATE: 10/29/01

**PERMIT
INDEXED**

P 516091

A 58096

**ON-SITE SEWAGE DISPOSAL SYSTEM
HOWARD COUNTY HEALTH DEPARTMENT
BUREAU OF ENVIRONMENTAL HEALTH**

04-361288

WTC III Plumbing & Heating

IS PERMITTED TO INSTALL ☒ ALTER ☐

ADDRESS: 1820 Gillis Falls Rd, 21797 PHONE NUMBER: 410-489-4457

SUBDIVISION: Stirn Farm LOT NUMBER: 242

ADDRESS: 697 West Watersville Road PROPERTY OWNER: Esslinger

SEPTIC TANK CAPACITY (GALLONS): 1250 (TOP SEAM)

PUMP CHAMBER CAPACITY (GALLONS): N/A

NUMBER OF BEDROOMS: 34

SQUARE FEET PER BEDROOM: 210

LINEAR FEET OF TRENCH REQUIRED: 240 280

3.0

TRENCHES:	Trench to be 2.0 feet wide. Inlet 2.0 feet below original grade. Bottom maximum depth 4.0 feet below original grade. Effective area begins at 2.0 feet below original grade. 2.0 feet of stone below distribution pipe.
LOCATION:	Beginning from the intersection of the 646.85' and 228.03' lot lines, begin trenches 420 feet down the 646.85' lot line and 10 feet off that same lot line. Run trenches on contour as shown on the approved building permit plan.
NOTES:	

PLANS APPROVED: Amy Mc Millen OK SRU 6/9/01 DATE: 5-29-01

NOTE: PERMIT VOID AFTER 2 YEARS

NOTE: CONTRACTOR RESPONSIBLE FOR SCHEDULING A PRE-CONSTRUCTION INSPECTION FOR ALL INSTALLATIONS

NOTE: WATERTIGHT SEPTIC TANKS REQUIRED


NOTE: ALL PARTS OF SEPTIC SYSTEM SHALL BE 100 FEET FROM ANY WATER WELL

NOTE: MANHOLE RISERS REQUIRED ON ALL SEPTIC TANKS AND PUMP CHAMBERS


**NEITHER THE HOWARD COUNTY COUNCIL NOR THE HEALTH DEPARTMENT IS
RESPONSIBLE FOR THE SUCCESSFUL OPERATION OF ANY SYSTEM
PERMITTEE RESPONSIBLE FOR OBTAINING FINAL APPROVAL ON THIS PERMIT
CALL 410-313-2640 FOR INSPECTION OF SEPTIC SYSTEM**

OLD PERMIT SIGNATURE
DATE 11-18-01
INSTALL 1000 GAL 46 PROPANE
TANK

P516091

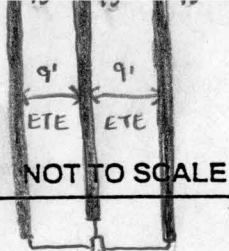

NOT TO SCALE

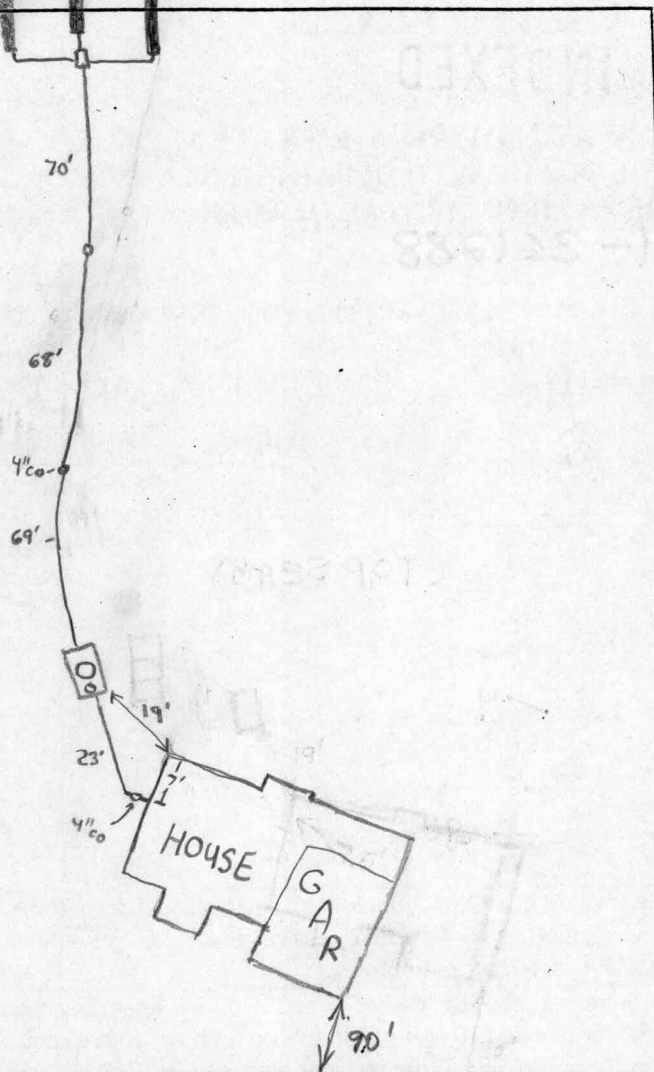

TRENCH DATA

TRENCH WIDTH 3'
 TRENCH INLET DEPTH 2'
 TRENCH BOTTOM DEPTH 4'
 DEPTH OF STONE 2
 NUMBER OF TRENCHES 3
 TOTAL TRENCH LENGTH 280'
 ABSORBENT AREA 840 ft²
 DISTRIBUTION BOX LEVEL ☒
 BAFFLE IN DISTRIBUTION BOX ☒

SEPTIC TANK DATA

SEPTIC TANK 1250 TS GALLONS
 MANHOLE RISER on center
 6 INCH INSPECTION PORT on front

PUMP CHAMBER DATA

PUMP CHAMBER GALLONS NA
 MANHOLE RISER NA
 ALARM NA
 PUMP PERFORMANCE TEST NA

↓ W. Waterville Road HO-94-3074

PRE-CONSTRUCTION INSPECTION: 10/26/01 Contour not as shown on B.P. plan.

To install 3-93' trenches across top of easement. (BB)

INSPECTION COMMENTS: 10/26/01 Tank set.

10/29/01- OK TO COVER ALL WORK (SRK)

INSPECTOR Steven R. Krieg DATE SYSTEM APPROVED 10/29/01