

04-331164

7/10/85 App'd J.S.

PERMIT

SEWAGE DISPOSAL SYSTEM

MARYLAND STATE DEPARTMENT OF HEALTH

P 35475A REPAIR

HOWARD COUNTY

BUREAU OF ENVIRONMENTAL HEALTH

992-2330

ELLICOTT CITY

DISTRICT _____

DATE 5/9/85

INDEXED

Arnold Septic Tank ServiceIS PERMITTED TO INSTALL _____ ALTER XADDRESS Jacobs Road, Mt. Airy, Maryland 21771PHONE 795-7873SUBDIVISION Nursery View ROAD 219 W. Watersville LOT 4PROPERTY OWNER Gilman Wildes

ADDRESS _____

IF GARBAGE GRINDER IS USED INCREASE SEPTIC TANK CAPACITY BY 50% AND ABSORPTION AREA BY 22%.

GARBAGE GRINDER? YES _____ NO X

BLDG. PERMIT SIGNED

AND RETURNED 7-29-87
Serial # B107089
detached garageSEPTIC TANK CAPACITY _____ GALLONS NUMBER OF BEDROOMS 3

REPAIR - CALL FOR INSPECTION WHEN GROUND IS OPENED UP SO SANITARIAN CAN RECOMMEND REPAIR.

INSTALL 2-100FT TRENCHES INLET 5' BOTTOM 8' WITH 3' STONE, C.W.

BLDG. PERMIT SIGNED

AND RETURNED 6/15/90Serial # 33087
2-S-AdditionPLANS APPROVED BY C. WilliamsDATE 5/7/85

COVER NO WORK UNTIL INSPECTED AND APPROVED.

NEITHER THE HOWARD COUNTY COUNCIL NOR THE HEALTH DEPARTMENT IS RESPONSIBLE FOR THE SUCCESSFUL OPERATION OF ANY SYSTEM.

NOTE: IF TRENCH IS USED CALL FOR INSPECTION BEFORE AND AFTER PLACING GRAVEL IN TRENCH.

NOTE: NO DRY WELL SHALL EXCEED 15 FOOT IN DIAMETER. NO ABSORPTION TRENCH TO EXCEED 100 FEET IN LENGTH.

NOTE: ALL PIPE FROM HOUSE TO SEPTIC TANK MUST BE CAST IRON OR SCHEDULE 40 PVC OR ABS.

PERMIT VOID AFTER THREE YEARS.


NOTE: INSTALL STAND PIPE ON SEPTIC TANK AND DRY WELL. STAND PIPES MUST BE 6 INCHES IN DIAMETER. CAST IRON, CONCRETE OR TERRA COTTA, OR PVC OR ABS ACCEPTED. IF TOP OF SEPTIC TANK IS DEEPER THAN 3 FEET MANHOLE TO GRADE REQUIRED

***INSTALLER IS RESPONSIBLE FOR OBTAINING FINAL APPROVAL ON THIS PERMIT**

*CALL 992-2330 FOR INSPECTION OF SEPTIC SYSTEMS.

EH - 2-1082

P35475

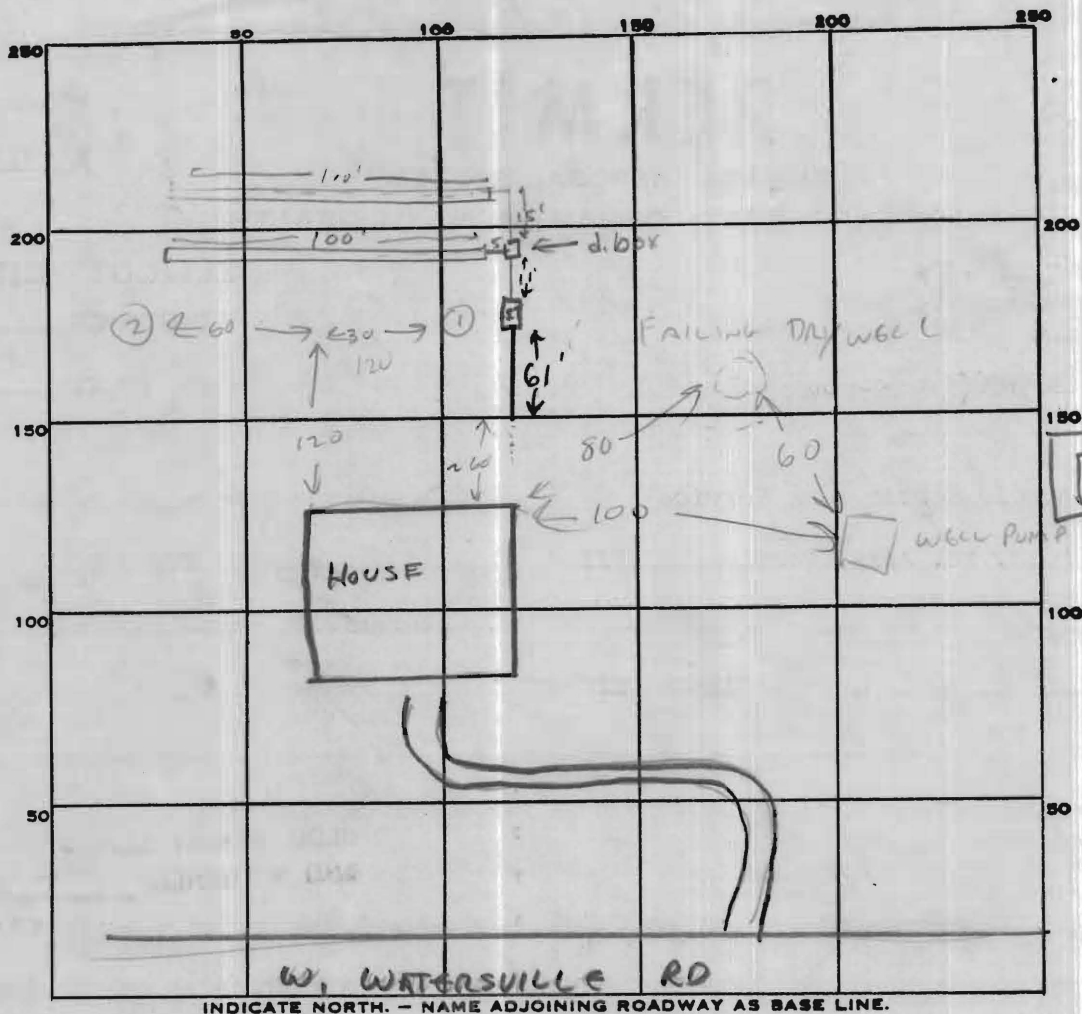

PERMIT CARD no; verbal OK given J.S.

SEPTIC TANK, LEVEL ✓

CLEANOUTS S.T. ✓

DISTRIBUTION BOX, LEVEL ✓

TILE FIELD, DEPTH 8 FT. TRENCH WIDTH 2 FT.

GRAVEL DEPTH 3 FT. TOTAL LENGTH 200 FT.

NUMBER OF TRENCHES 2 ONE SIDEWALL
TOTAL BOTTOM AREA 600 sq ft

SEEPAGE PITS, INSIDE DIAMETER _____ FT. DEPTH BELOW INLET _____ FT.

ABSORBENT AREA ± 600 SQ. FT.

6-10-85

REMARKS HOLE (1) 6' CLAY THEN MICA-SILT LOAM 20-50% SAPPHOLITE 6-12'

HOLE (2) 6' CLAY THEN MICA-SILT LOAM 20-50% SAPPHOLITE 6-12'

IN PLACE 200 SQ FT / BEDROOM OF TRENCH INLET 5' BOTTOM 8' = 3 FT STONE

7/10/85 O.K. to continue work on septic system J.S.

C. Wilcox


DATE SYSTEM APPROVED 7/10/85

INSPECTOR Frank Shiner

FRANK C. STILES

194/443

ORIGINAL OUT 250.50

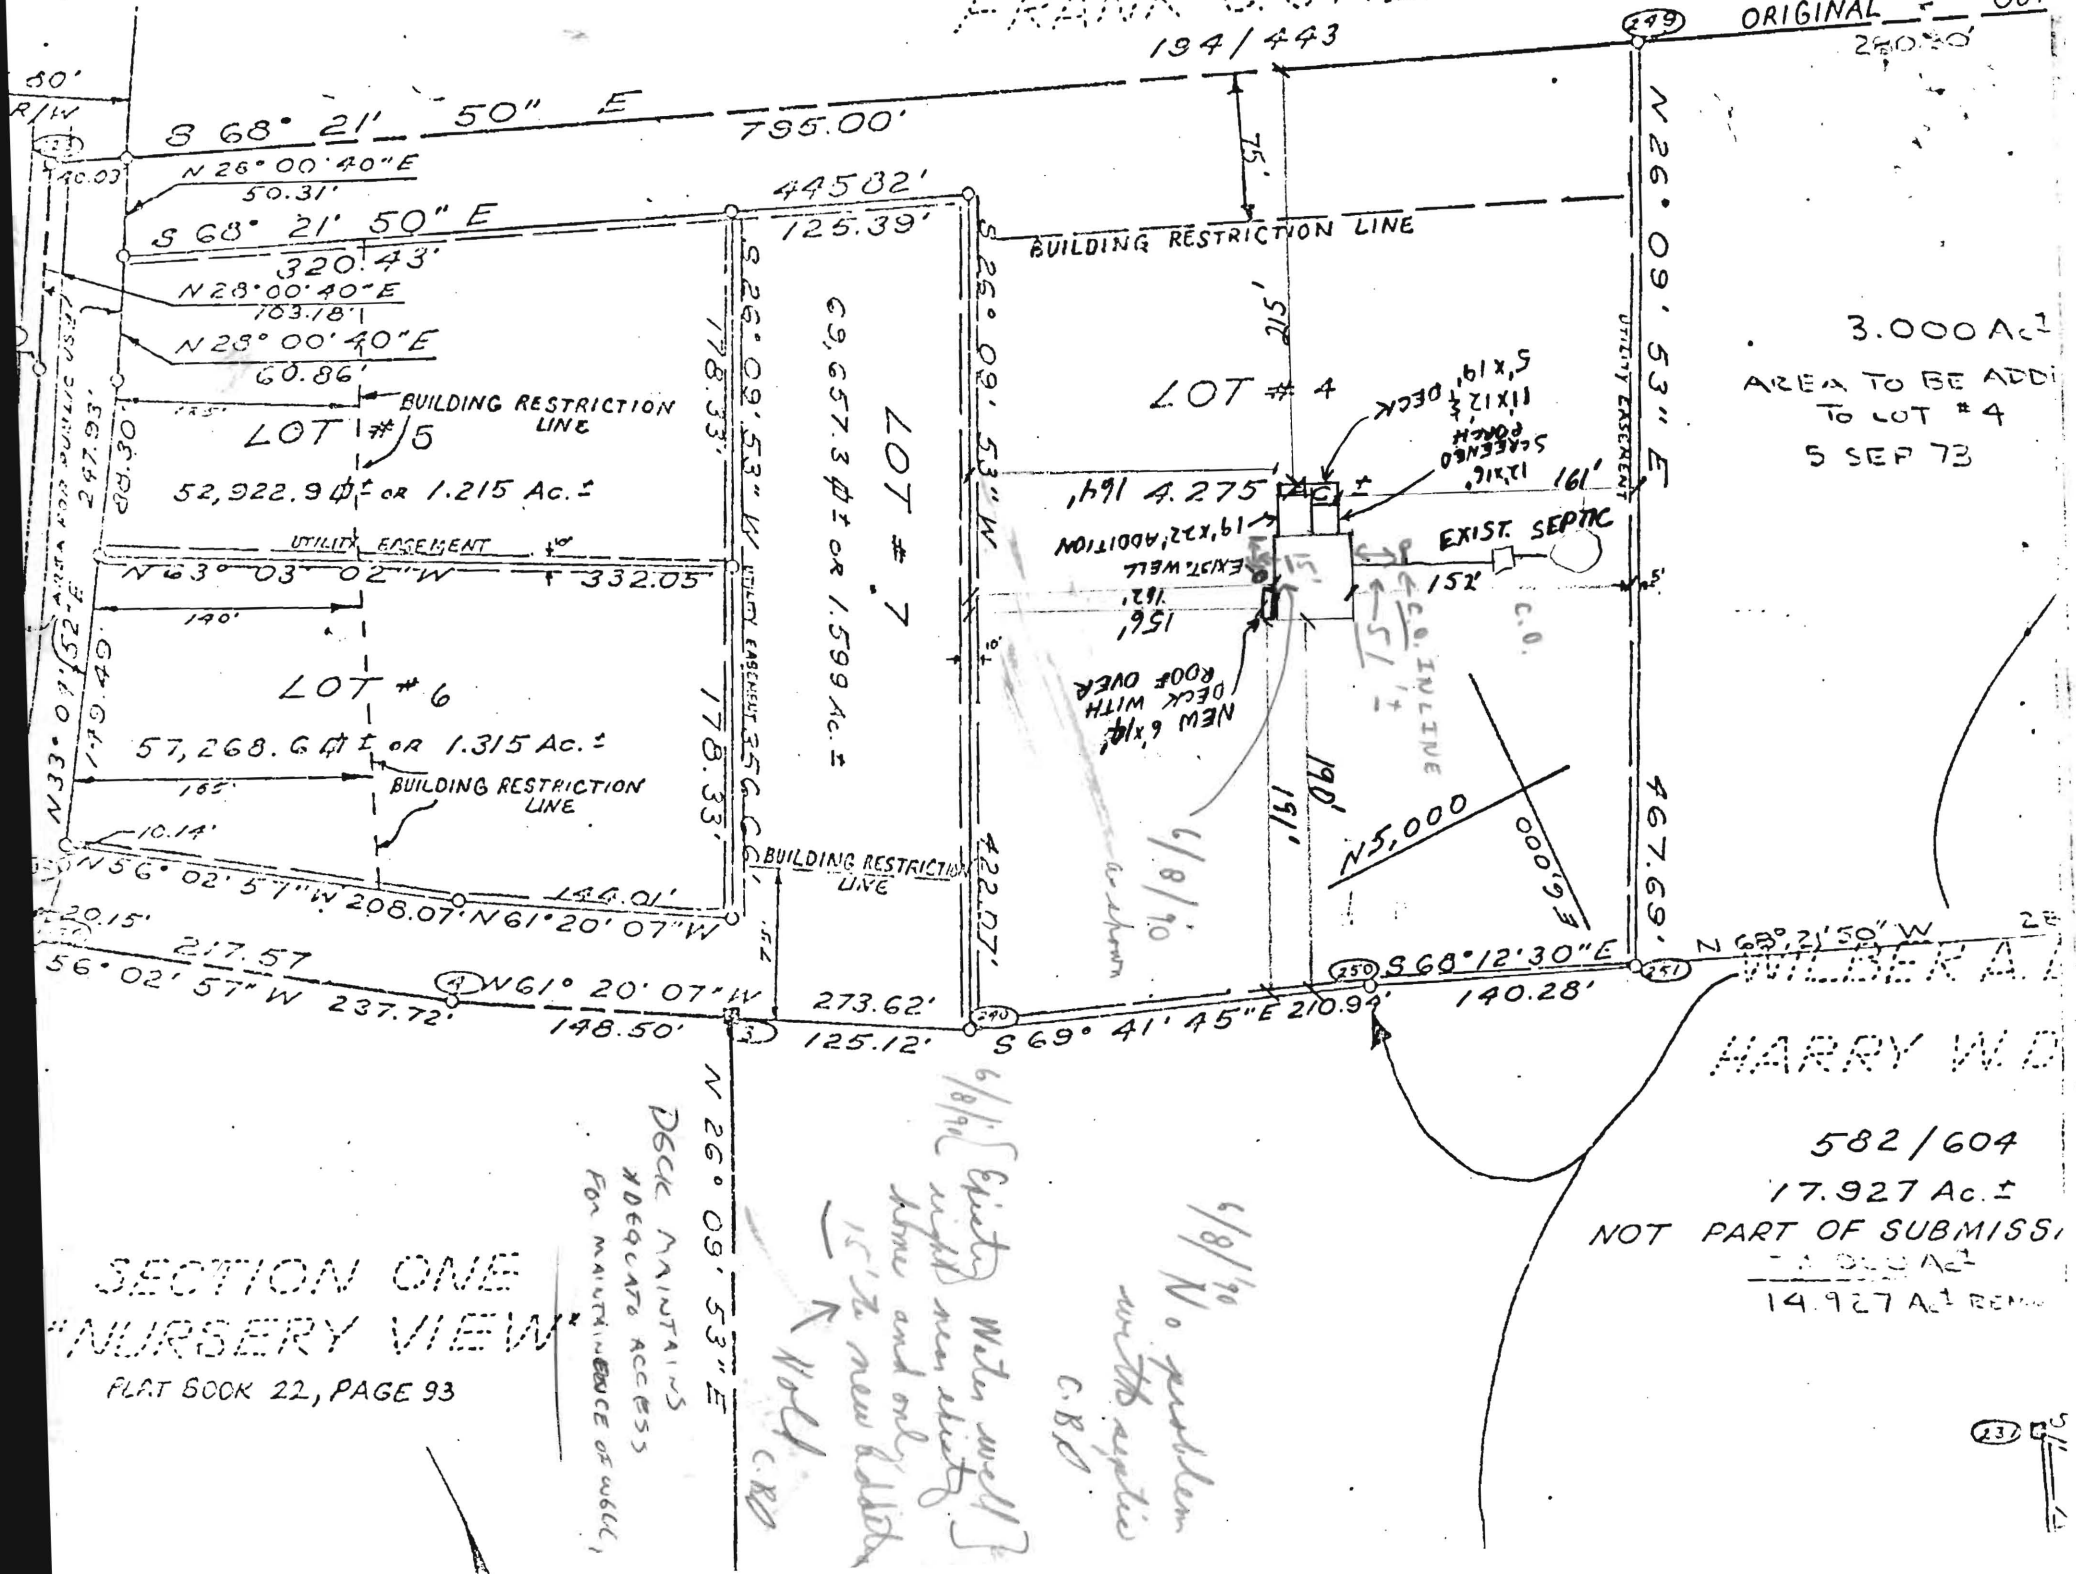

3.000 Ac.
AREA TO BE ADD
TO LOT # 4
5 SEP 73

582/604
17.927 Ac.
NOT PART OF SUBMISS
14.927 Ac. REM


SECTION ONE
"NURSERY VIEW"
PLAT BOOK 22, PAGE 93

DECK MAINTAINS
ADEQUATE ACCESS
FOR MAINTENANCE OF WELL

6/8/70 Existing Well well
15' to new block
No. 1 C.R.D.

6/8/70 No problem
with apptic
C.R.D.

23

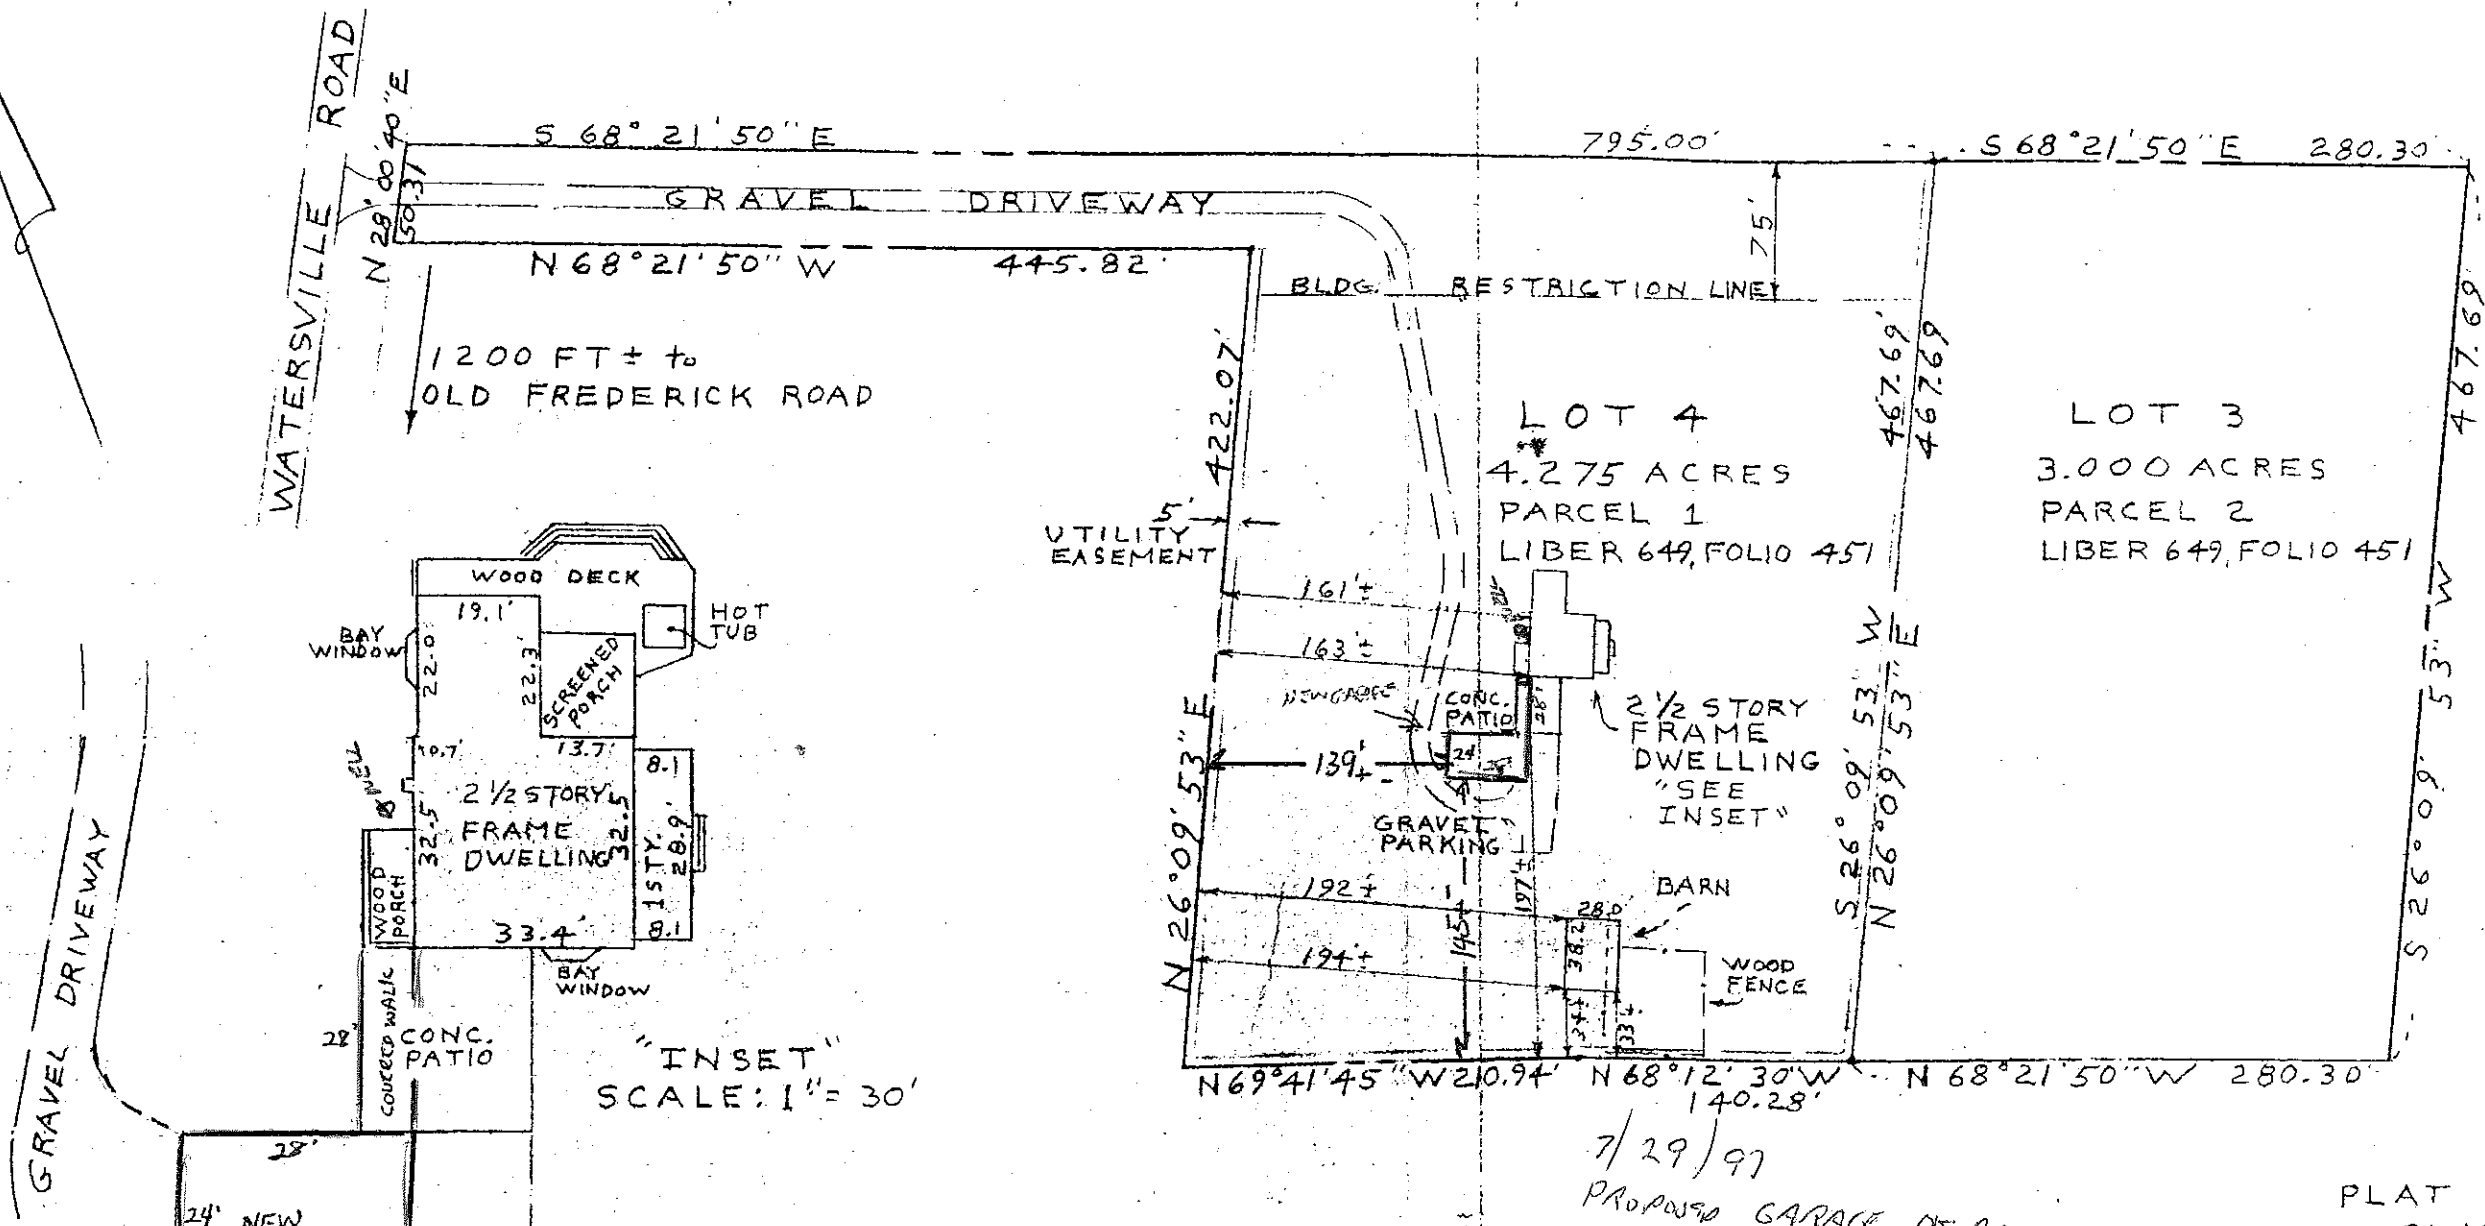

PLAT OF NURSERY VIEW