

APPLICATION

A 10301

P _____

SEWAGE DISPOSAL TESTING

MARYLAND STATE DEPARTMENT OF HEALTH

HOWARD COUNTY

ELLICOTT CITY

DISTRICT 4

DATE 10/6/71

TO: THE COUNTY HEALTH OFFICER
ELLICOTT CITY, MARYLAND

I, HEREBY, APPLY FOR THE NECESSARY TESTS IN ORDER TO CONSTRUCT (OR RECONSTRUCT) A SEWAGE DISPOSAL SYSTEM.

PROPERTY OWNER Daniel Vigue (Any questions call Betty Heckman)
744-0979

ADDRESS _____ PHONE _____

PROPERTY LOCATION:

SUBDIVISION (Dickey Farms, Inc.) LOT NO. 1

ROAD AND DESCRIPTION West Watersville Road, Rt. 40 to West Watersville Rd., follow West Watersville Road about 1/4 of a mile, property on the left. Clear area on East side of the woods. (Heckman sign on property).

OCCUPANT _____ PHONE _____

PERSON TO CONSTRUCT SYSTEM _____

ADDRESS _____ PHONE _____

SIZE OF LOT 5.581 Acres TYPE BLDG. 3 or 4
NUMBER OF BEDROOMS _____

IF NOT SINGLE RESIDENCE DESCRIBE _____

SIGNATURE OF APPLICANT Morris G. Smith (Representing Mr. Daniel Vigue)

APPROVED BY [Signature] FOR [Signature] DATE 10-20-71
(KIND OF SYSTEM)


REJECTED BY _____ FOR _____ DATE F
(KIND OF SYSTEM)

HOLD PENDING FURTHER TESTS _____ DATE _____

REASONS FOR REJECTION OR HOLDING _____

THIS IS NOT A PERMIT

APPLICATION

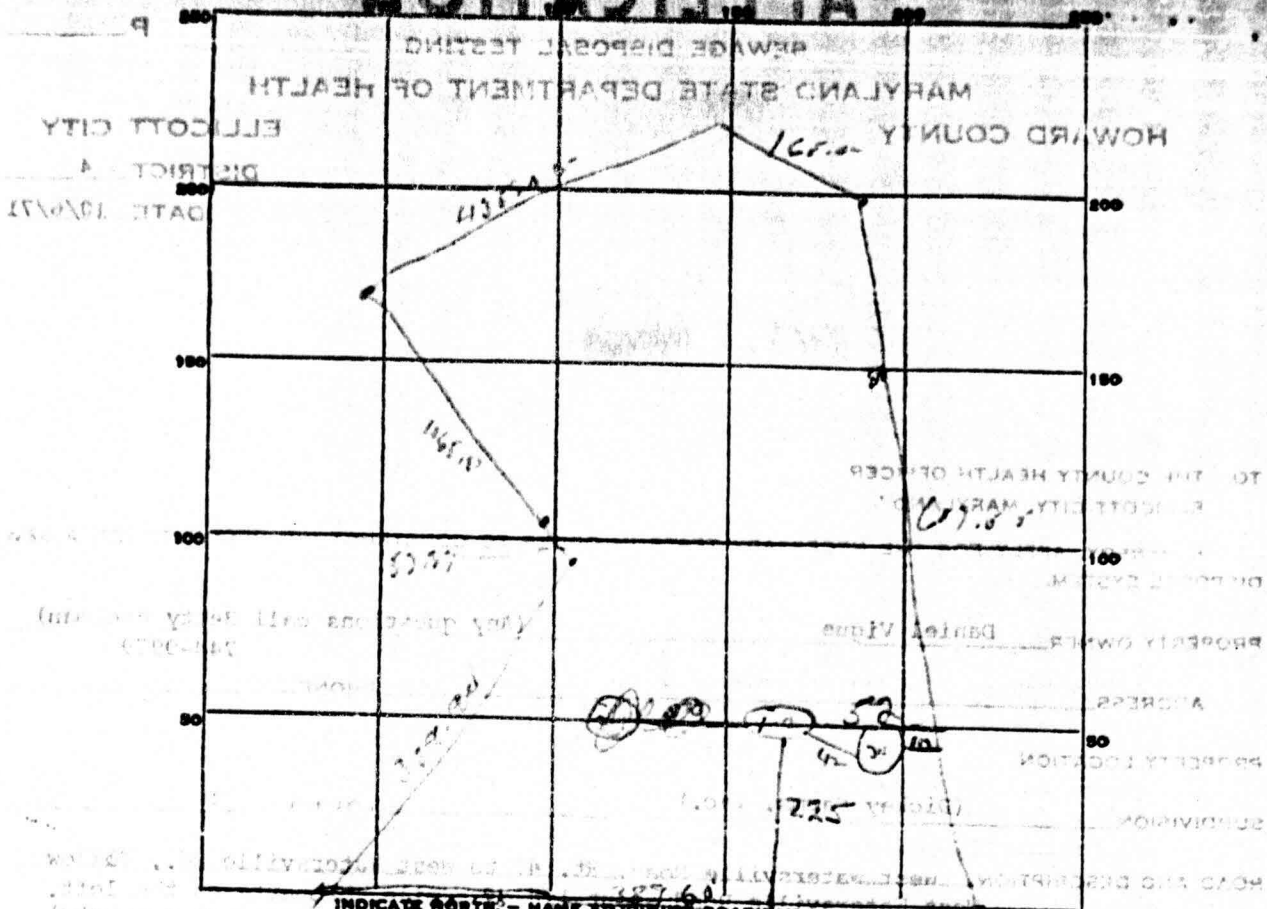

INDICATE NORTH - NAME ADJOINING ROADWAY AS BASE LINE
West Water Hill Rd 30.00'


DATE	TEST NO.	DEPTH	PRE-WET		TEST - 1" DROP		TIME
			START	STOP	START	STOP	
10-28-71	1	11.5'	10 06	10 07	10 02	10 09	2 min
	2	11.0'	10 03	10 10	10 10	10 25	15 min
	3	9.5'	10 39	10 53	10 39	11 15	25 min
	4	13.0'	10 42	10 46	10 46	10 58	9 min

SOIL AUGER FINDING _____

TESTED BY D. J. STON

REMARKS THIS IS NOT A PERM


A 16367

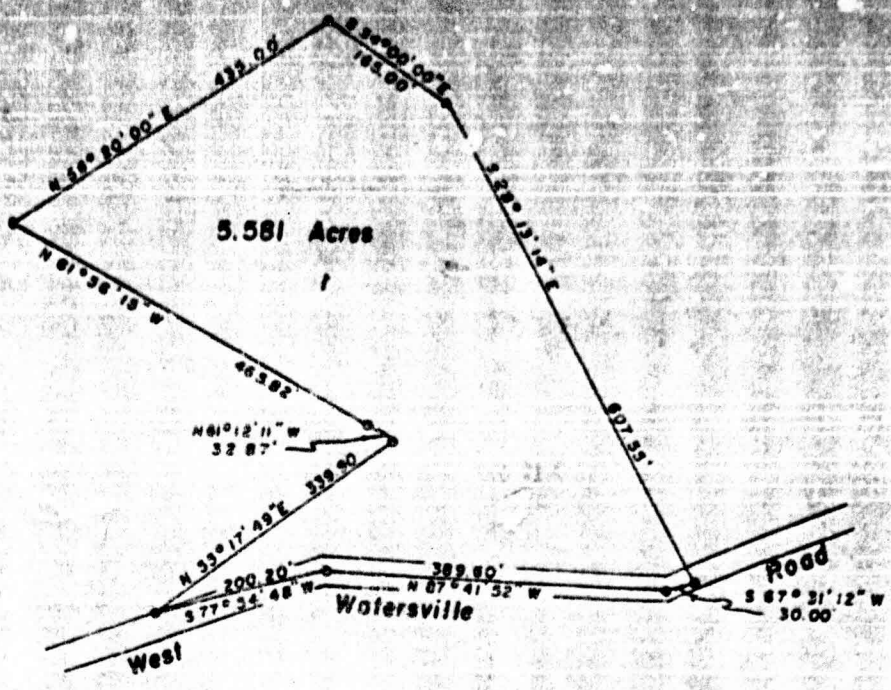

PLAT OF SURVEY
 FOR
 DICKEY FARMS INC.
 FOURTH ELECTION DISTRICT OF HOWARD COUNTY
 MT. AIRY, MARYLAND
 SCALE: 1 IN = 200 FT. MARCH 3, 1970

Claude M. Skimer Jr.
 Claude M. Skimer Jr. Reg. Engineer & Land Surveyor No. 2237

A16367

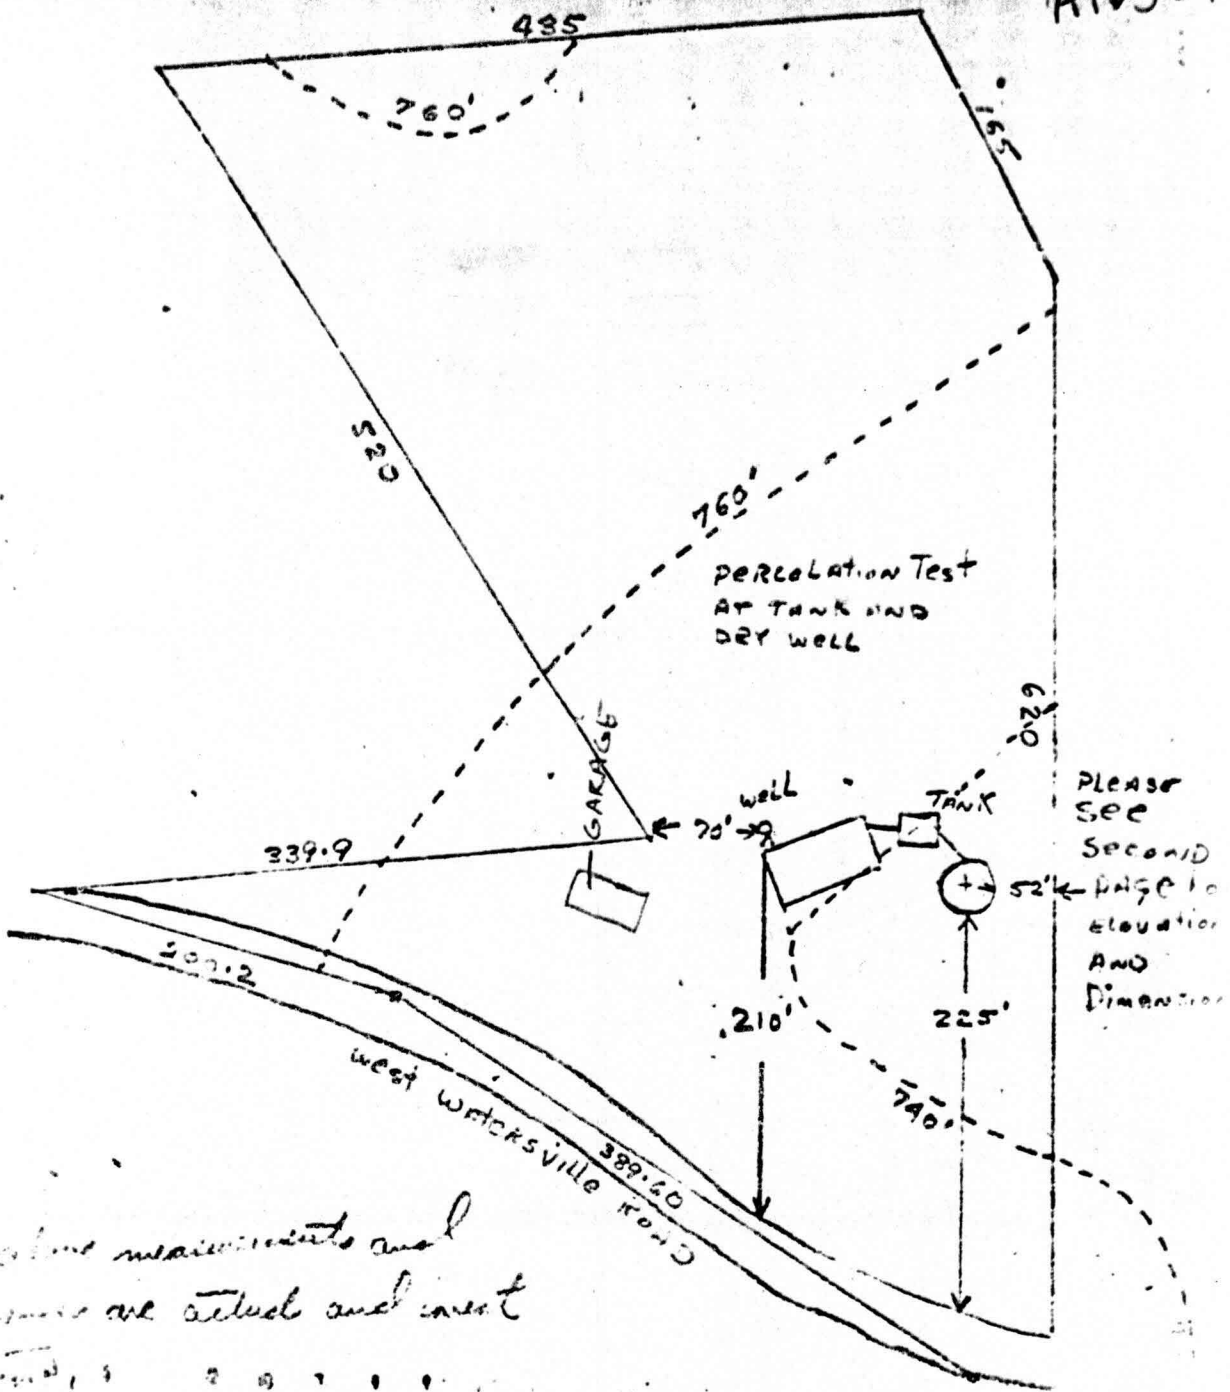

Signed: Daniel R. Vigor
 Daniel R. Vigor
 11/1/71

Mt. Airy, Md.
 Phone 898-9708

WEST WATERSVILLE ROAD, HOWARD COUNTY

Daniel R. Virgine
12/29/21

1:100'

1" = 100' SCALE

