

4/18/07

W/OWNER

EX. HOUSE 3BR
NOT 4BR;

2 BR
BEING

ADDED
EX. S.S. SIZED
FOR 4 BR


1 BR REPAIR
45' TRENCH+

MR

BOO 129178

OK

20 B. 19
Rajya. 17. 17. 17
05/15/2000

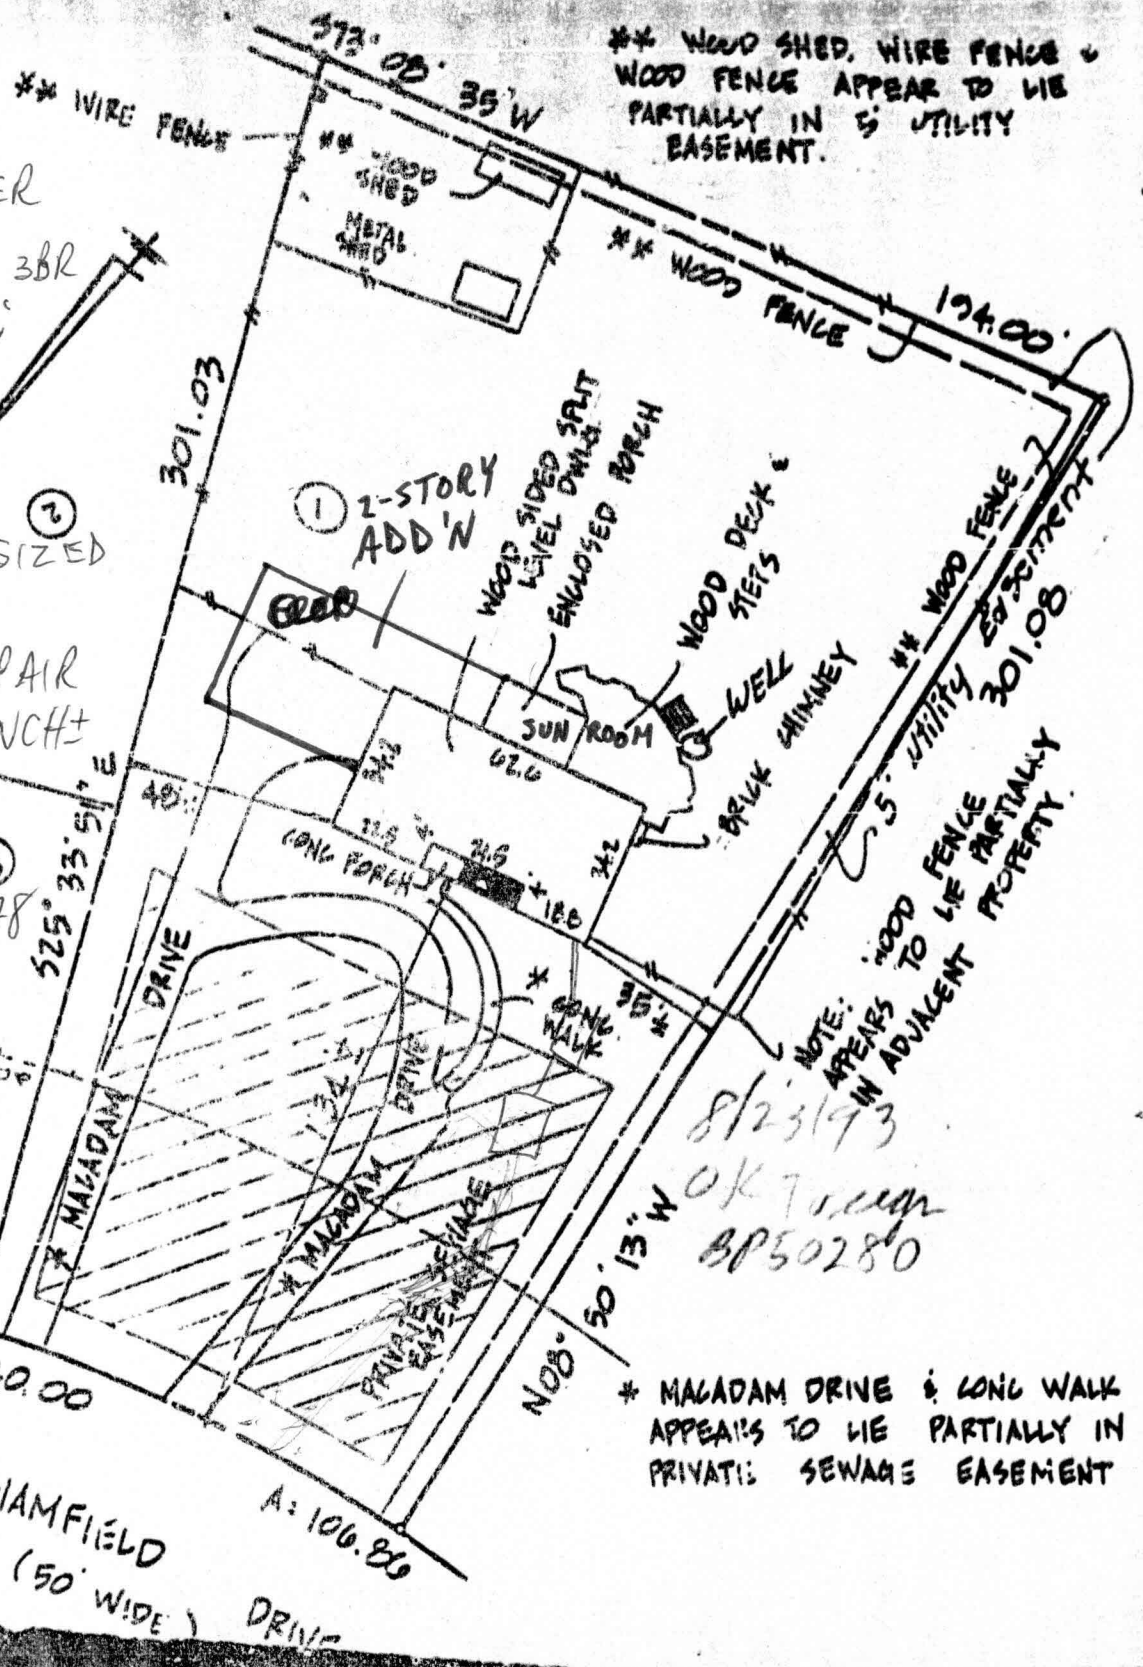

WOOD SHED. WIRE FENCE &
WOOD FENCE APPEAR TO BE
PARTIALLY IN S' UTILITY
EASEMENT.

① 2-STORY
ADD'N

WOOD SIDED SALT
LEVEL DMS
ENCLOSED BENCH

WOOD DECK
STEPS

WELL
BRICK CHIMNEY

#4 WOOD FENCE
Utility easement
301.08

NOTE: WOOD FENCE
APPEARS TO BE PARTIALLY
IN ADJACENT PROPERTY.

* MACADAM DRIVE & LONG WALK
APPEARS TO BE PARTIALLY IN
PRIVATE SEWAGE EASEMENT

WILLIAMFIELD
(50' WIDE) DRIVE

BLDG. PERMIT STOPPED
AND RETURNED 4-18-61
BDD129178

B00129178 - garage/2 story addition