

3/7/02  
11:00

**PERMIT**  
**SEWAGE DISPOSAL SYSTEM**  
HOWARD COUNTY HEALTH DEPARTMENT  
BUREAU OF ENVIRONMENTAL HEALTH  
410-313-2640

P 515203

A REPAIR

ISSUE DATE 3-6-02

APPROVAL DATE 3/7/02

03-279200

INDEXED

JACK FLOCK SEPTIC SERVICE

IS PERMITTED TO INSTALL        ALTER       

ADDRESS 13775 TRIADDELPHIA RD., GLENVIEW MD PHONE 410-988-9270

SUBDIVISION Eagles Loft LOT NUMBER 1 ADDRESS 13135 Williamfield Drive

PROPERTY OWNER Stephen & Leslie Pilford PROPERTY OWNER'S ADDRESS Same

SEPTIC TANK CAPACITY EX. 1250 GALLONS

PUMP CHAMBER CAPACITY        GALLONS

NUMBER OF BEDROOMS 5 w/ 2 BR ADD'N

SQUARE FEET PER BEDROOM 180

LINEAR FEET OF TRENCH REQUIRED 50' OR AS LONG AS POSSIBLE

TRENCHES: Trenches to be 2 feet wide. Inlet 4 feet below original grade. Bottom maximum depth

10 feet below original grade. 6 feet of stone below distribution box.

LOCATION:       

PLANS APPROVED        DATE       

PERMIT VOID AFTER 2 YEARS

NOTE: CONTRACTOR RESPONSIBLE FOR SCHEDULING A PRE-CONSTRUCTION INSPECTION FOR ALL INSTALLATIONS

NOTE: TOP OF SEPTIC TANKS ARE TO BE NO DEEPER THAN 3.0 FEET BELOW FINISH GRADE

NOTE: WATERTIGHT SEPTIC TANKS REQUIRED

NOTE: CLEANOUT REQUIRED EVERY 70 FEET OF SEWER LINE AND/OR AT 90° SWEEPS IN LINES FROM HOUSE TO DRAIN FIELDS, 90° ELBOWS ARE NOT ACCEPTABLE

NOTE: ALL PARTS OF SEPTIC SYSTEMS (I.E. TANK, DISTRIBUTION BOX, DRAINFIELDS) TO BE 100 FEET FROM ANY WATER WELL UNLESS OTHERWISE SPECIFICALLY AUTHORIZED

NOTE: NO ABSORPTION TRENCH TO EXCEED 100 FEET IN LENGTH UNLESS SPECIFICALLY AUTHORIZED

NOTE: ALL PIPE FROM HOUSE TO SEPTIC TANK MUST BE CAST IRON OR SCHEDULE 35/40 PVC OR ABS

NOTE: MANHOLE RISERS REQUIRED ON ALL SEPTIC TANKS AND PUMP CHAMBERS


NOTE: DISTRIBUTION BOXES MUST HAVE BAFFLES

NOTE: IF PUMPED SEPTIC SYSTEM REQUIRED, (1) SEPTIC PUMP DETAIL TO BE PROVIDED BY INSTALLER PRIOR TO ISSUANCE OF SEPTIC PERMIT (2) PUMP PERFORMANCE TEST IS NECESSARY PRIOR TO HEALTH DEPARTMENT APPROVAL OF SEPTIC PERMIT

NEITHER THE HOWARD COUNTY COUNCIL NOR THE HEALTH DEPARTMENT IS RESPONSIBLE FOR THE  
SUCCESSFUL OPERATION OF ANY SYSTEM  
PERMITTEE RESPONSIBLE FOR OBTAINING FINAL APPROVAL ON THIS PERMIT  
CALL 410-313-2640 FOR INSPECTION OF SEPTIC SYSTEM

515203

NOT TO SCALE

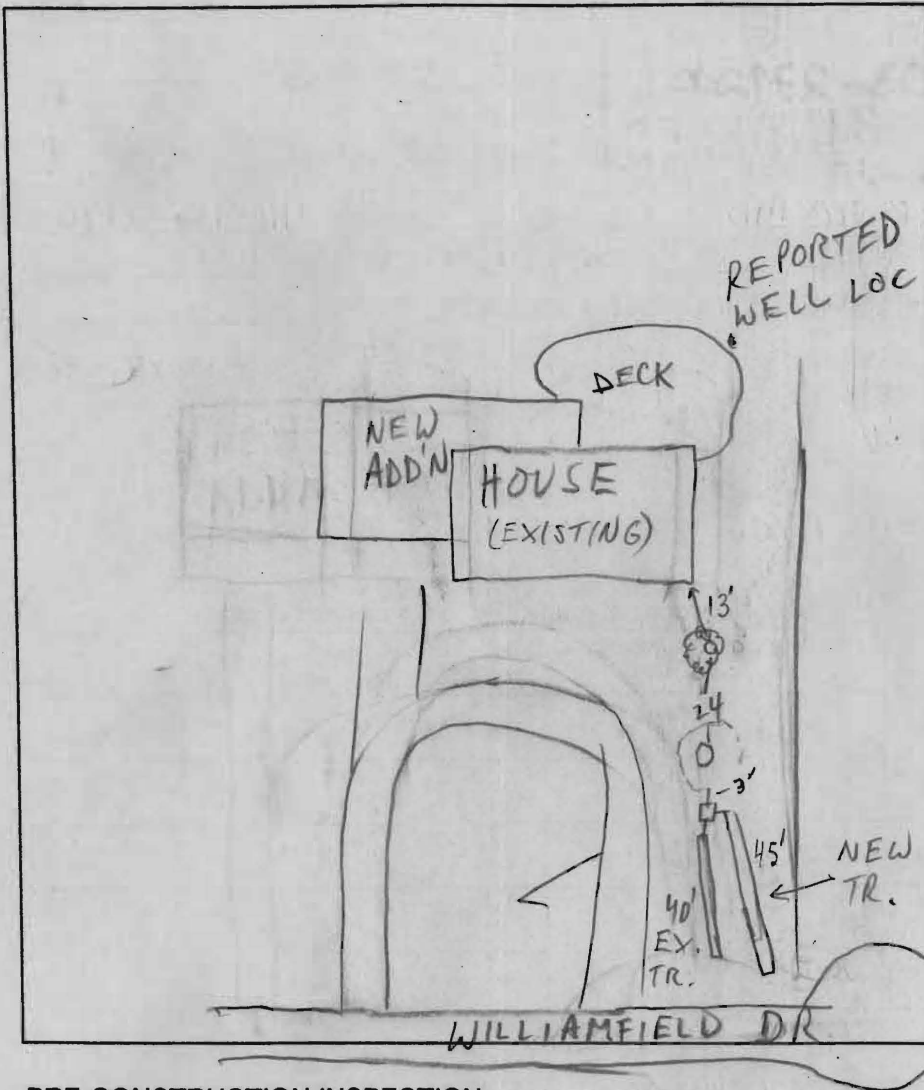

### TRENCH DATA

TRENCH WIDTH 2  
TRENCH INLET DEPTH 3  
TRENCH BOTTOM DEPTH 10  
DEPTH OF STONE 7  
NUMBER OF TRENCHES 1  
TOTAL TRENCH LENGTH 45  
ABSORBENT AREA 315  
DISTRIBUTION BOX LEVEL ☒  
BAFFLE IN DISTRIBUTION BOX ☒

### SEPTIC TANK DATA

SEPTIC TANK EX. 1250 GALLONS  
MANHOLE RISER \_\_\_\_\_  
6 INCH INSPECTION PORT EX.

### PUMP CHAMBER DATA

PUMP CHAMBER GALLONS ☒  
MANHOLE RISER ☒  
ALARM ☒  
PUMP PERFORMANCE TEST ☒

PRE-CONSTRUCTION INSPECTION: \_\_\_\_\_

INSPECTION COMMENTS: 3/7/02 EX. TRENCH OFF D/W IS 40' LONG AND STRAIGHT (NOT AS PER EX. SEPTIC RECORD); OK TO COVER ALL WORK

INSPECTOR

M. Ripkin

DATE SYSTEM APPROVED

3/7/02