

600008713

DEPARTMENT OF INSPECTIONS, LICENSES AND PERMITS
3430 COURTHOUSE DRIVE
ELICOTT CITY, MD 21043
PERMITS (410) 313-2455 INSPECTIONS (410) 313-1810
AUTOMATED INFORMATION (410) 313-3800HOWARD COUNTY
PERMIT APPLICATION

PERMIT NUMBER

B00154765

Building Address 15912 Willis Way
Woodbine MD 21797
Suite/Apt. #: 04367979 SDP/WP/Petition #: _____
Census Tract 60402 Subdivision Waterford Farms
Section _____ Area _____ Lot 31 *1642
Tax Map 20 Parcel 139 Grid 12
Zoning RC-XD Map Coordinates 867 Lot size 1.0704

Property Owner's Name Toll MD 2 LP
Address 7164 Columbia Gateway Dr #230
City Columbia State MD Zip Code 21046
Home Phone _____ Work Phone 410-489-6292
Applicant's Name & Mailing Address, (if other than stated hereon):
Phone _____ Fax _____

Existing Use Vacant Lot
Proposed Use Residential Home
Estimated Construction Cost \$ 325,000 Provincetown
Description of Work Henley Colonial w/
contemporary and modern suites

Contractor Company Toll MD 2 LP
Contact Person Nathan Bridle
Address 7164 Columbia Gateway Dr #230
City Columbia State MD Zip Code 21046
License No. 678
Phone 410-489-6292 Fax 410-489-6293

Occupant or Tenant Toll MD 2 LP
Contact Name Nathan Bridle
Address 7164 Columbia Gateway Dr #230
City Columbia State MD Zip Code 21046
Phone 410-489-6292 Fax 410-489-6293

Engineer or Architect Company FSH Associates
Contact Person Zach
Address 8318 Forrest St.
City Ellicott City State MD Zip Code 21043
Phone 410-750-7251 Fax 410-750-7350

BUILDING DESCRIPTION - COMMERCIAL

Building Characteristics

Height: _____
No. of stories: _____
Gross area, sq. ft. per floor: _____
Use group: _____
Construction type:
☐ Reinforced Concrete
☐ Structural Steel
☐ Masonry
☐ Wood Frame
☐ State Certified Modular

Utilities

Water Supply:
☐ Public
☐ Private
Sewage Disposal:
☐ Public
☐ Private
Electric Yes ☐ No ☐
Gas Yes ☐ No ☐
Heating System:
Electric ☐ Oil ☐
Natural Gas ☐
Propane Gas ☐
Sprinkler system: N/A ☐
☐ Full
☐ Partial
☐ Other Suppression
of Heads _____

BUILDING DESCRIPTION - RESIDENTIAL

Building Characteristics

SF Dwelling ☒ SF Townhouse ☐
Depth _____ Width _____ Height _____
1st floor: 82 81 85
2nd floor: 82 75 21
Basement: 82 81 8
Finished Basement ☐ Unfinished Basement ☒
Crawl space ☐ Slab on Grade ☐
No. of Bedrooms 4
Height: _____
Multi-family dwellings:
No. of efficiency units: _____
No. of 1 BR units: _____
No. of 2 BR units: _____
No. of 3 BR units: _____
Other Structure: _____
Dimensions: _____
Footings: _____
Roof Height: _____
☐ State Certified Modular
☐ Manufactured Home

Utilities

Water Supply:
☐ Public
☒ Private
Sewage Disposal:
☐ Public
☒ Private
Electric Yes ☒ No ☐
Gas Yes ☐ No ☒
Heating System:
Electric ☐ Oil ☐
Natural Gas ☐
Propane Gas ☒
Sprinkler system: N/A ☐
☐ NFPA #13D
☐ NFPA #13R
☐ Other:

THE UNDERSIGNED HEREBY CERTIFIES AND AGREES AS FOLLOWS: (1) THAT HE/SHE IS AUTHORIZED TO MAKE THIS APPLICATION; (2) THAT THE INFORMATION IS CORRECT; (3) THAT HE/SHE WILL COMPLY WITH ALL REGULATIONS OF HOWARD COUNTY WHICH ARE APPLICABLE THEREON; (4) THAT HE/SHE WILL PERFORM NO WORK ON THE ABOVE REFERENCED PROPERTY NOT SPECIFICALLY DESCRIBED IN THIS APPLICATION; (5) THAT HE/SHE GRANTS COUNTY OFFICIALS THE RIGHT TO ENTER ONTO THIS PROPERTY FOR THE PURPOSE OF INSPECTING THE WORK PERMITTED AND POSTING NOTICES.

Applicant's Signature

Title/Company

Print Name

Date


Checks payable to: DIRECTOR OF FINANCE OF HOWARD COUNTY
** PLEASE WRITE NEATLY AND LEGIBLY. **

FOR OFFICE USE ONLY

SIGNATURE APPROVAL		DEPARTMENT OF INSPECTIONS, LICENSES AND PERMITS		PROPOSED WORK	
Front		Front		Filing fee	\$ 100.00
Rear		Rear		Permit fee	\$ 100.00
Side		Side		Examination fee	\$ 100.00
Side St		Side St		Approval fee	\$ 100.00
As shown on plans		As shown on plans		TOTAL FEES	\$ 400.00
YES <input type="checkbox"/> NO <input type="checkbox"/>		YES <input type="checkbox"/> NO <input type="checkbox"/>		Submittal fee	\$ 100.00
Is exterior finish required?		Is exterior finish required?		Balance fee	\$ 100.00
YES <input type="checkbox"/> NO <input type="checkbox"/>		YES <input type="checkbox"/> NO <input type="checkbox"/>		Check	\$ 100.00
Historic District?		Historic District?		Unlabeled	\$ 100.00
YES <input type="checkbox"/> NO <input type="checkbox"/>		YES <input type="checkbox"/> NO <input type="checkbox"/>			
Lot Coverage for Landmark Zone		Lot Coverage for Landmark Zone			
Software and approval fee		Software and approval fee			
YES <input type="checkbox"/> NO <input type="checkbox"/>		YES <input type="checkbox"/> NO <input type="checkbox"/>			
Water	YES <input type="checkbox"/> NO <input type="checkbox"/>	Water	YES <input type="checkbox"/> NO <input type="checkbox"/>		
Gas	YES <input type="checkbox"/> NO <input type="checkbox"/>	Gas	YES <input type="checkbox"/> NO <input type="checkbox"/>		
Electric	YES <input type="checkbox"/> NO <input type="checkbox"/>	Electric	YES <input type="checkbox"/> NO <input type="checkbox"/>		
Other	YES <input type="checkbox"/> NO <input type="checkbox"/>	Other	YES <input type="checkbox"/> NO <input type="checkbox"/>		

WILLIS WAY

PUBLIC ACCESS PLACE

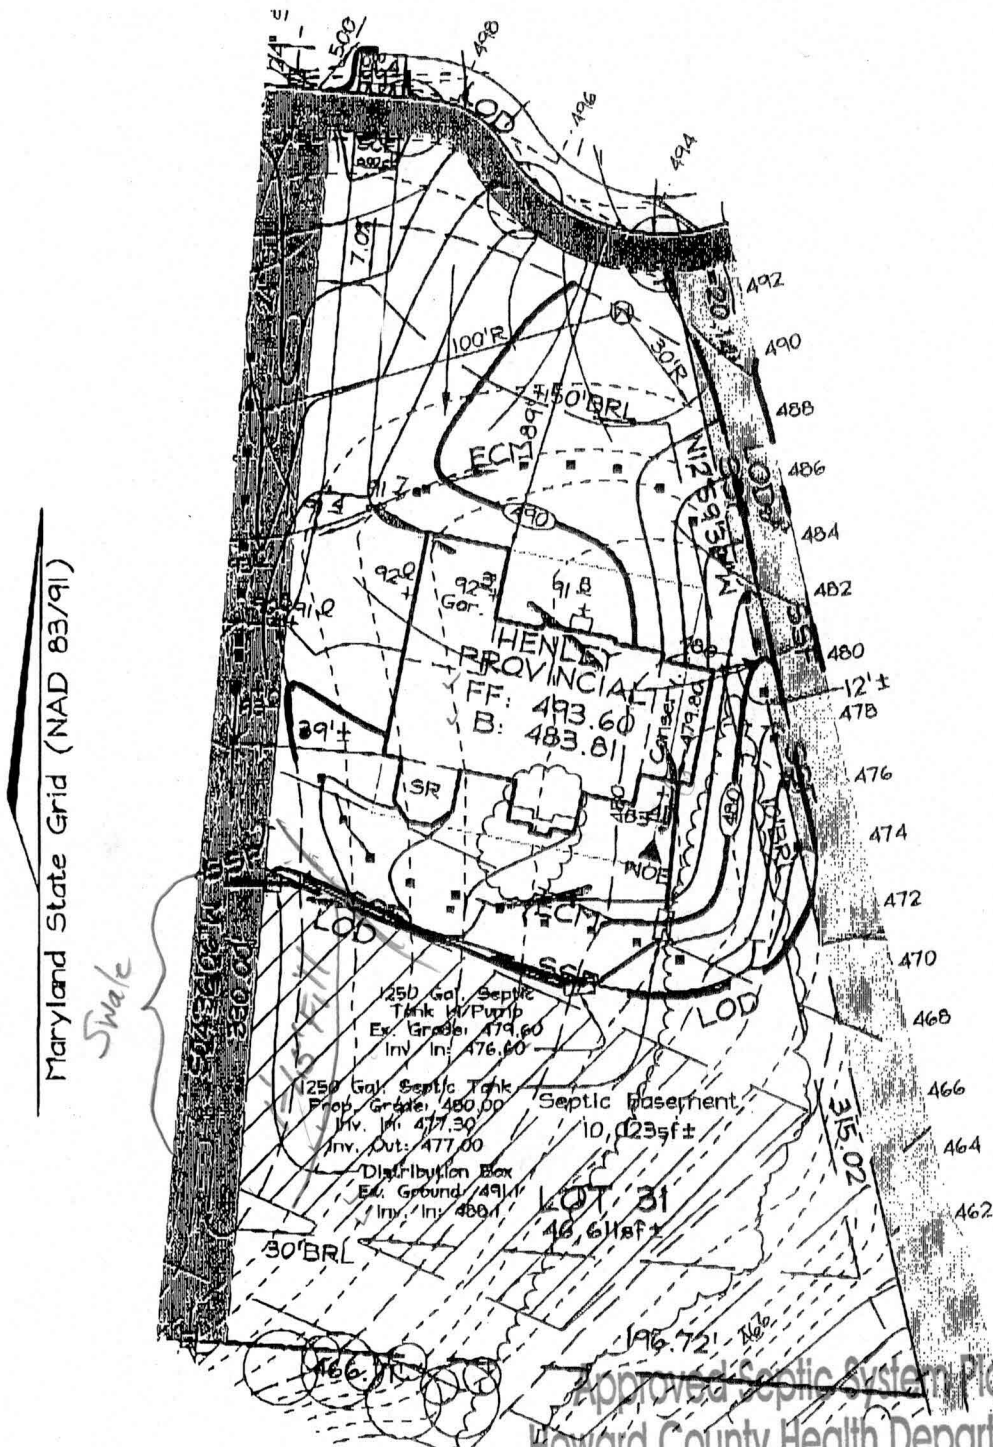

OWNER/DEVELOPER

Toll MD II, LP
7164 Columbia Gateway Drive
Suite 230
Columbia, Maryland 21046
410.672.9185

FSH Associates

Engineers Planners Surveyors
8318 Forrest Street Ellicott City, MD 21043
Tel: 410-750-2251 Fax: 410-750-7350
E-mail: info@fsha.biz

- Note: 1. See Approved Grading Plan GP-04-39 for Entire Site.
2. The existing well shown on this plan (identified with the attached well tag number: HO-94-3593) has been field located by C. B. Miller professional surveyor and is accurately shown.

DESIGN BY: PS
DRAWN BY: MY
CHECKED BY: ZYF
SCALE: 1"=50'
DATE: June 30, 2005
A.O. No.: 3217
SHEET No.: 1 OF 1

LOT RESITE

LOT 31

CATTAIL TRACE

TAX MAPS 13, 14, 20 & 21
GRIDS 7, 12, 19 & 24
4TH ELECTION DISTRICT

PARCELS 20, 67 & 312
HOWARD COUNTY, MARYLAND

GP-04-39