


where ends of geotextile fabric come together, they shall be overlapped, tied and stapled to prevent sediment bypass.
Silt Fence shall be inspected after each rainfall event and maintained when silt occurs or when sediment accumulation reached 50% of the fabric height.

SILT FENCE

NOT TO SCALE

Depth of stone required below distribution pipe 8.0 feet
Depth of trench(es) 5.0 feet

Approved Septic System Plan
Howard County Health Department

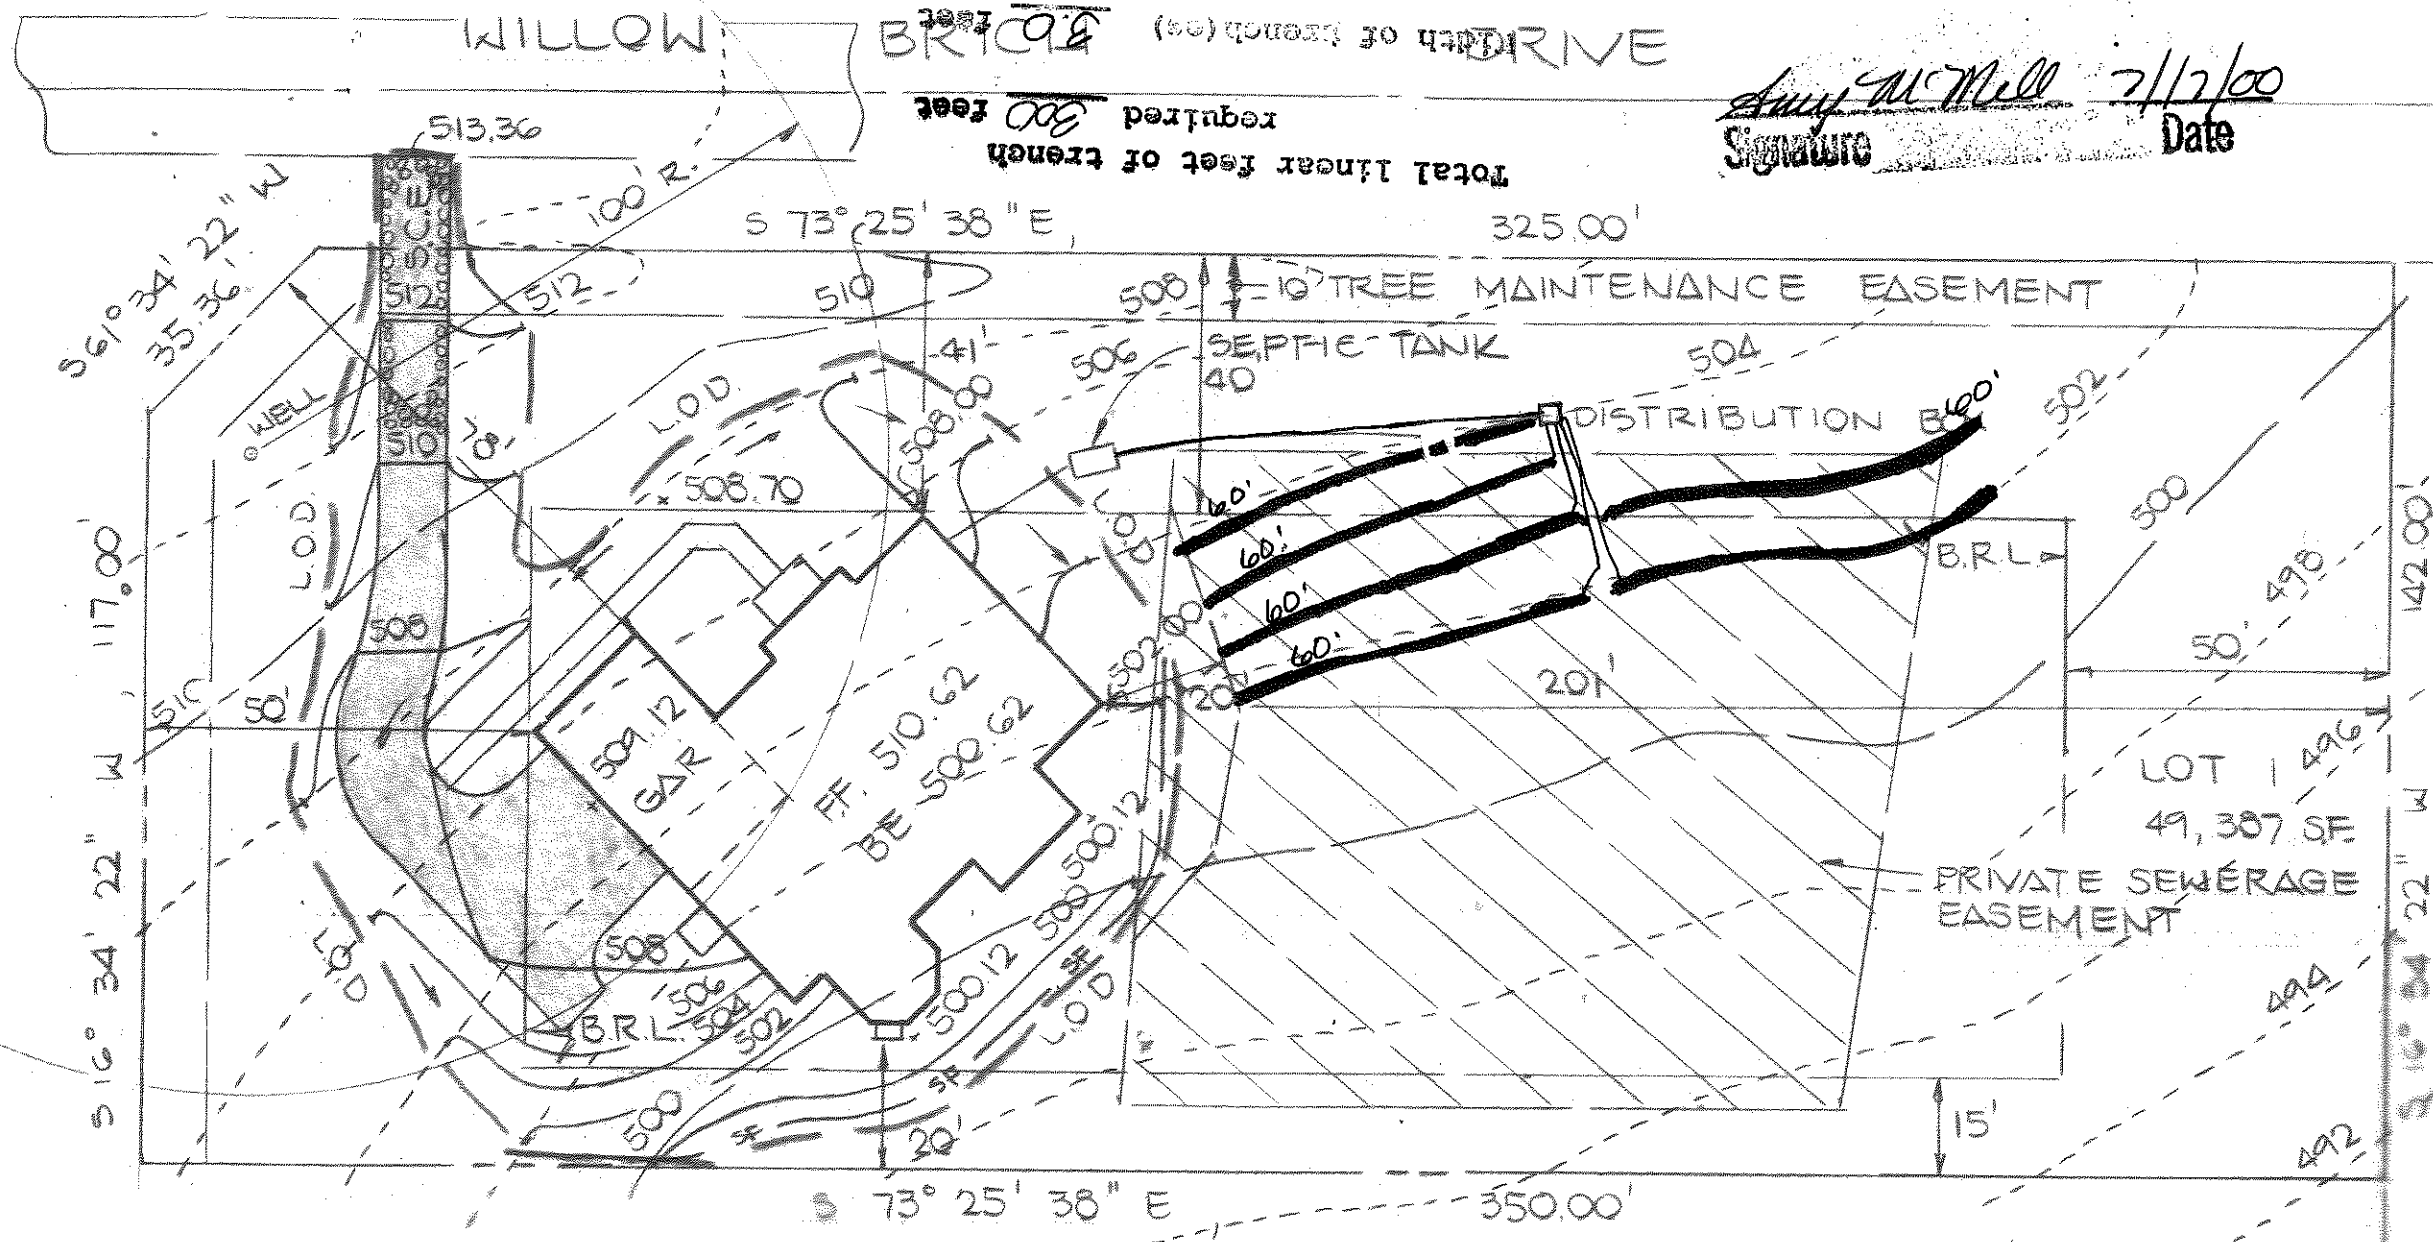

Amy McMill 7/17/00
Signature Date

GENERAL NOTES

- SEPTIC SYSTEM SUBJECT TO HOWARD COUNTY HEALTH DEPARTMENT
- PROPOSED 1500 GALLON SEPTIC TANK. 510.62 500.62
- FIRST FLOOR ELEVATION: 502.75 502.30
- BASEMENT ELEVATION: 502.00 503.00
- INVERT OF SEPTIC SYSTEM AT HOUSE: 502.75 502.30
- INVERT IN AT SEPTIC TANK: 502.00 503.00
- INVERT OUT AT SEPTIC TANK: 501.00 504.00
- PROPOSED GRADE OVER SEPTIC TANK: 501.00 504.00
- INVERT AT DISTRIBUTION BOX: 501.00 504.00
- EXISTING GROUND OVER DISTRIBUTION BOX: 501.00 504.00
- LENGTH OF TRENCH TO BE DETERMINED AT TIME OF SEPTIC PERMIT
- ISSUANCE
- CONTRACTOR / OWNER TO VERIFY ALIQUOTS IN FIELD BEFORE BEGINNING ANY CONSTRUCTION
- THERE IS NO BASEMENT SERVICE TO SEPTIC SYSTEM

PLAN TO ACCOMPANY APPLICATION
FOR BUILDING PERMIT
VINEYARDS AT CATTAIL CREEK

LOT 1

FOURTH ELECTION DISTRICT

SCALE 1" = 30'

HOWARD COUNTY, MARYLAND

DATE MAY 23, 2000

FISHER COLLINS & CARTER, INC.
CIVIL ENGINEERING CONSULTANTS & LAND SURVEYORS
10000 SQUAKE OFFICE PARK - 10272 BALTIMORE NATIONAL, INC.
ELICOTT CITY, MARYLAND 21042
(410) 481-2855
30321