

130/01  
layout  
8/1/01 2:38  
House Conn  
04-356799

# PERMIT

SEWAGE DISPOSAL SYSTEM  
HOWARD COUNTY HEALTH DEPARTMENT  
BUREAU OF ENVIRONMENTAL HEALTH  
410-313-2640

P 515000

A 50225-GG

ISSUE DATE 3/23/01

APPROVAL DATE 8/7/01

Action One Services

IS PERMITTED TO INSTALL ☒ ALTER ☐

ADDRESS 7306 Dogwood Rd, Woodlawn, MD 21244 PHONE 410-876-4661

SUBDIVISION Vinyards at Cattail Creek LOT NUMBER 1 ADDRESS 3595 Willow Birch Drive

PROPERTY OWNER George Psoras PROPERTY OWNER'S ADDRESS 2039 Eliza Dorsey Lane

Ellicott City, MD 21042

SEPTIC TANK CAPACITY 1500 GALLONS

PUMP CHAMBER CAPACITY GALLONS

NUMBER OF BEDROOMS 5

SQUARE FEET PER BEDROOM 180

LINEAR FEET OF TRENCH REQUIRED 300

BLDG PERMIT STOP

AND RETURNED 11-8-2001

B00133216

FINISH BASEMENT, BDRM + BATH + REC ROOM  
DECK 12x14

TRENCHES: Trenches to be 3 feet wide. Inlet 3 feet below original grade. Bottom maximum depth 5 feet below original grade. 2 feet of stone below distribution box.

LOCATION: Place distribution box 25 feet off the front (325.00') lot line and 130 feet off the left (142.00') lot line, as seen when facing the lot from Willow Birch Drive. Run trenches on contour initially toward the right lot line, then in both directions.

7/27/00 O.K. (28)

PLANS APPROVED Amy McMillen DATE 7/17/2000

PERMIT VOID AFTER 2 YEARS

NOTE: CONTRACTOR RESPONSIBLE FOR SCHEDULING A PRE-CONSTRUCTION INSPECTION FOR ALL INSTALLATIONS

NOTE: TOP OF SEPTIC TANKS ARE TO BE NO DEEPER THAN 3.0 FEET BELOW FINISH GRADE

NOTE: WATERTIGHT SEPTIC TANKS REQUIRED

NOTE: CLEANOUT REQUIRED EVERY 70 FEET OF SEWER LINE AND/OR AT 90° SWEEPS IN LINES FROM HOUSE TO DRAIN FIELDS, 90° ELBOW ARE NOT ACCEPTABLE

NOTE: ALL PARTS OF SEPTIC SYSTEMS (I.E. TANK, DISTRIBUTION BOX, DRAINFIELDS) TO BE 100 FEET FROM ANY WATER WELL UNLESS OTHERWISE SPECIFICALLY AUTHORIZED

NOTE: NO ABSORPTION TRENCH TO EXCEED 100 FEET IN LENGTH UNLESS SPECIFICALLY AUTHORIZED

NOTE: ALL PIPE FROM HOUSE TO SEPTIC TANK MUST BE CAST IRON OR SCHEDULE 35/40 PVC OR ABS

NOTE: MANHOLE RISERS REQUIRED ON ALL SEPTIC TANKS AND PUMP CHAMBERS

NOTE: DISTRIBUTION BOXES MUST HAVE BAFFLES


NOTE: IF PUMPED SEPTIC SYSTEM REQUIRED, (1) SEPTIC PUMP DETAIL TO BE PROVIDED BY INSTALLER PRIOR TO ISSUANCE OF SEPTIC PERMIT (2) PUMP PERFORMANCE TEST IS NECESSARY PRIOR TO HEALTH DEPARTMENT APPROVAL OF SEPTIC PERMIT

NEITHER THE HOWARD COUNTY COUNCIL NOR THE HEALTH DEPARTMENT IS RESPONSIBLE FOR THE SUCCESSFUL OPERATION OF ANY SYSTEM

PERMITTEE RESPONSIBLE FOR OBTAINING FINAL APPROVAL ON THIS PERMIT  
CALL 410-313-2640 FOR INSPECTION OF SEPTIC SYSTEM

515000

NOT TO SCALE

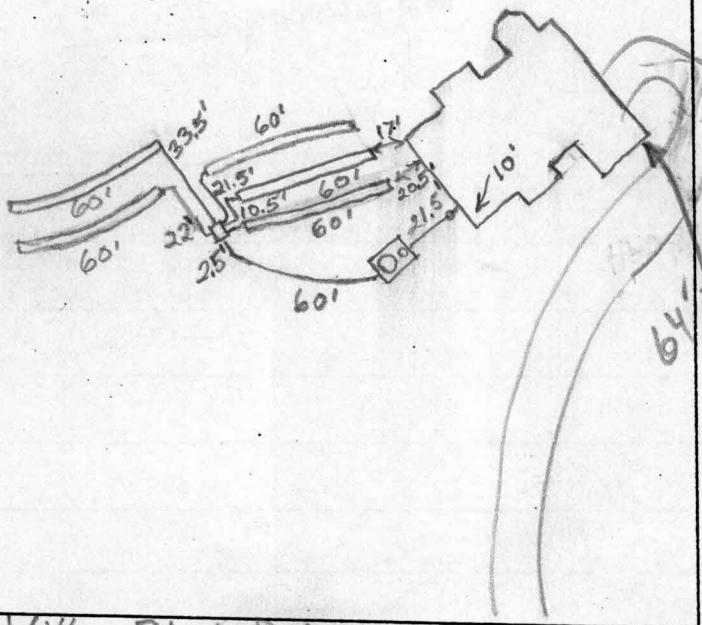

### TRENCH DATA

TRENCH WIDTH 3'  
TRENCH INLET DEPTH 3'  
TRENCH BOTTOM DEPTH 5'  
DEPTH OF STONE 2'  
NUMBER OF TRENCHES 5  
TOTAL TRENCH LENGTH 300'  
ABSORBENT AREA 900 sq. ft.  
DISTRIBUTION BOX LEVEL Yes  
BAFFLE IN DISTRIBUTION BOX Yes

### SEPTIC TANK DATA

SEPTIC TANK 1250 TS GALLONS  
MANHOLE RISER Yes  
6 INCH INSPECTION PORT Yes

### PUMP CHAMBER DATA N/A

~~PUMP CHAMBER  
GALLONS \_\_\_\_\_  
MANHOLE RISER \_\_\_\_\_  
ALARM \_\_\_\_\_  
PUMP PERFORMANCE TEST \_\_\_\_\_~~

Willow Birch Drive  
PRE-CONSTRUCTION INSPECTION: 4/30/01 Was layout done. Don't see any  
easement stakes. BB

INSPECTION COMMENTS: 4/30/01 No house connection. When was layout done?  
No wall check. O.K. to cover. Well may be too close to driveway BB  
5/1/01. Spoke to builder about inspection procedures. Installer was notified BB  
8/7/01 HOUSE CONN OK (MR)

INSPECTOR M. Rifkin DATE SYSTEM APPROVED 8/7/01