


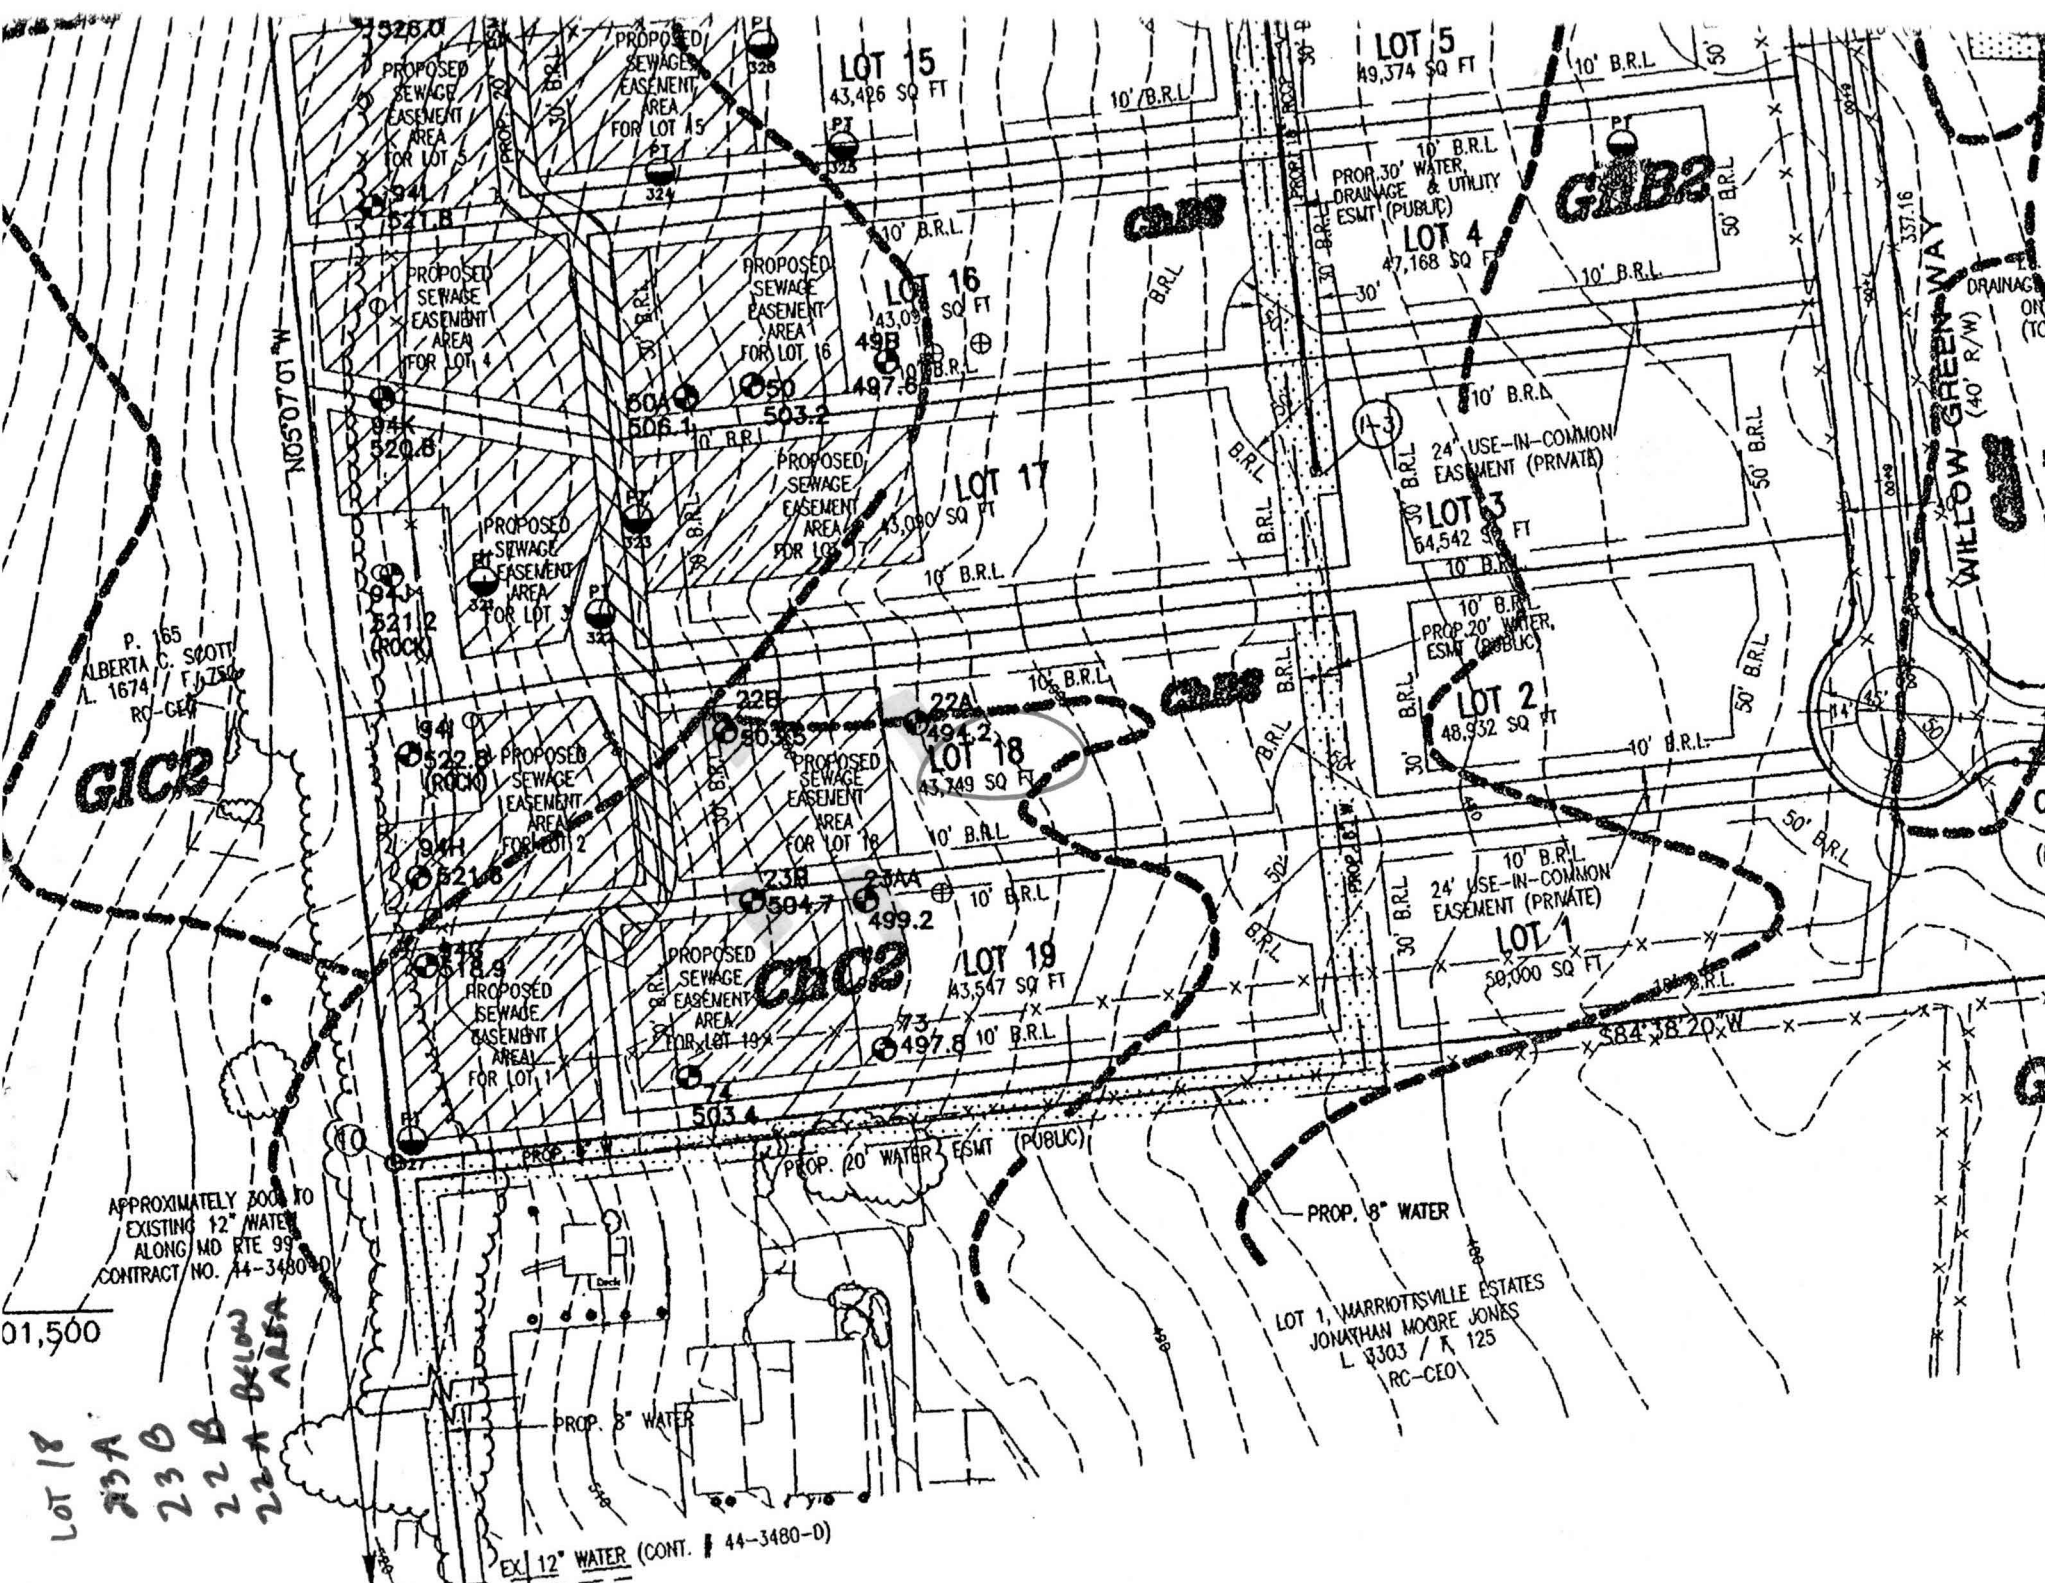

P. 165
ALBERTA C. SCOTT
L. 1674 / F. 750
RC-CEA

GIC2

APPROXIMATELY 300' TO
EXISTING 12" WATER
ALONG MD RTE 99
CONTRACT NO. 44-3480-0

01,500

LOT 18
23A
23B
22A
22B
22A BELOW AREA

EX 12" WATER (CONT. # 44-3480-0)

LOT 1, WARRIOTTSVILLE ESTATES
JONATHAN MOORE JONES
L. 3303 / R. 125
RC-CEO

WILLOW GREEN WAY
(40' R/W)