


1001202 70
Propane Tank
location
OK
6/13/01
Aur Me

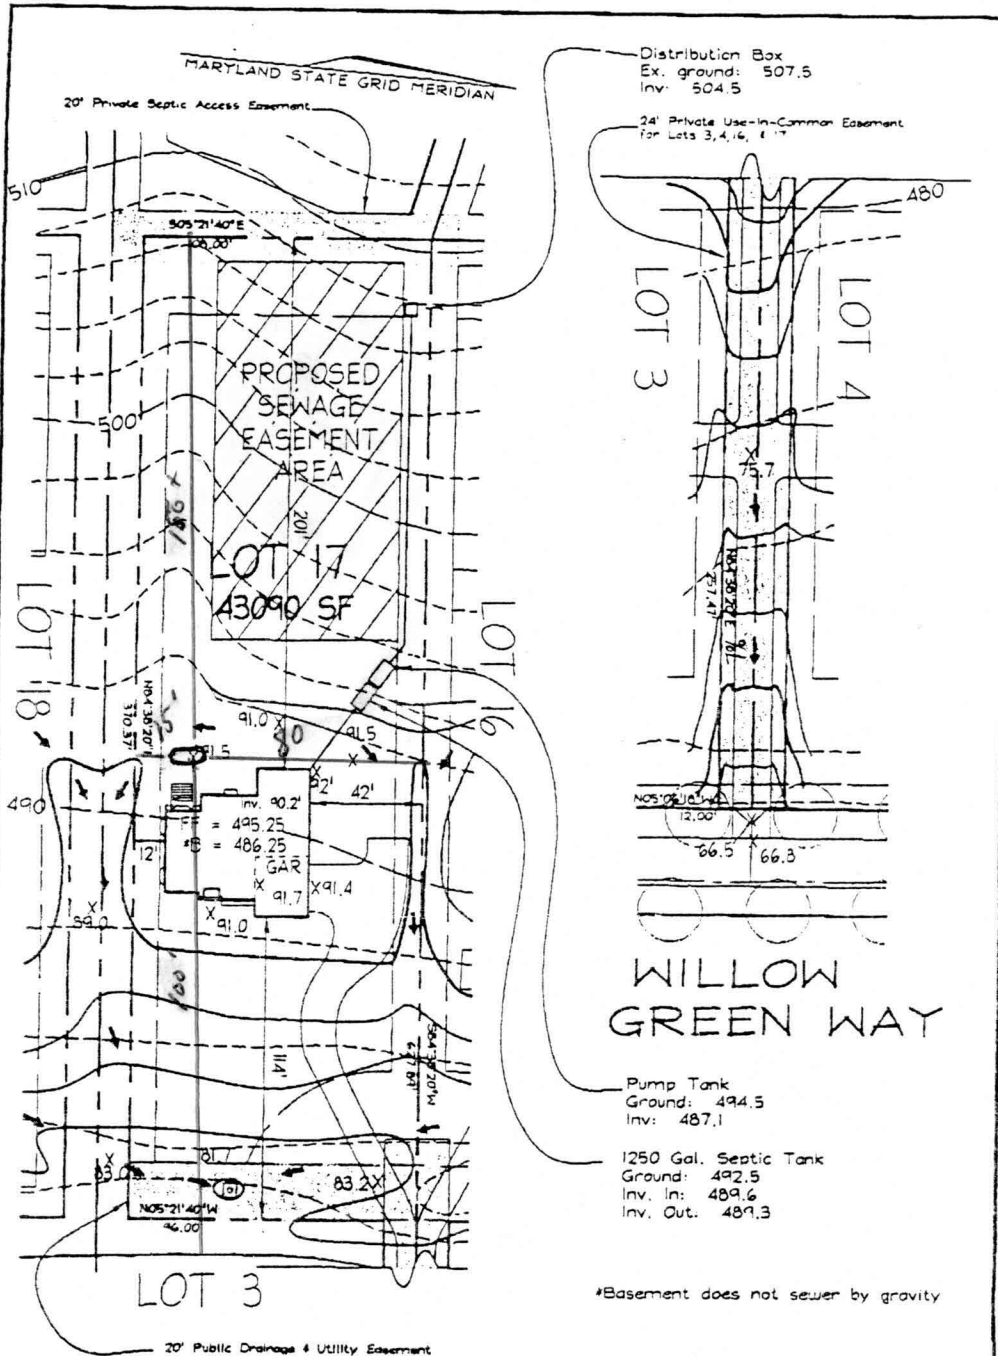

*Basement does not sewer by gravity

PREPARED FOR
TRINITY HOMES, Inc.
7320 Grace Drive
Columbia, Maryland 21044

VOGEL & ASSOCIATES
ENGINEERS • SURVEYORS • PLANNERS

3691 Park Avenue, Suite 101 • Ellicott City, Maryland 21043
Tel 410.461.5823 Fax 410.465.3966

SCALE 1"=50'
DRAWN BY MM
CHECKED BY JCO
DATE October 6, 2000
W. O. # 98-097

PLOT PLAN LOT 17 WOODFORDS GRANT III


TAX MAP 10 BLOCK 22 REFERENCE PLAT'S 13800-13802
PARCEL 293 3rd ELECTION DISTRICT HOWARD COUNTY, MARYLAND

MARYLAND STATE GRID MERIDIAN

20' Private Septic Access Easement


Distribution Box
Ex. ground: 507.5
Inv: 504.5

24' Private Use-In-Common Easement
for Lots 3,4,16, & 17.

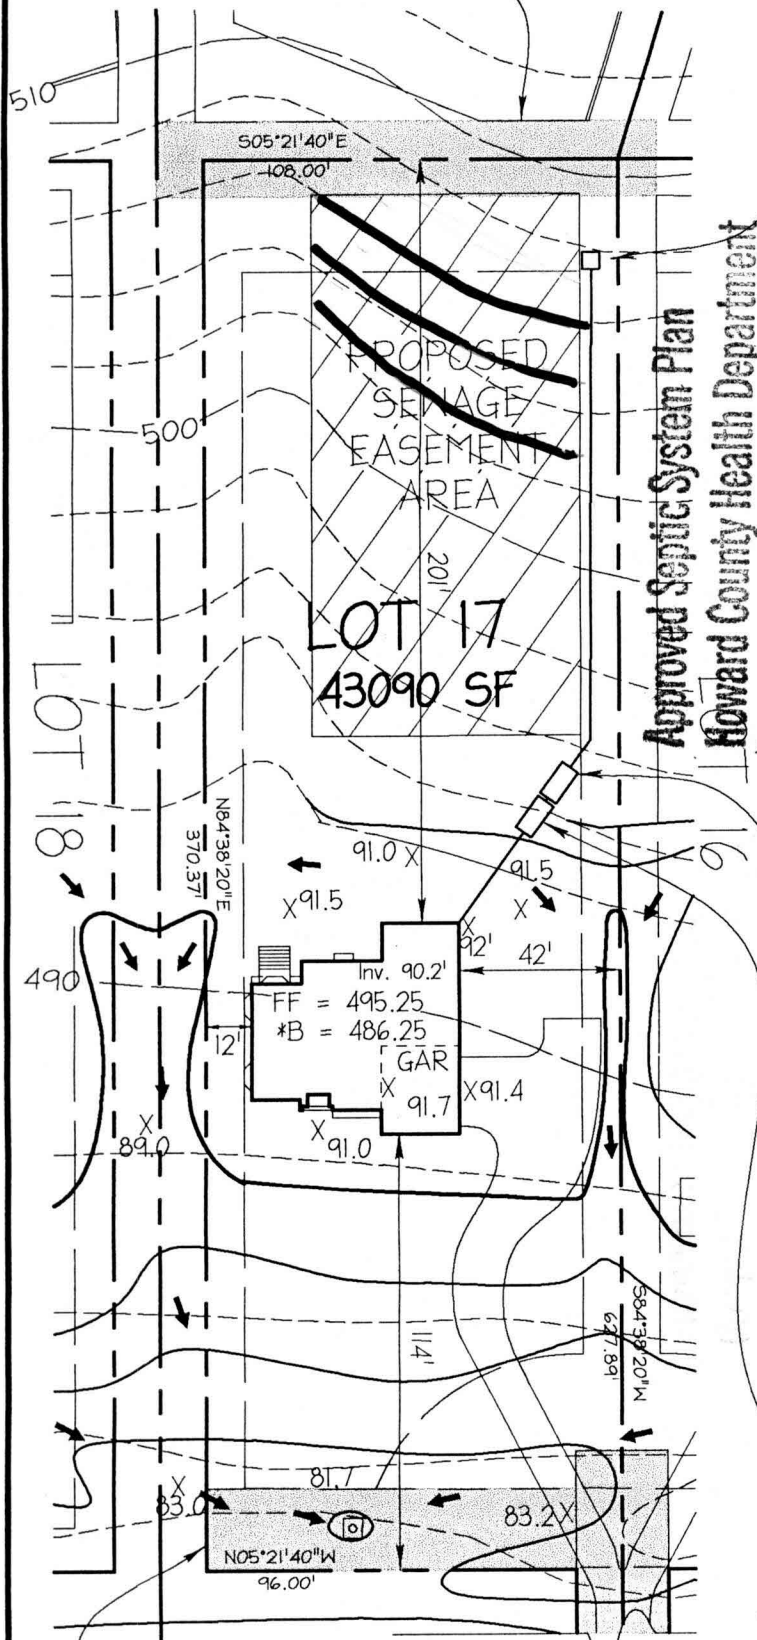

Approved Septic System Plan
Howard County Health Department

10/3/00
E
Mark P. Phipps
Signature

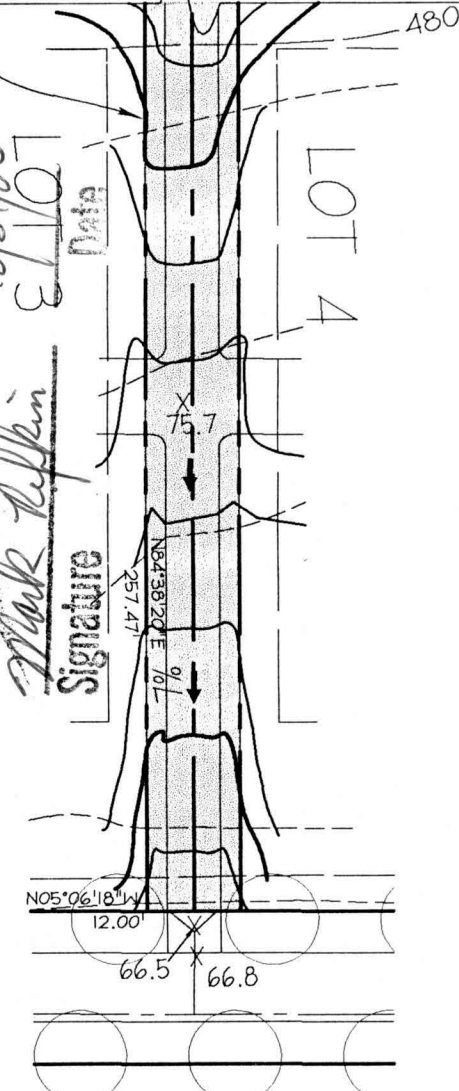

WILLOW
GREEN WAY

Pump Tank
Ground: 494.5
Inv: 487.1

1250 Gal. Septic Tank
Ground: 492.5
Inv. In: 489.6
Inv. Out: 489.3

ADJUST TANKS TO PROVIDE NO
MORE THAN 3' COVER
*Basement does not sewer by gravity

Total linear feet of trench
required 240 feet

Width of trench(es) 3 feet

Depth of trench(es) 5 feet

PREPARED FOR
TRINITY HOMES, Inc.
7320 Grace Drive
Columbia, Maryland 21044

Depth of stone required below
distribution pipe 2 feet

SCALE 1"=50'
DRAWN BY MM
CHECKED BY JCO
DATE October 6, 2000
W. O. # 98-097

PLOT PLAN
LOT 17
WOODFORDS GRANT III

TAX MAP 10 BLOCK 22 REFERENCE PLAT'S 13800-13802
PARCEL 293 3rd ELECTION DISTRICT HOWARD COUNTY, MARYLAND

VOGEL & ASSOCIATES
ENGINEERS • SURVEYORS • PLANNERS

3691 Park Avenue, Suite 101 • Ellicott City, Maryland 21043
Tel 410.461.5828 Fax 410.465.3966