

APPLICATION

PERCOLATION TESTING

A 58589

P _____

HOWARD COUNTY HEALTH DEPARTMENT
BUREAU OF ENVIRONMENTAL HEALTH
3525-H ELLICOTT MILLS DRIVE/ELLICOTT CITY, MARYLAND 21043
TELEPHONE: 313-2640

DISTRICT _____

DATE 7/29/97

TO: THE COUNTY HEALTH OFFICER
ELLICOTT CITY, MARYLAND

I HEREBY APPLY FOR THE NECESSARY TEST PRIOR TO APPLICATION FOR PERMIT TO CONSTRUCT (OR RECONSTRUCT) A SEWAGE DISPOSAL SYSTEM.

PROPERTY OWNER L D + D

ADDRESS 10805 Hickory Ridge Rd Suite 205 Cal MD 21044 PHONE 410-740-2600

AGENT OR PROSPECTIVE BUYER LAND DESIGN & DEVELOPMENT

ADDRESS 10805 Hickory Ridge Rd Suite 205 Cal MD 21044 PHONE 410-740-2600

PROPERTY LOCATION:

SUBDIVISION Willow Wood LOT NO. _____

ROAD AND DESCRIPTION Marriottsville Rd

TAX MAP 10 PARCEL # 293

SIZE OF LOT 1 acre TYPE BLDG. SFD
(SINGLE FAMILY DWELLING OR COMMERCIAL)

THE SYSTEM INSTALLED UNDER THIS APPLICATION IS ACCEPTABLE ONLY UNTIL PUBLIC FACILITIES BECOME AVAILABLE. I FULLY UNDERSTAND THE FEE CONNECTED WITH THE FILING OF THIS PERC TEST APPLICATION IS NON-REFUNDABLE UNDER ANY CIRCUMSTANCES. I ALSO AGREE TO COMPLY WITH ALL M.O.S.H.A. REQUIREMENTS IN TESTING THIS LOT.

(SIGNATURE OF APPLICANT)

APPROVED BY _____ FOR _____ DATE _____

DISAPPROVED BY _____ FOR _____ DATE _____

HOLD PENDING FURTHER TESTS _____

REASONS FOR REJECTION OR HOLDING _____






PERCOLATION TEST PLAT/PRELIMINARY PLAT - TITLE OR I.D. # _____ DATE _____

SITE DEVELOPMENT PLAN/FINAL PLAT - TITLE OR I.D. # _____ DATE _____

THIS IS NOT A PERMIT

7/2/92)

A 58589
COUNTY #

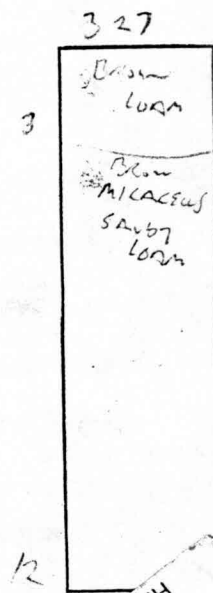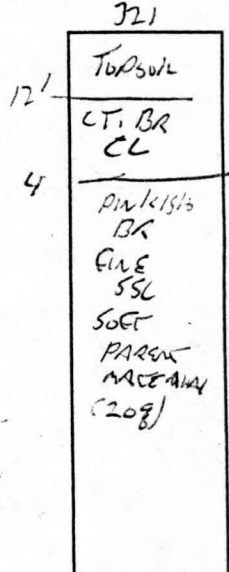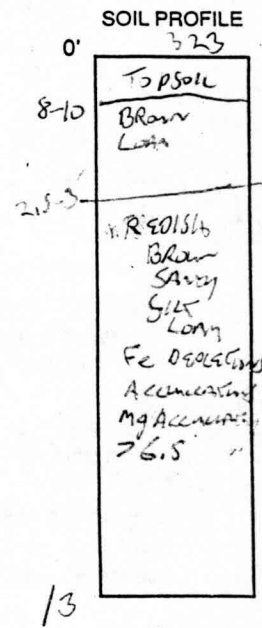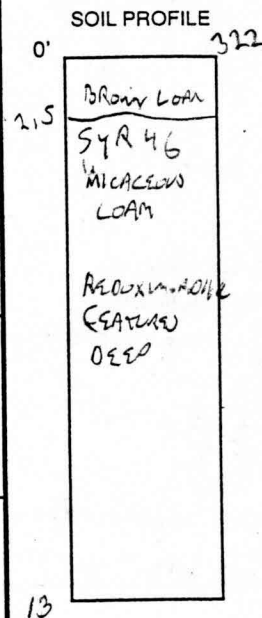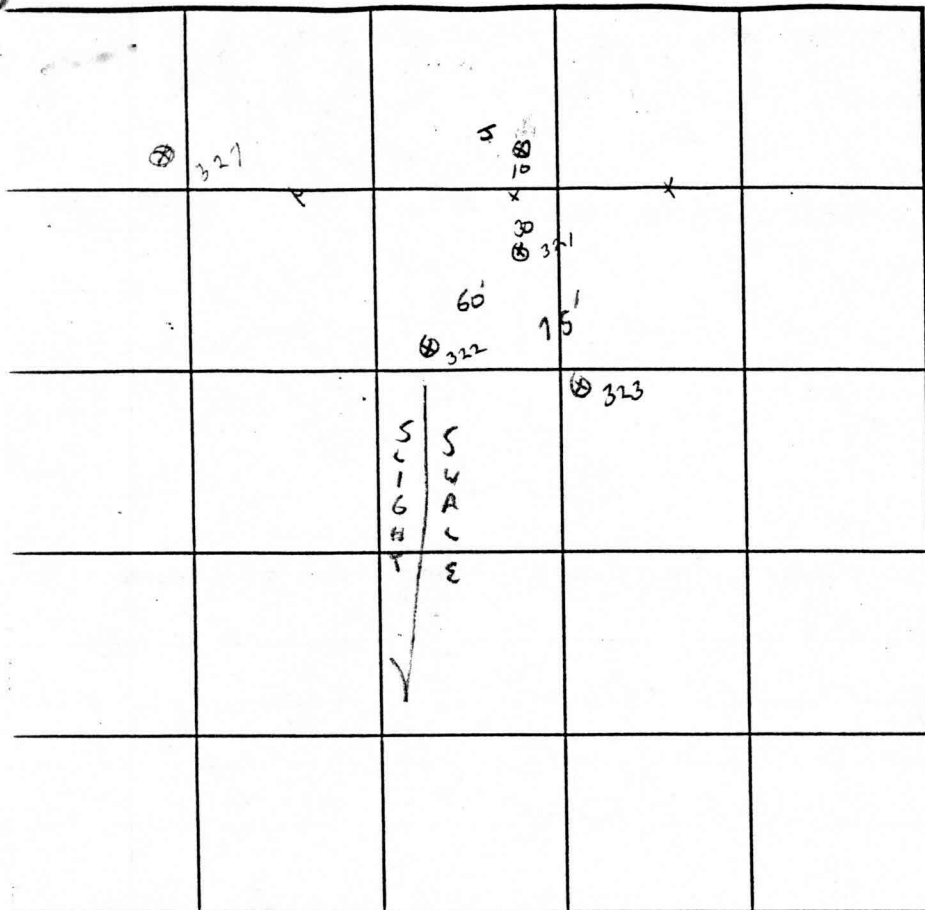

INDICATE NORTH - NAME ADJOINING ROADWAY AS BASE LINE.

DATE	TEST NO.	DEPTH	PRE-WET		TEST - 1" DROP		TIME
			START	STOP	START	STOP	
3/2/98	322	13'	OK				
	323	13'	OK				
	321	13'	OK				
	327	12'					

REMARKS: SUPPLEMENTAL TESTING TO CAPTAIN CURRENT ANALYSIS


TYPE OF SOIL


TESTED BY G. SAVAGE ALSO PRESENT BOB STEENHUY

TRENCH DESIGN DATA: AVERAGE PERCOLATION TIME TRENCH WIDTH

INLET DEPTH MAXIMUM BOTTOM DEPTH SQ. FT./BEDROOM

12-21-98

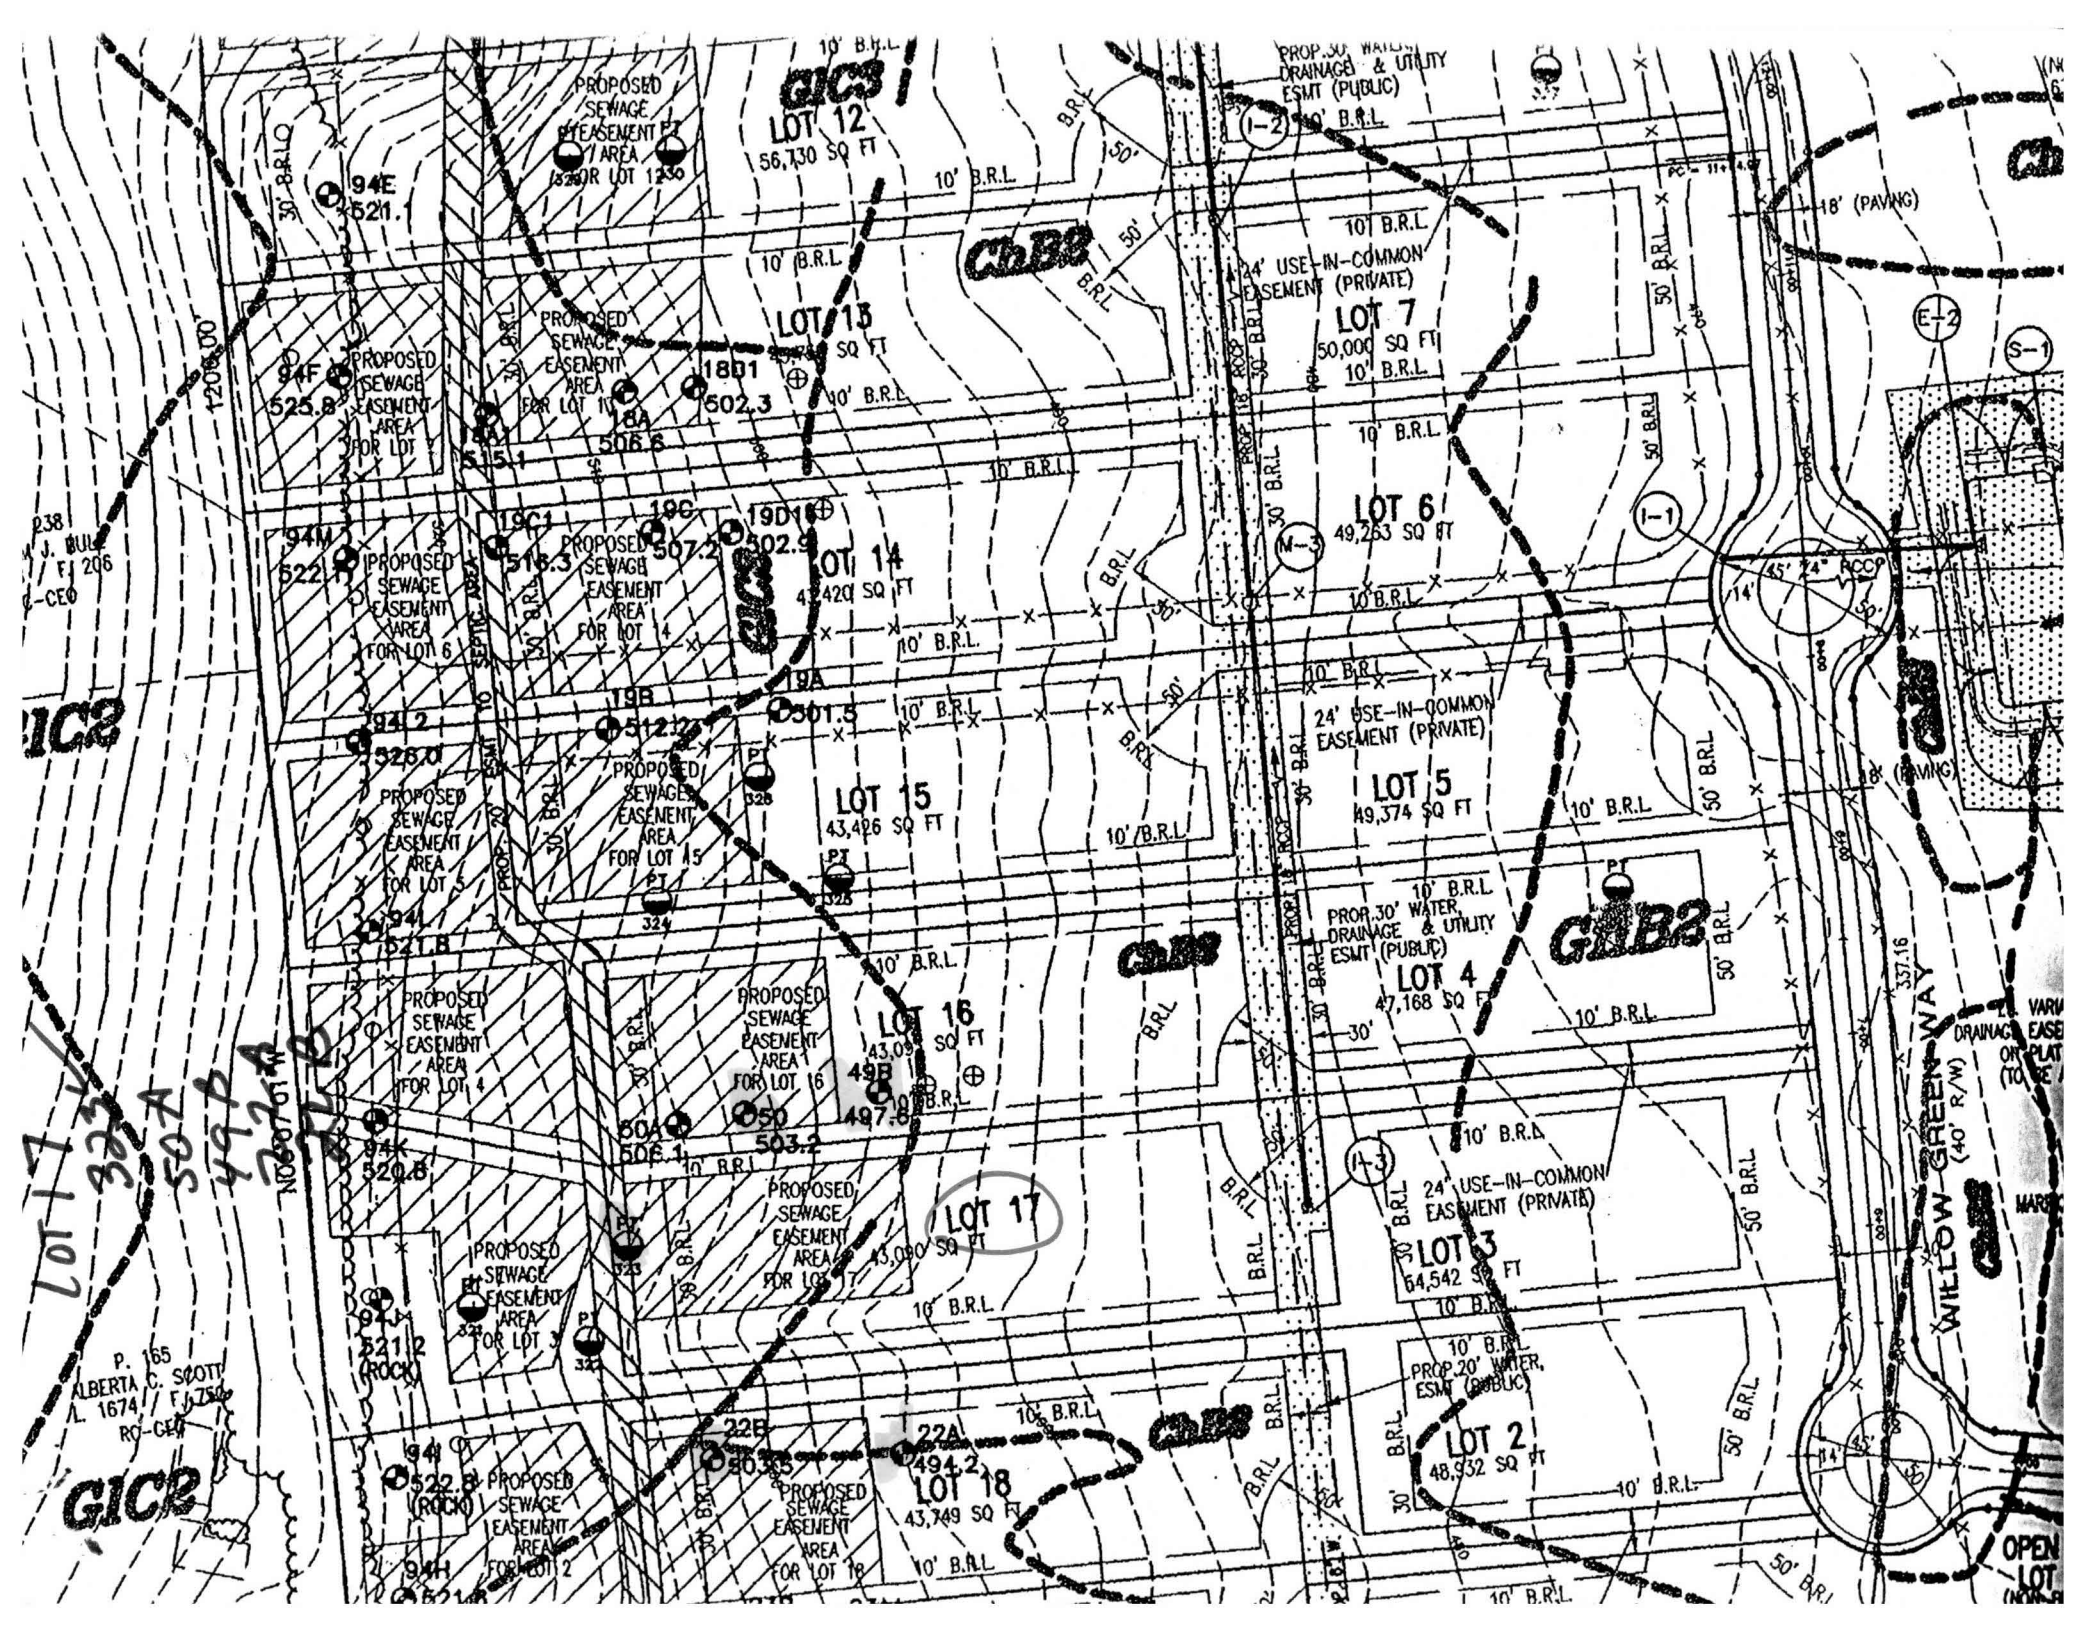

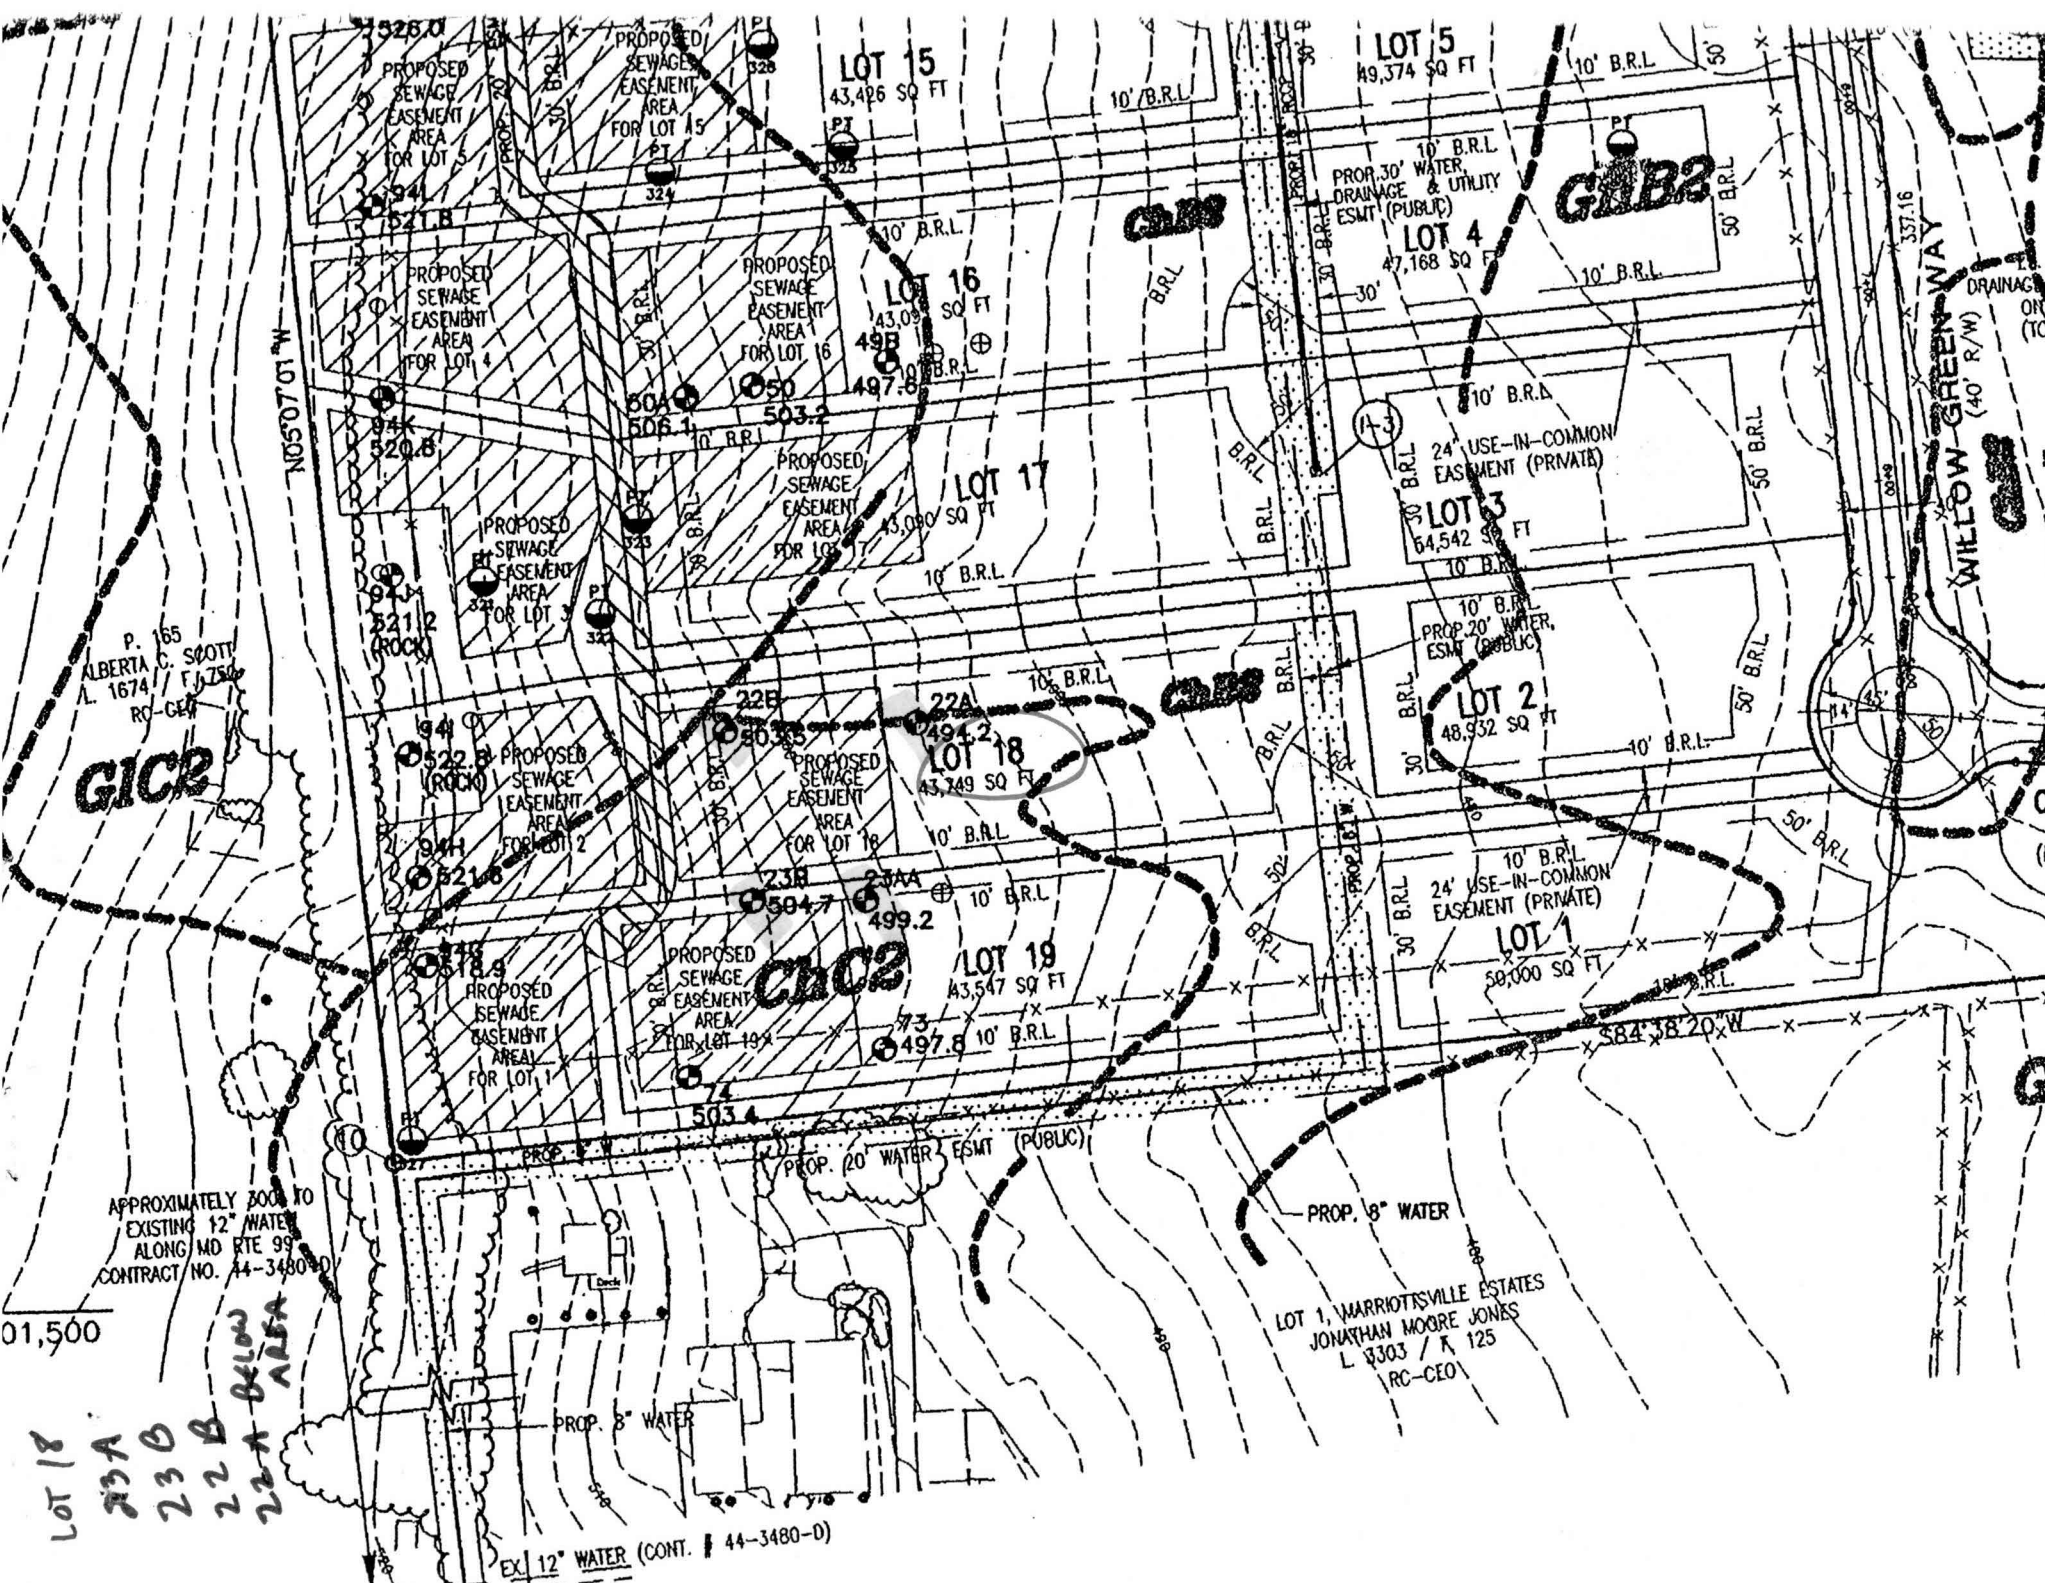

P. 165
ALBERTA C. SCOTT
L. 1674 / F. 750
RC-CEA

GIC2

APPROXIMATELY 300' TO
EXISTING 12" WATER
ALONG MD RTE 99
CONTRACT NO. 44-3480-0

01,500

LOT 18
23A
23B
22A
22B
22A BELOW AREA

EX 12" WATER (CONT. # 44-3480-0)

LOT 1, WARRIOTTSVILLE ESTATES
JONATHAN MOORE JONES
L. 3303 / R. 125
RC-CEO

WILLOW GREEN WAY
(40' R/W)
DRAINAGE ON (TC)

N05°07'01"W

PROPOSED
SEWAGE
EASEMENT
AREA

PROPOSED
SEWAGE
EASEMENT
AREA

LOT 19

LOT 18

LOT 16

LOT 15

FF = 495.0
B = 486.0
91.5
GAR

FF = 495.5
B = 486.5
92.0
GAR

FF = 495.25
B = 486.25
91.7
GAR

FF = 497.0
B = 488.0
93.5
GAR

FF = 494.0
B = 484.0
94.0
GAR

LOT 1

LOT 2

LOT 3

LOT 4

LOT 5

FF = 482.0
B = 473.0
79.0
GAR

FF = 482.0
B = 473.0
79.0
GAR

FF = 481.5
B = 473.0
77.5
GAR

FF = 481.5
B = 471.0
77.2
GAR

FF = 476.0
B = 471.0
76.0
GAR

EX. 470 BOTTOM PITCH
PROP DN 471.5

S84°38'20"W

66.5 66.9