

PERMIT

SEWAGE DISPOSAL SYSTEM
HOWARD COUNTY HEALTH DEPARTMENT
BUREAU OF ENVIRONMENTAL HEALTH
410-313-2640

P 515233-B

A 58993-EE

ISSUE DATE 5/9/01

APPROVAL DATE 5/11/01

04-364538

INDEXED

Hatfield's Equipment IS PERMITTED TO INSTALL ☒ ALTER ☐

ADDRESS 13785 Burntwoods Road, Glenelg, MD 21737 PHONE 301-854-6172

UBDIVISION Cattail Ridge LOT NUMBER 29 ADDRESS 3505 Winding Path Court

PROPERTY OWNER ^{GOTTLEIB} Williamsburg Group LLC PROPERTY OWNER'S ADDRESS P O Box 1018 (21044)

SEPTIC TANK CAPACITY 1250 GALLONS * TOP SEAMED SEPTIC TANK REQUIRED *

PUMP CHAMBER CAPACITY N/A GALLONS

NUMBER OF BEDROOMS 4

SQUARE FEET PER BEDROOM 180

LINEAR FEET OF TRENCH REQUIRED 240

TRENCHES: Trenches to be 3 feet wide. Inlet, 3 feet below original grade. Bottom maximum depth

5 feet below original grade. 2 feet of stone below distribution box pipe.

LOCATION: Place the distribution box 130 feet off the front lot line and 110 feet off the

left lot line as seen from the road. Run first trench along contour toward the road; run

all other trenches along contour in both directions. 2/21/01 OK BB

PLANS APPROVED Donna K Clark, R.S. DATE 2/7/2001

PERMIT VOID AFTER 2 YEARS

NOTE: CONTRACTOR RESPONSIBLE FOR SCHEDULING A PRE-CONSTRUCTION INSPECTION FOR ALL INSTALLATIONS

NOTE: TOP OF SEPTIC TANKS ARE TO BE NO DEEPER THAN 3.0 FEET BELOW FINISH GRADE

NOTE: WATERTIGHT SEPTIC TANKS REQUIRED

NOTE: CLEANOUT REQUIRED EVERY 70 FEET OF SEWER LINE AND/OR AT 90° SWEEPS IN LINES FROM HOUSE TO DRAIN FIELDS, 90° ELBOWS ARE NOT ACCEPTABLE

NOTE: ALL PARTS OF SEPTIC SYSTEMS (I.E. TANK, DISTRIBUTION BOX, DRAINFIELDS) TO BE 100 FEET FROM ANY WATER WELL UNLESS OTHERWISE SPECIFICALLY AUTHORIZED

NOTE: NO ABSORPTION TRENCH TO EXCEED 100 FEET IN LENGTH UNLESS SPECIFICALLY AUTHORIZED

NOTE: ALL PIPE FROM HOUSE TO SEPTIC TANK MUST BE CAST IRON OR SCHEDULE 35/40 PVC OR ABS

NOTE: MANHOLE RISERS REQUIRED ON ALL SEPTIC TANKS AND PUMP CHAMBERS

NOTE: DISTRIBUTION BOXES MUST HAVE BAFFLES

NOTE: IF PUMPED SEPTIC SYSTEM REQUIRED, (1) SEPTIC PUMP DETAIL TO BE PROVIDED BY INSTALLER PRIOR TO ISSUANCE OF SEPTIC PERMIT (2) PUMP PERFORMANCE TEST IS NECESSARY PRIOR TO HEALTH DEPARTMENT APPROVAL OF SEPTIC PERMIT

NEITHER THE HOWARD COUNTY COUNCIL NOR THE HEALTH DEPARTMENT IS RESPONSIBLE FOR THE SUCCESSFUL OPERATION OF ANY SYSTEM


PERMITTEE RESPONSIBLE FOR OBTAINING FINAL APPROVAL ON THIS PERMIT
CALL 410-313-2640 FOR INSPECTION OF SEPTIC SYSTEM

**BUILDING PERMIT SIGNED
AND RETURNED**

B00137652-DECK

2/12/03 B00140296 FINISH BASEMENT

NOT TO SCALE

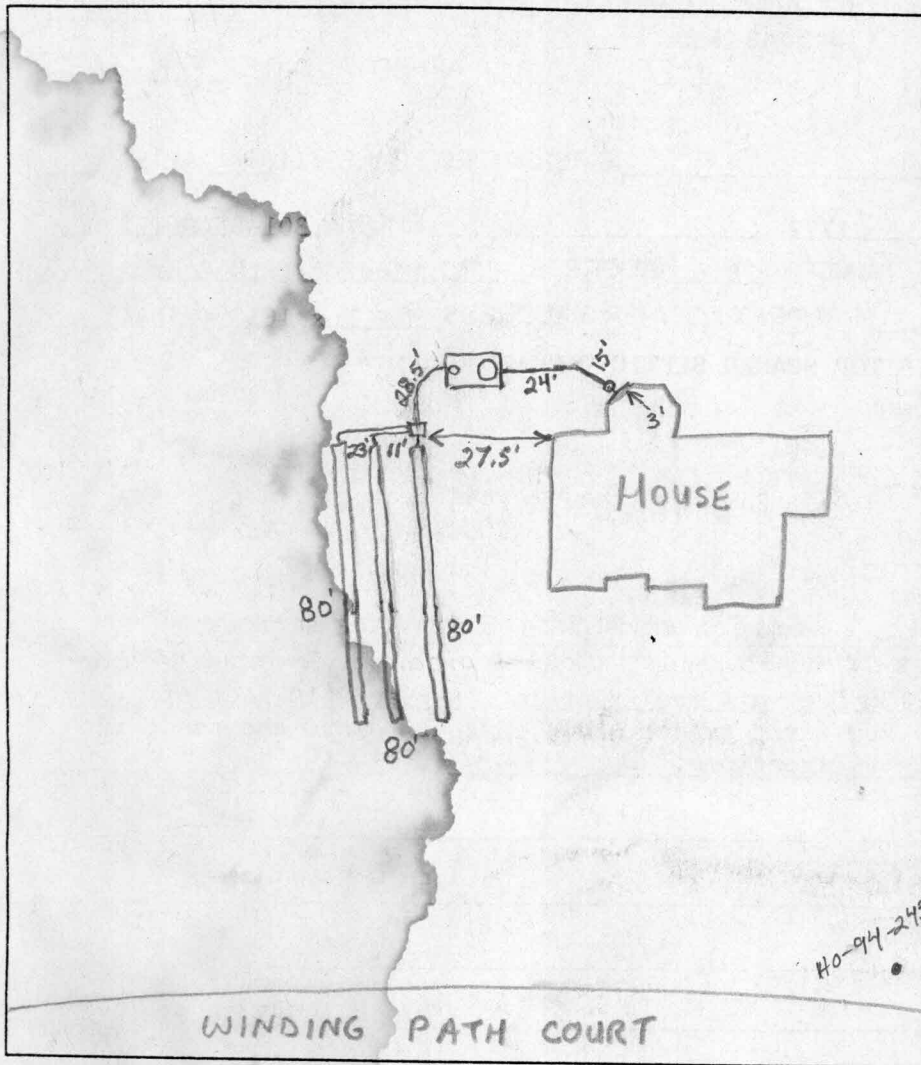

TRENCH DATA

TRENCH WIDTH 3'
TRENCH INLET DEPTH 3'
TRENCH BOTTOM DEPTH 5'
DEPTH OF STONE 2'
NUMBER OF TRENCHES 3
TOTAL TRENCH LENGTH 240'
ABSORBENT AREA 720 sq. ft.
DISTRIBUTION BOX LEVEL OK
BAFFLE IN DISTRIBUTION BOX Yes

SEPTIC TANK DATA

SEPTIC TANK 1500 TS GALLONS
MANHOLE RISER Yes
6 INCH INSPECTION PORT Yes

PUMP CHAMBER DATA N/A

~~PUMP CHAMBER
GALLONS _____
MANHOLE RISER _____
ALARM _____
PUMP PERFORMANCE TEST _____~~

PRE-CONSTRUCTION INSPECTION: 5/10/01 - OK TO SET BOX AS DISCUSSED IN FIELD AND RUN 3-80'
TRENCHES - (SRK)

5/11/01 O.K. to cover. (BB)

INSPECTION COMMENTS: _____

BUILDING PERMIT SIGNED
AND RETURNED

INSPECTOR _____

B. Baker

DATE SYSTEM APPROVED _____

5/11/01