

Approved Septic System Plan

Howard County Health Department


Total linear feet of trench required 280 feet

Width of trench(es) 3.0 feet

Depth of trench(es) 4.0 feet

Depth of stone required below distribution pipe 2.0 feet

Signature [Signature] Date 6/9/00

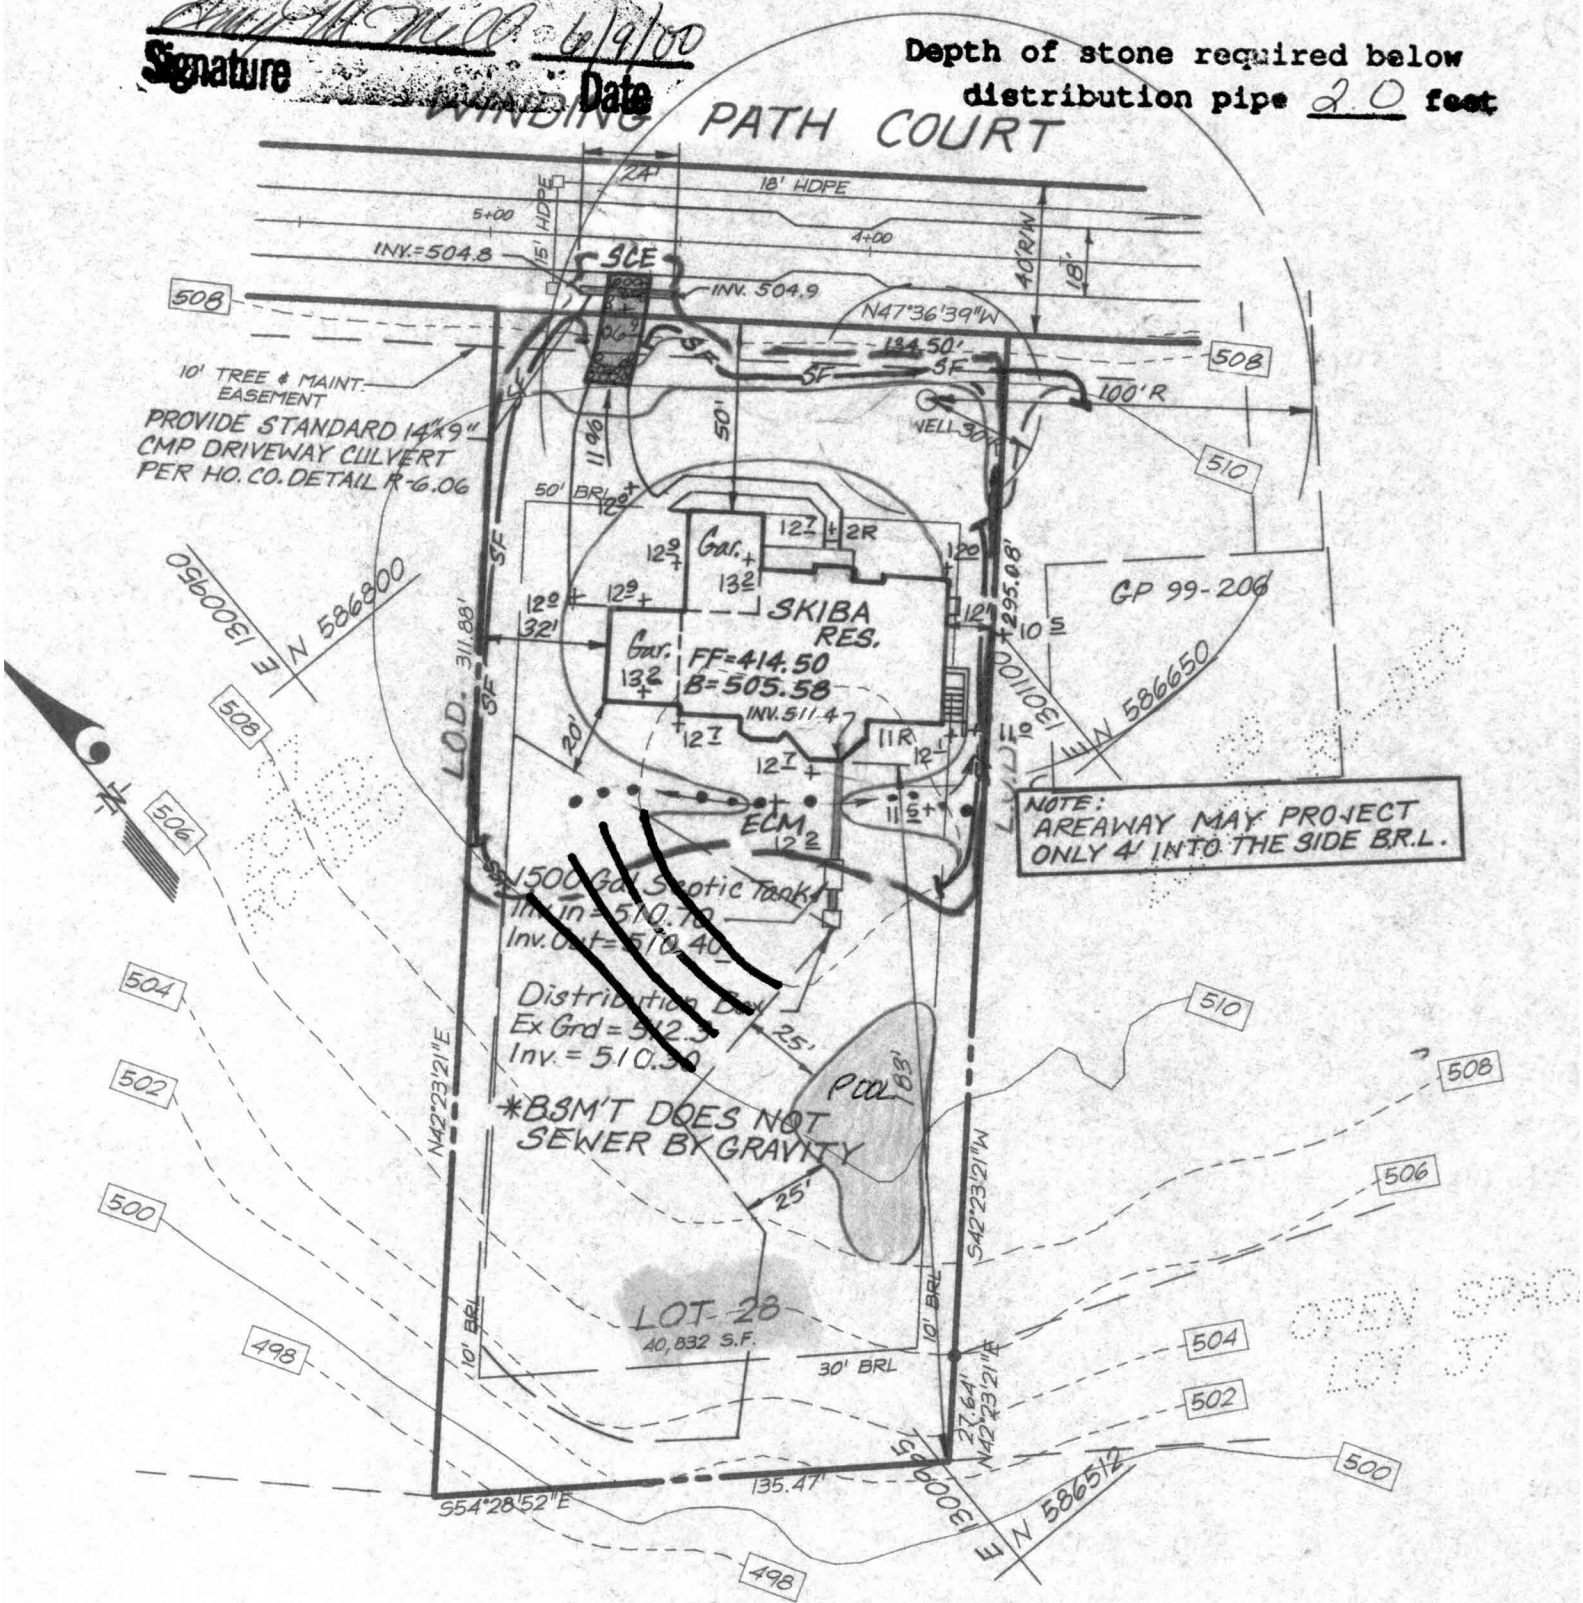

PARCEL A