
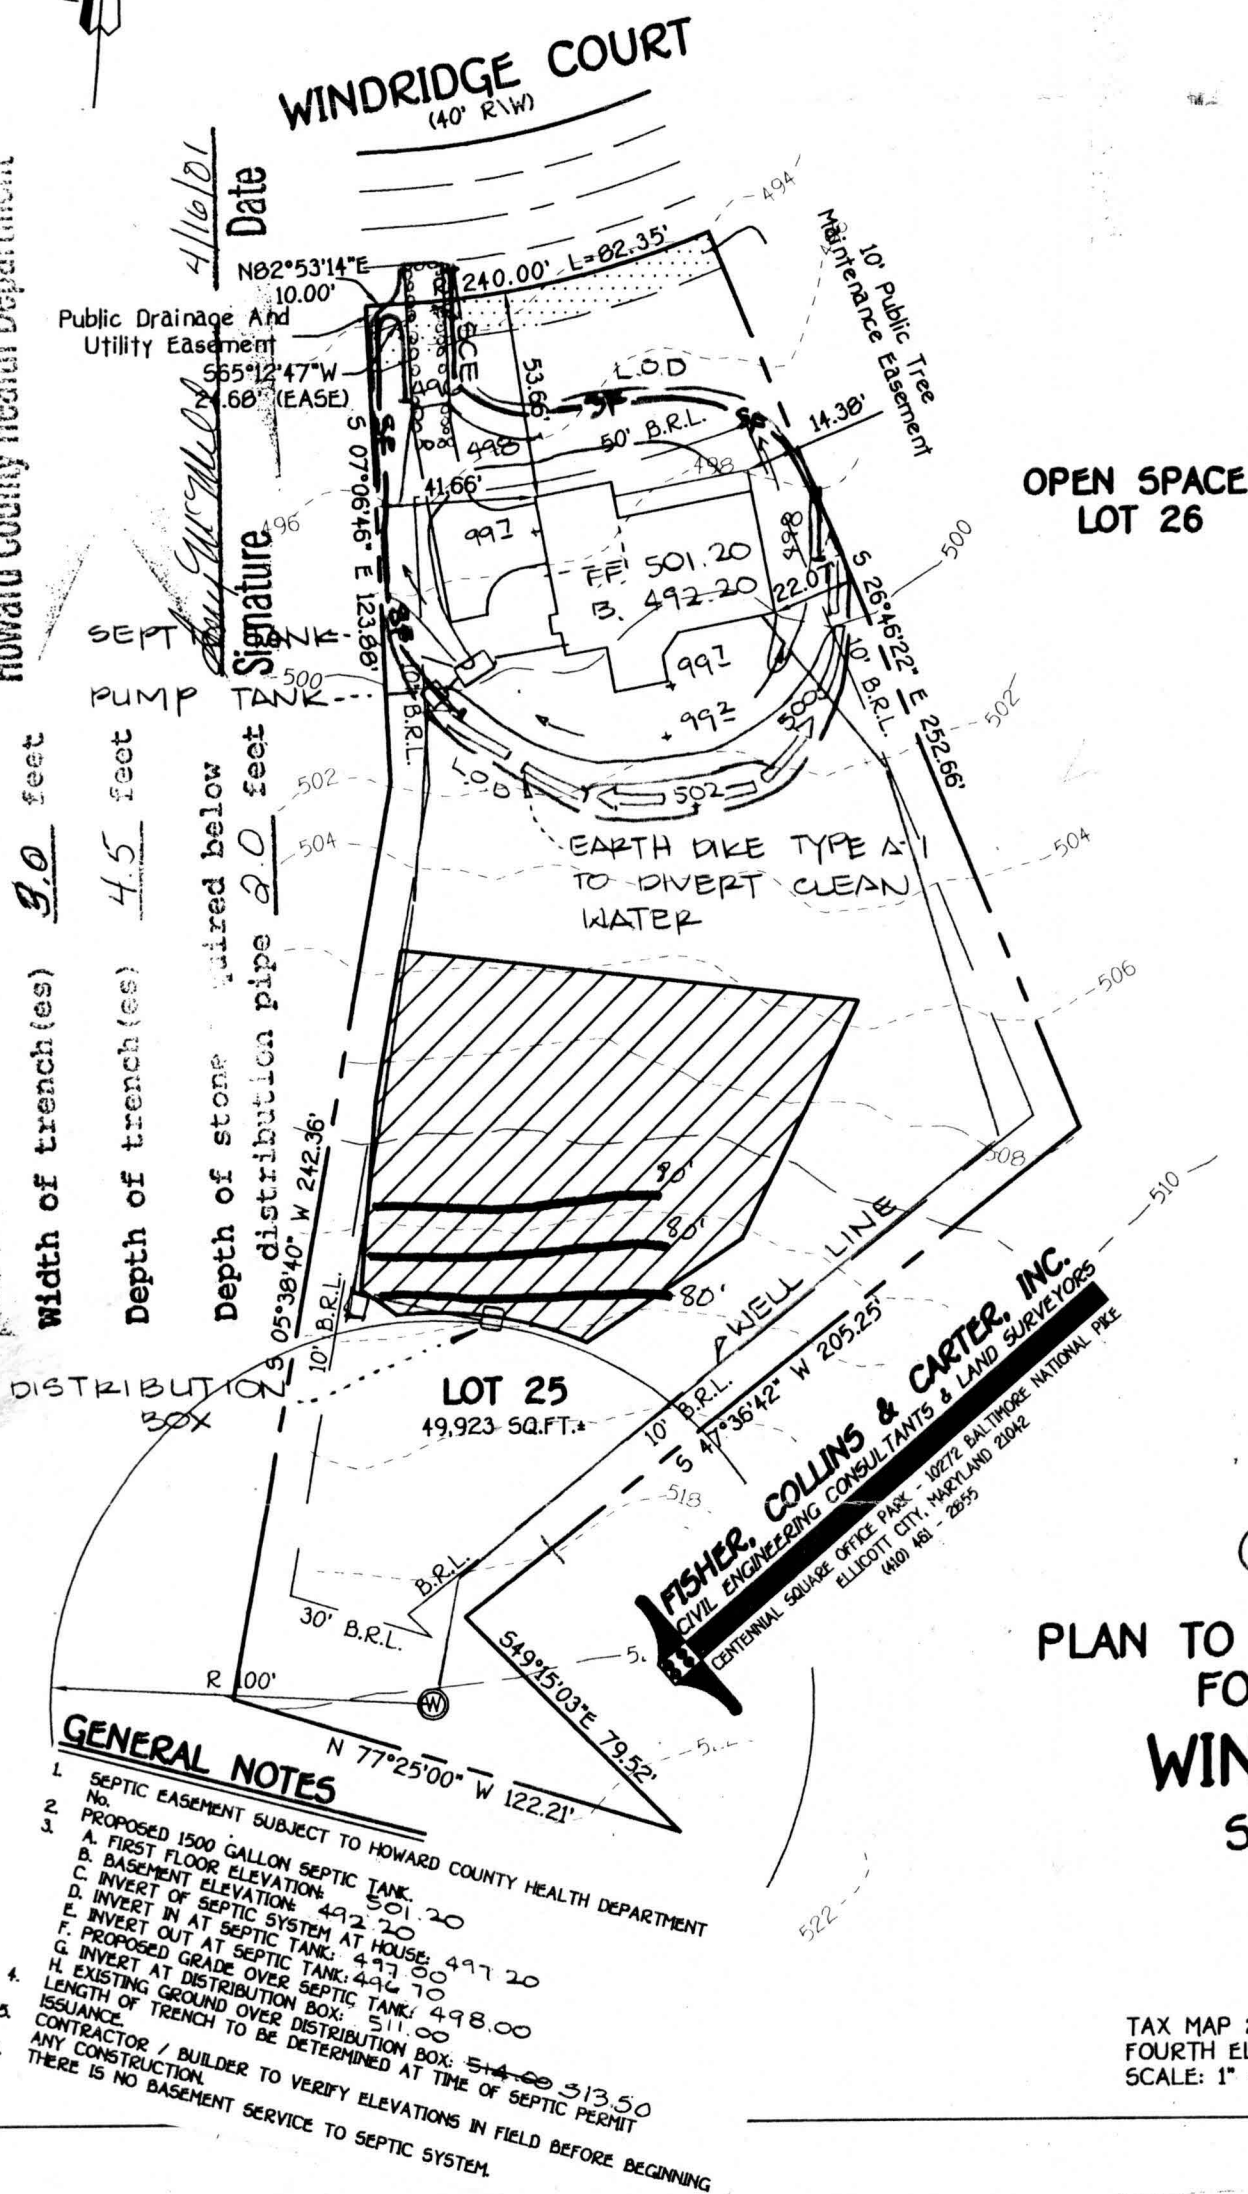


TION
 OVE
 DISTURBED
 SOUND
 VEN A
 INTO

Approved Septic System Plan
Howard County Health Department

total linear feet required 240 feet

1-20007 700177 TP10A.T.

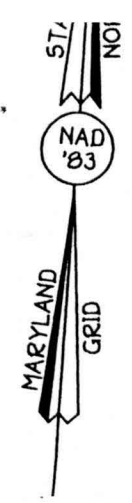

GP. 01


PLAN TO ACCOMPANY
FOR BUILDING
WINDRIDGE
SECTION 2
LOTS 8 & 9
LOT

TAX MAP 21
FOURTH ELECTION DISTRICT
SCALE: 1" = 50'

C-640

BASEMENT RENOVATION PLANS

- 1) Frame walls with 2x4 wood studs
- 2) Drywall walls and ceiling
- 3) Plumbing for bathroom and wet bar
- 4) Electrical outlets and recessed lighting
- 5) Gas Fireplace including gas line and electric

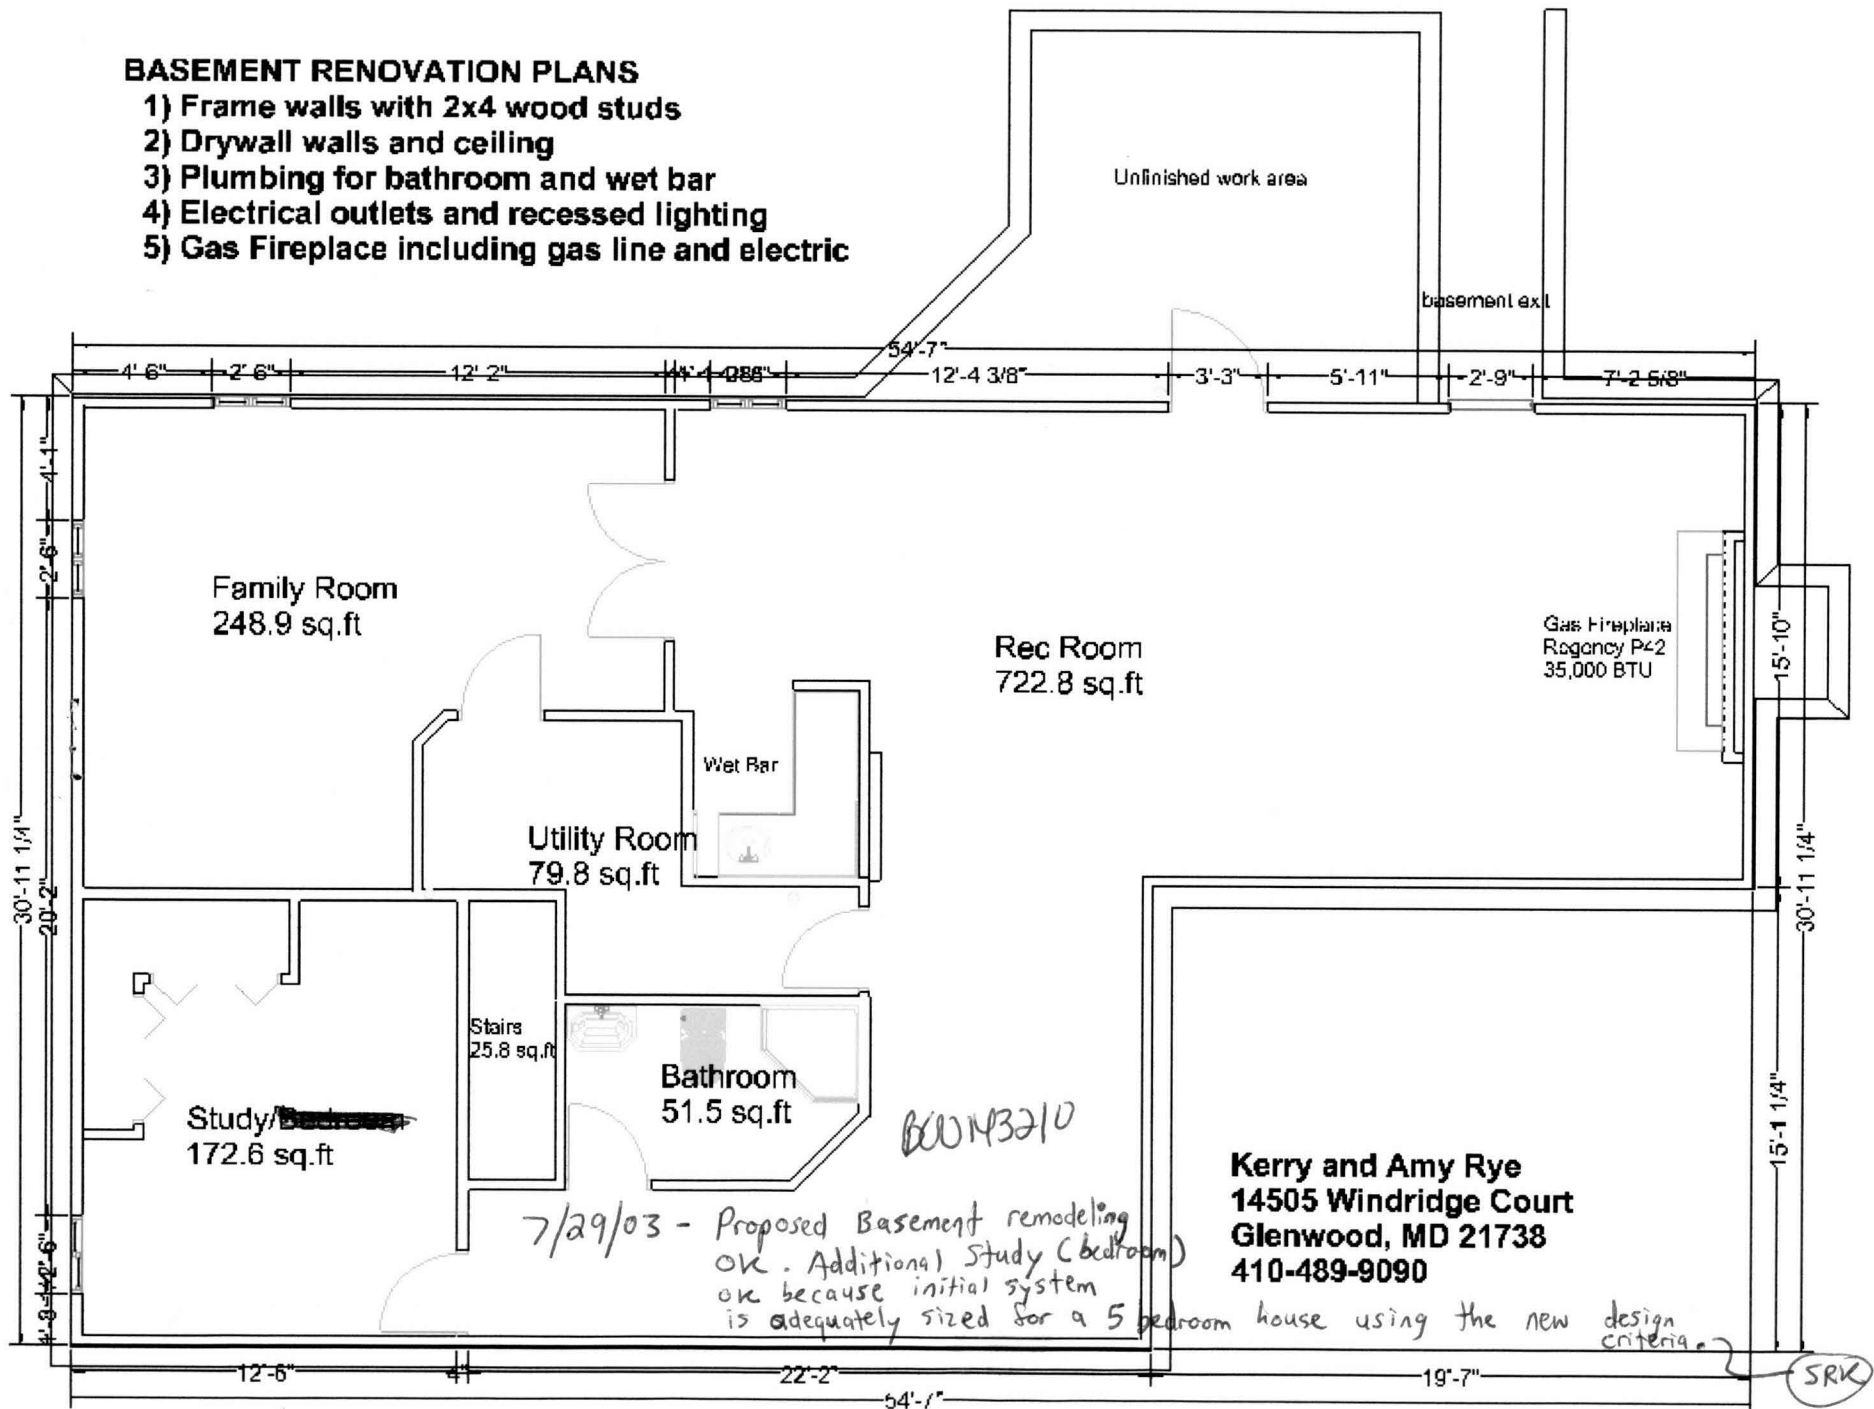

Kerry and Amy Rye
14505 Windridge Court
Glenwood, MD 21738
410-489-9090