

APPLICATION

PERCOLATION TESTING

A 58947P

P _____

HOWARD COUNTY HEALTH DEPARTMENT
BUREAU OF ENVIRONMENTAL HEALTH
3525-H ELLICOTT MILLS DRIVE/ELLICOTT CITY, MARYLAND 21043
TELEPHONE: 313-2640

DISTRICT 04

DATE _____

TO: THE COUNTY HEALTH OFFICER
ELLICOTT CITY, MARYLAND

I HEREBY APPLY FOR THE NECESSARY TEST PRIOR TO APPLICATION FOR PERMIT TO CONSTRUCT (OR RECONSTRUCT) A SEWAGE DISPOSAL SYSTEM.

PROPERTY OWNER Ray * Jane Cabbage

ADDRESS 14564 Dorsey Mill Rd. Glenely MD 21738 PHONE 410 489 7017

AGENT OR PROSPECTIVE BUYER JUSQUEHANNA LAND HOLDING CO

ADDRESS 1814 HYMAN LA CROFTON MD 21114 PHONE 410 451 5916

PROPERTY LOCATION:

SUBDIVISION Cabbage Sub. LOT NO. X6 (13)

ROAD AND DESCRIPTION _____

TAX MAP 21 PARCEL # 31

SIZE OF LOT 1+ AC. TYPE BLDG. SFD
(SINGLE FAMILY DWELLING OR COMMERCIAL)

THE SYSTEM INSTALLED UNDER THIS APPLICATION IS ACCEPTABLE ONLY UNTIL PUBLIC FACILITIES BECOME AVAILABLE. I FULLY UNDERSTAND THE FEE CONNECTED WITH THE FILING OF THIS PERC TEST APPLICATION IS NON-REFUNDABLE UNDER ANY CIRCUMSTANCES. I ALSO AGREE TO COMPLY WITH ALL M.O.S.H.A. REQUIREMENTS IN TESTING THIS LOT.

(SIGNATURE OF APPLICANT)

APPROVED BY _____ FOR _____ DATE _____

DISAPPROVED BY _____ FOR _____ DATE _____

HOLD PENDING FURTHER TESTS _____

REASONS FOR REJECTION OR HOLDING _____

PERCOLATION TEST PLAT/PRELIMINARY PLAT - TITLE OR I.D. # _____ DATE _____

SITE DEVELOPMENT PLAN/FINAL PLAT - TITLE OR I.D. # _____ DATE _____

THIS IS NOT A PERMIT

58947P

COUNTY #

SOIL PROFILE

0'

or /br
clay
loam

3.0'

tan
powdery
silt
loam
10%
shale
frags


11.0'

16B

Same
as
hole

16A

16C

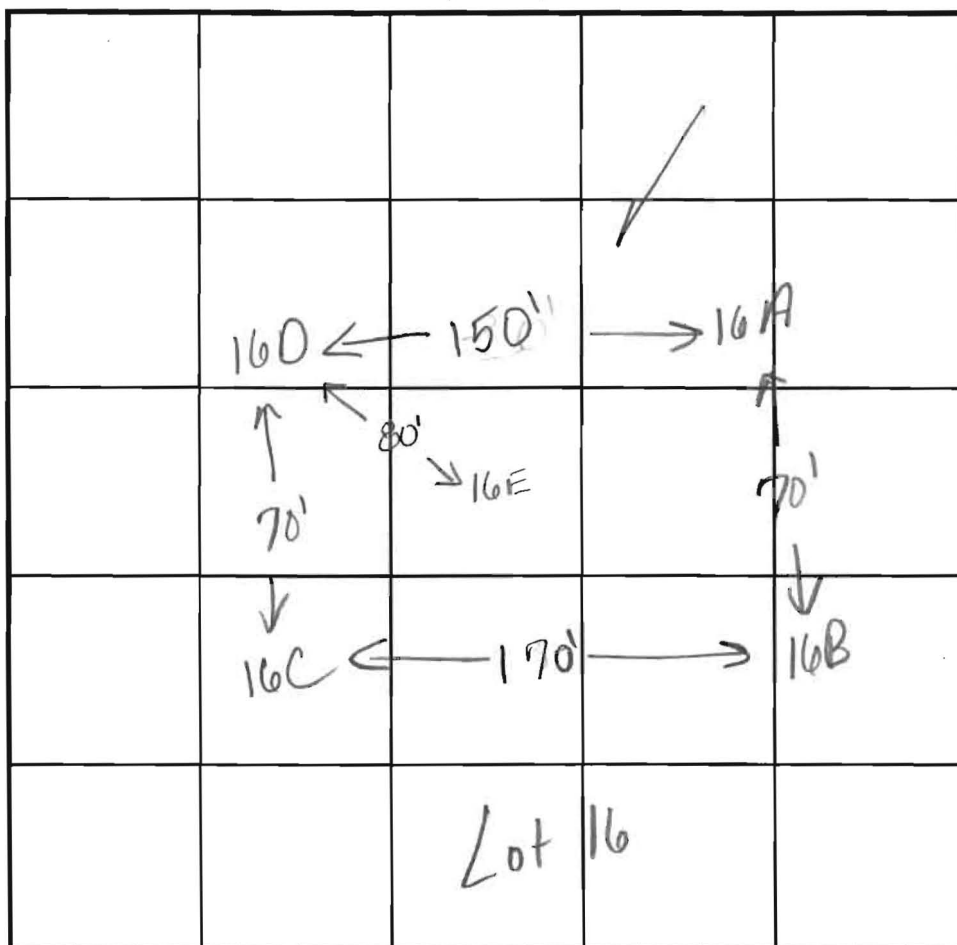Same
as
hole
#16D

INDICATE NORTH - NAME ADJOINING ROADWAY AS BASE LINE.

SOIL PROFILE

0'

or /tan
clay
loam

3.0'

br/or
silty
sand
loam
10%
shale
frags

11.5'

16E

or /br
cl /lm
or /br
silt /lm
10%
shale

3.0'

12.0'

DATE	TEST NO.	DEPTH	PRE-WET		TEST - 1" DROP		TIME
			START	STOP	START	STOP	
10/7/97	16A	2.5'S	12:50:30	12:59	12:59	1:03	4min
		6.5'S	12:55	12:57	12:57	12:59	2min
		11.0'D	visual	ok - see profile			
	16B	11.0'D	visual	only - ok see profile			
	16C	2.5'S	1:05:30	1:06:30	1:06:30	1:08	130
		11.5'D	visual	ok - see profile			
	16D	3.0'S	1:04:15	1:05	1:05	1:07	2min
		11.5'D	visual	ok - see profile			
4.28.98	16E	12.0'D	visual	only - see profile			


REMARKS test holes staked

TYPE OF SOIL


TESTED BY Kim Maiste / Kim See ALSO PRESENT Hugo + Jeff Allen

TRENCH DESIGN DATA: AVERAGE PERCOLATION TIME 2-3 minutes TRENCH WIDTH 3

INLET DEPTH 2.5 MAXIMUM BOTTOM DEPTH 4.5 SQ. FT./BEDROOM 180

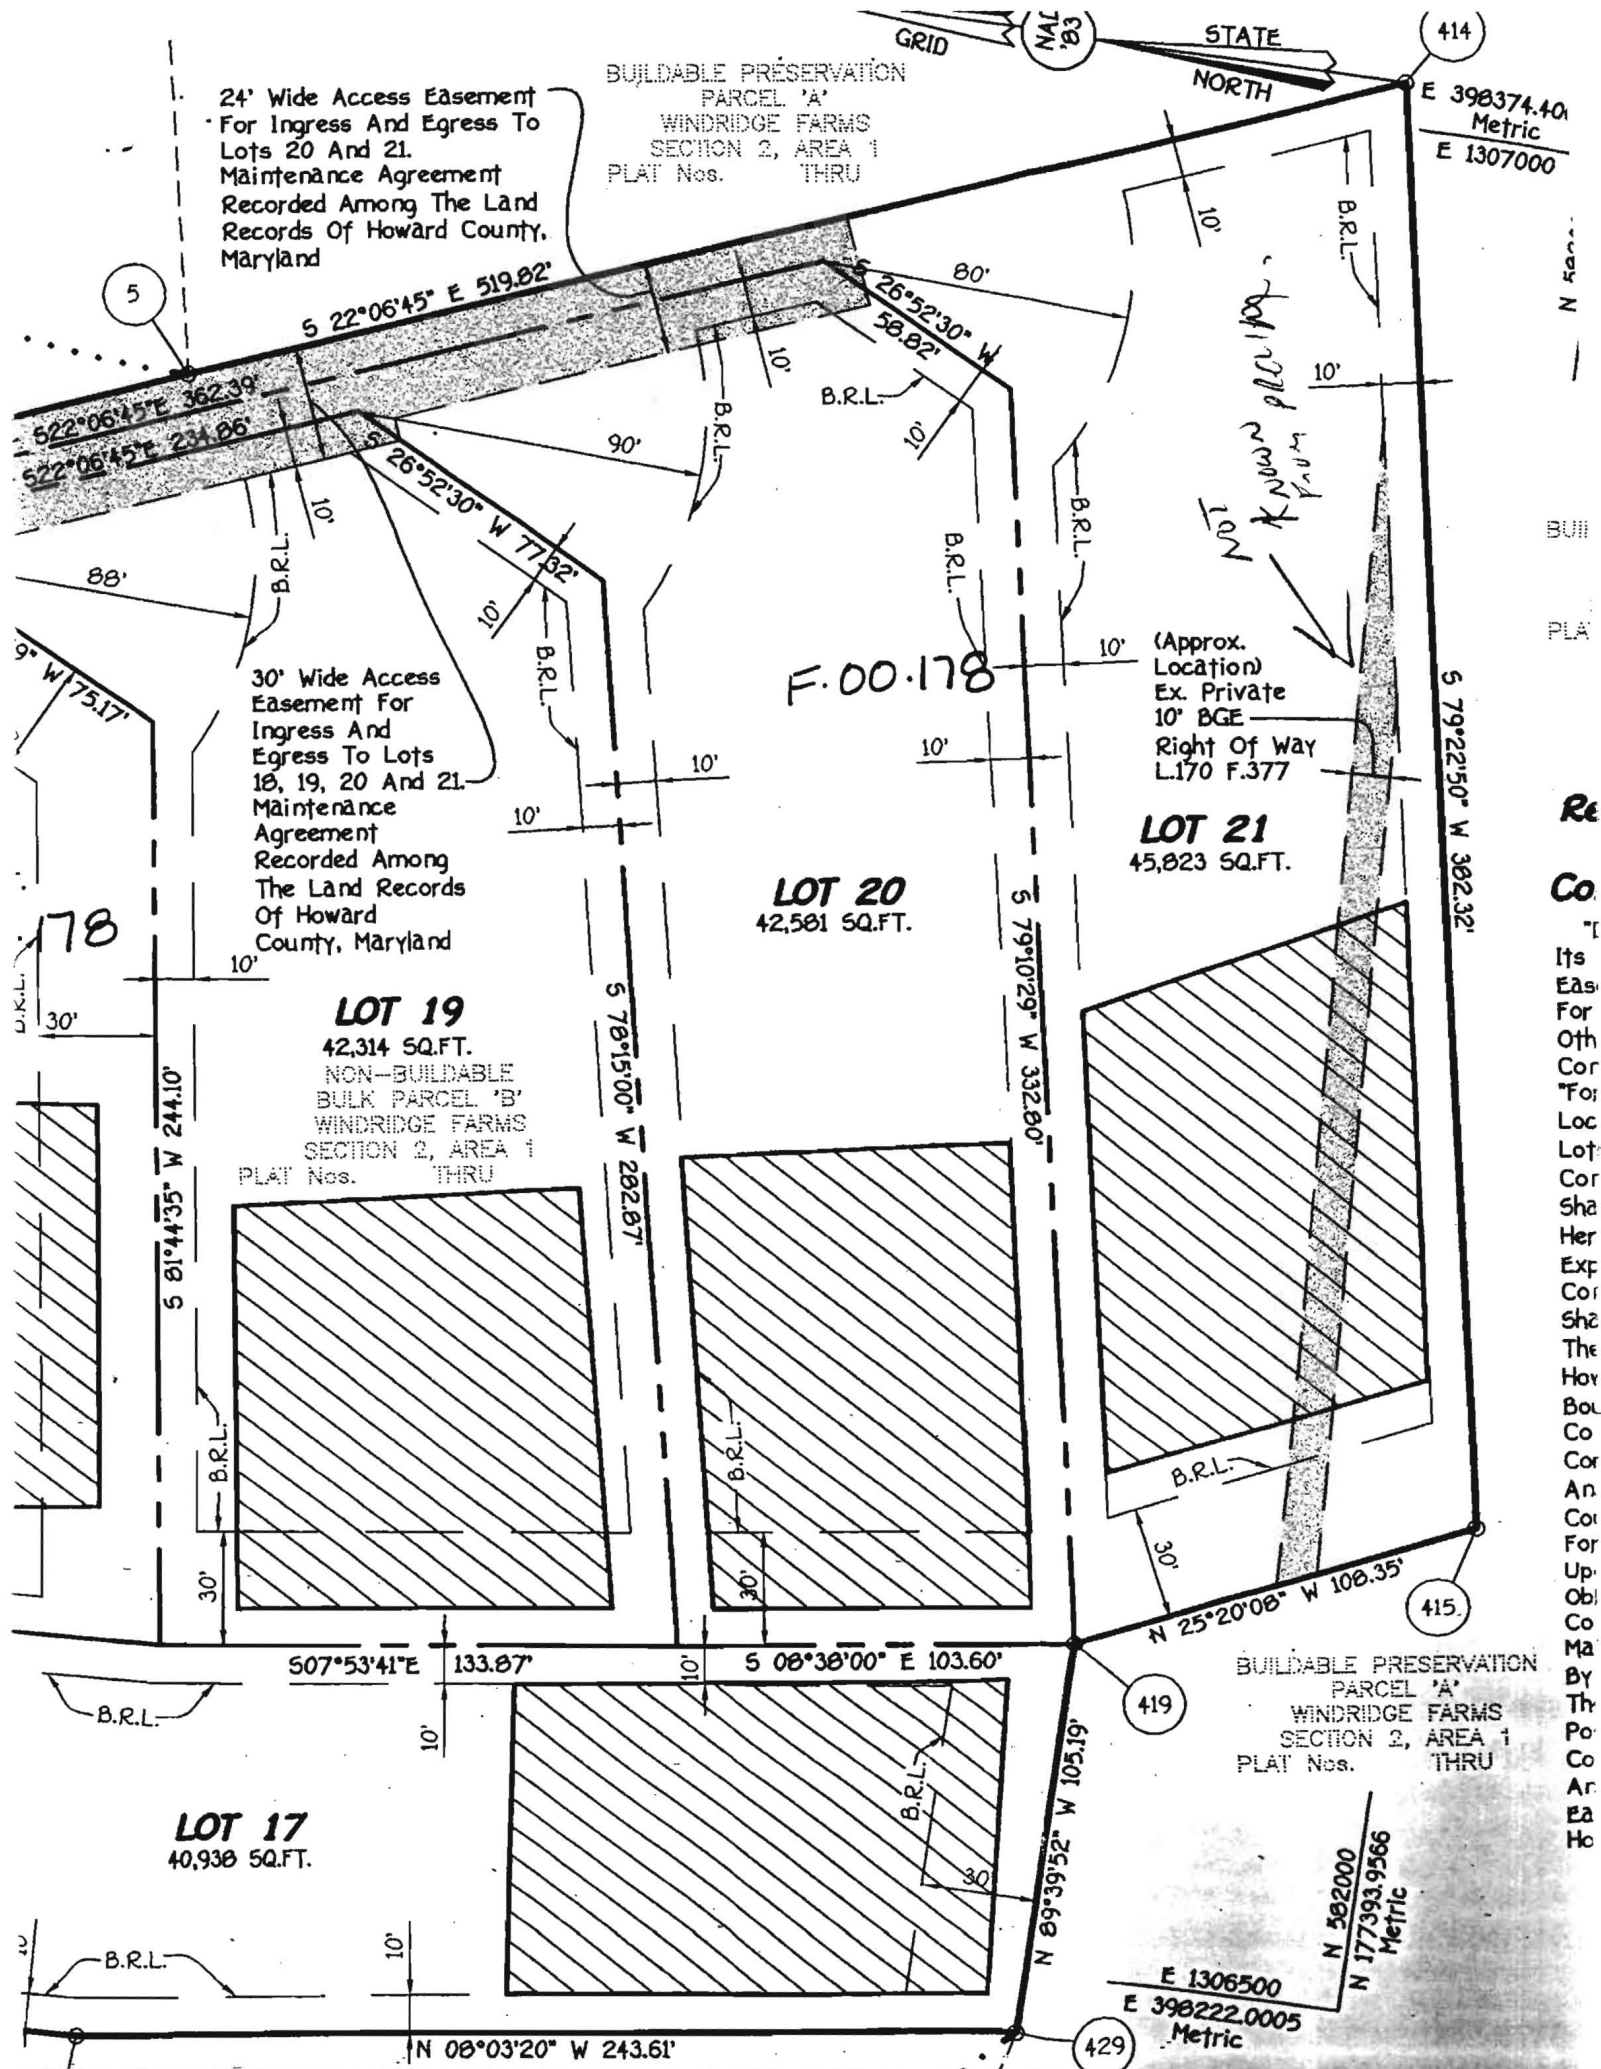

cess
gress
21.
orded
Of
d

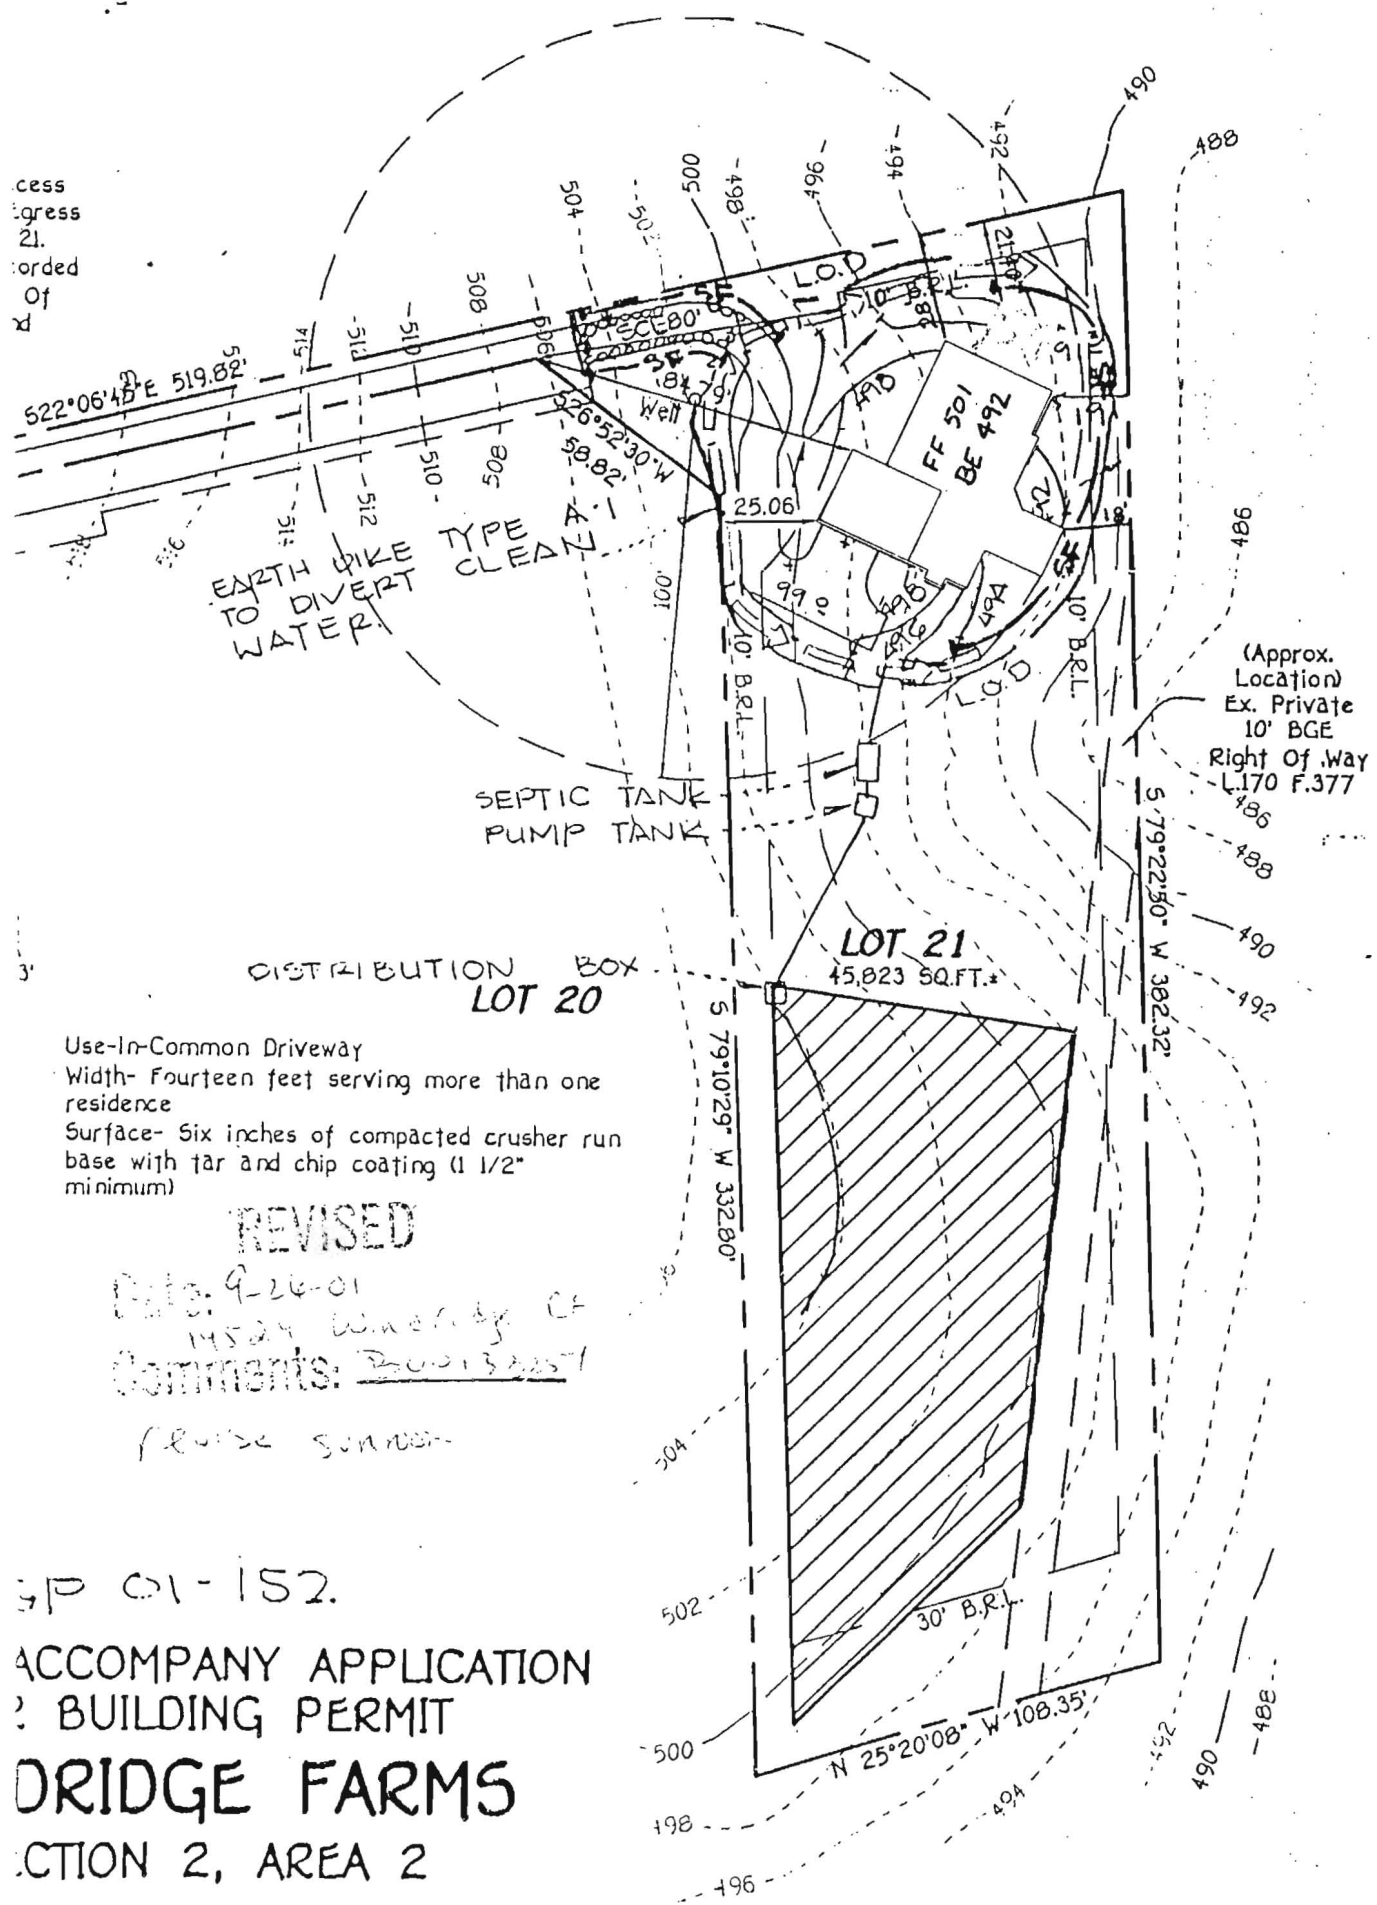

Use-In-Common Driveway
Width- Fourteen feet serving more than one residence
Surface- Six inches of compacted crusher run base with tar and chip coating (1 1/2" minimum)

REVISED

Date: 9-26-01
14524 W. 145th St.
Comments: 200132251
Please submit

SP 01-152.

ACCOMPANY APPLICATION
FOR BUILDING PERMIT

BRIDGE FARMS

SECTION 2, AREA 2

WINDRIDGE PERC HOLES

Lot 9 – 2D, 2G, 3A, 3B, 3D, 3E

Lot 10 – 4A, 4B, 4C, 4C2, 4D, 4D2, 4F

Lot 11 – 5A, 5B, 5B2, 5C, 5E, 6D

Lot 12 – 6B, 6C, 6G, 6F, ?, 7G

Lot 13 – 6F, ?, 7B, 7D, 7E, 7F, 7G, ?, 7I, 7H

Lot 14 – 8A, 8B, 8B2, 8C, ?, ?, ?, 8D

Lot 15 – 8B, 8B2, 8C, ?, ?, 9C, 9D, 10A

Lot 16 – 10A, ?, 10B/11A, ?, 10C/11D, 10E, 11B

Lot 17 – 10B/11A, ?, 11B, 11C, 12F, 14D, 15D/14C

Lot 18 – 12C, 13A, 13D, 14A, 14D

Lot 19 – 14A, 14B, 15D/14C, 14D

Lot 20 – 14B, 15D/14C, 15A, 15B, 16D/15C

Lot 21 – 15A, 15B, 16A, 16D/15C, 16B, 16C, 16E

Lot 22 – 19A, 19B, 19C, 19D, 19E

Lot 23 – 19B, 19C, 20A, 20B, 20C, 20D

Lot 24 – 20D, 20F, 20G, 21A

Lot 25 – 21A, 21B, 21C, 21D, 21E, 21F

**HAMILTON
REED**



ff 025.10
check # 7146
CR 1245-417
9-27-01

RECEIVED ²⁶ September 18, 2001

Howard County DILP

Re: Amendment: B-00130254
14529 Windridge Court

SEP 26 2001

LICENSES & PERMITS
DIVISION

Dear Sir or Madam;

Please receive this application for amendment to permit number B-00130254 for Lot 21 at Windridge Farms. The amendment is to move the Sunroom from the left side of the house to the rear as shown. If you have any questions regarding this application please do not hesitate to call.

Sincerely;

Tom
Tom Kozlowski
410-984-0349

HCHD 1/4/02
OK SRK

DPZ
James
9/27/01
O.K

For
Health
Dept

PR
Eng
Health
P#2