

HOWARD COUNTY
PERMIT APPLICATION

PERMIT NUMBER

B00136576

Building Address 14553 Windridge Ct.
Glenwood, Md 21738

Suite/Apt. #: _____ SDP/WP/Petition #: _____

Census Tract 0010 Subdivision Windridge Farms

Section 2 Area 2 Lot 17

Tax Map 21 Parcel 31 Grid 17

Zoning R1-100 Map Coordinates 9D10 Lot size _____

Property Owner's Name John + Marie Isaac

Address 14553 Windridge Ct

City Glenwood State Md Zip Code 21738

Home Phone 301-854-6339 Work Phone _____
Applicant's Name & Mailing Address, (if other than stated hereon):

N/A

Phone _____ Fax _____

Existing Use SFH

Proposed Use SFH w/Deck

Estimated Construction Cost \$ 2,000

Description of Work Construct 424 sq

deck w/ two sets of steps to
10x12 + 14x20 2 level deck grade

Contractor Company Double D Const.

Contact Person Dave Dunshee

Address 4754 Woodland Rd

City Ellicott City State Md Zip Code 21042

License No. 33426

Phone 410-740-4433 Fax 410-740-4828

Occupant or Tenant _____

Contact Name Same

Address _____

City _____ State _____ Zip Code _____

Phone _____ Fax _____

Engineer or Architect Company _____

Contact Person N/A

Address _____

City _____ State _____ Zip Code _____

Phone _____ Fax _____

BUILDING DESCRIPTION - COMMERCIAL

BUILDING DESCRIPTION - RESIDENTIAL

Building Characteristics

Utilities

Height: _____
No. of stories: _____
Gross area, sq. ft. per floor: _____
Use group: _____
Construction type:
____ Reinforced Concrete
____ Structural Steel
____ Masonry
____ Wood Frame
____ State Certified Modular

Water Supply:
____ Public
____ Private
Sewage Disposal:
____ Public
____ Private
Electric Yes ☐ No ☐
Gas Yes ☐ No ☐
Heating System:
Electric ☐ Oil ☐
Natural Gas ☐
Propane Gas ☐
Sprinkler system: N/A ☐
____ Full
____ Partial
____ Other Suppression
____ # of Heads

Building Characteristics

Utilities

SF Dwelling ☒ SF Townhouse ☐
____ Depth ____ Width
1st floor: _____
2nd floor: _____
Basement: _____
Finished Basement ☐ Unfinished Basement ☐
Crawl space ☐ Slab on Grade ☐
No. of Bedrooms _____
Multi-family dwellings:
No. of efficiency units: _____
No. of 1 BR units: _____
No. of 2 BR units: _____
No. of 3 BR units: _____
Other Structure: _____
Dimensions: _____
Footings: _____
Roof: _____
____ State Certified Modular
____ Manufactured Home

Water Supply:
____ Public
____ Private
Sewage Disposal:
____ Public
____ Private
Electric Yes ☒ No ☐
Gas Yes ☐ No ☒
Heating System:
Electric ☒ Oil ☐
Natural Gas ☐
Propane Gas ☐
Sprinkler system: N/A ☐
____ NFPA #13D
____ NFPA #13R
____ Other

THE UNDERSIGNED HEREBY CERTIFIES AND AGREES AS FOLLOWS: (1) THAT HE/SHE IS AUTHORIZED TO MAKE THIS APPLICATION; (2) THAT THE INFORMATION IS CORRECT; (3) THAT HE/SHE WILL COMPLY WITH ALL REGULATIONS OF HOWARD COUNTY WHICH ARE APPLICABLE THEREIN; (4) THAT HE/SHE WILL PERFORM NO WORK ON THE ABOVE REFERENCED PROPERTY NOT SPECIFICALLY DESCRIBED IN THIS APPLICATION; (5) THAT HE/SHE GRANTS COUNTY OFFICIALS THE RIGHT TO ENTER ONTO THIS PROPERTY FOR THE PURPOSE OF INSPECTING THE WORK PERMITTED AND POSTING NOTICES.

Applicant's Signature

Title/Company

Print Name

Date

Checks payable to: DIRECTOR OF FINANCE OF HOWARD COUNTY
** PLEASE WRITE NEATLY AND LEGIBLY. **

FOR OFFICE USE ONLY

AGENCY

DATE

SIGNATURE APPROVAL

DPZ SETBACK INFORMATION

PROPERTY ID#

and Development DPZ

Front

Filing fee

\$

The seal of the State of Maryland is visible in the bottom right corner of the document. It features a circular design with the text "STATE OF MARYLAND" around the perimeter and a central emblem depicting a ship.

BURNABLE PRESERVATION PARCEL "A"
WINDRIDGE FARMS SEC 2, AREA 1
PLAT NO. 14319 THUR 14322

1.50 +

DETAL
1-50

WINDRIDGE COURT
1407 E. 11th

21 FURNISHED SUBJECT TO ALL EASEMENTS AND CONDITIONS OF RECORD.

27 107

210
257+
257+

Deck
Deck
OK

— 702
BAY WIDOW

~~DAY WOOD~~

Public Trust
Administration
WALK

COVERED BRICK STOMP N 67.3° E 90.6°
A BRICK STOMP

Approved Septic System Plan Howard County Health Department

Signature [Signature] Date 12/1/01

Total linear feet of trench required 240 feet

Width of trench(es) 3.0 feet

Depth of trench(es) 5.0 feet


Depth of stone required below distribution pipe 2.0 feet

STANDARD SYMBOL
ION
FENCE POST DENIES
HORIZONTAL IS INTO
THE GROUND
UNSTURBED
GROUND
GROUND 20' ABOVE
GROUND

GENERAL NOTES

1. SEPTIC EASEMENT SUBJECT TO HOWARD COUNTY HEALTH DEPARTMENT
 2. PROPOSED 1500 GALLON SEPTIC TANK
 3. CONTRACTOR / BUILDER TO VERIFY ELEVATIONS IN FIELD BEFORE BEGINNING ANY CONSTRUCTION
 4. LENGTH OF TRENCH TO BE DETERMINED AT TIME OF SEPTIC PERMIT
 5. RESURFACE
- A. FIRST FLOOR ELEVATION 509.40
B. BASEMENT ELEVATION 500.40
C. INVERT OF SEPTIC SYSTEM AT HOUSE 499.70
D. INVERT IN AT SEPTIC TANK 490.70
E. INVERT OUT AT SEPTIC TANK 490.70
F. PROPOSED GRADE OVER SEPTIC TANK 501.00
G. INVERT AT DISTRIBUTION BOX 496.00
H. EXISTING GROUND OVER DISTRIBUTION BOX 499.00

WINDRIDGE COURT

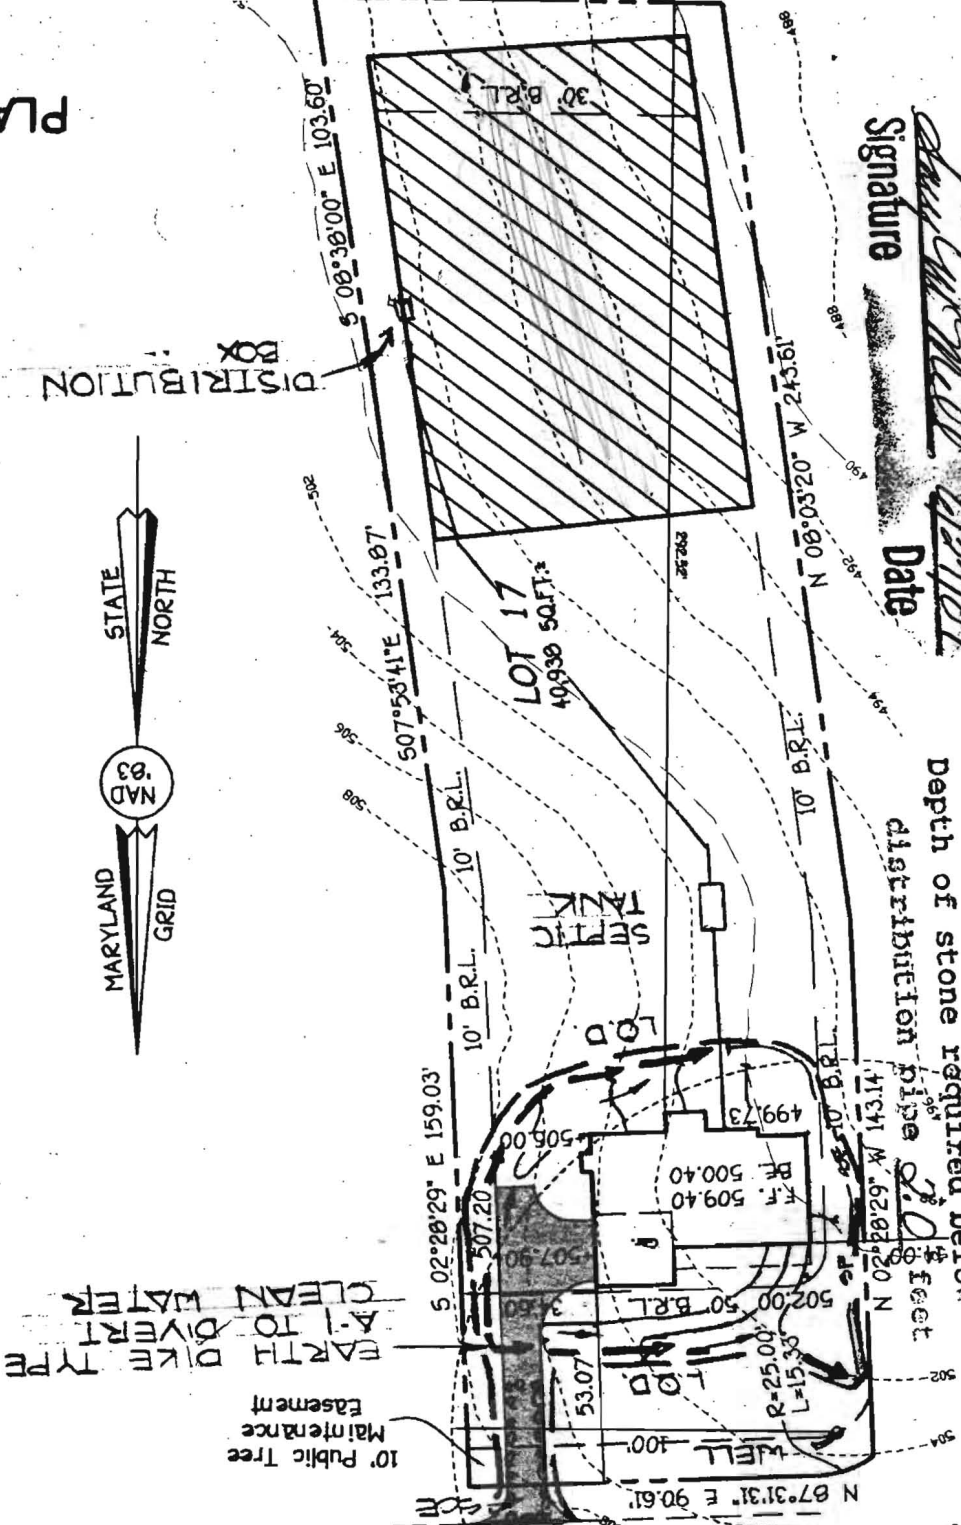

PLAN TO ACCC
FOR BU
GP