



CAT-A

verlapped,

stained when
ric height.

Approved Septic System Plan Howard County Health Department

Total linear feet of trench
required 240 feet


Width of trench(es) 3.0 feet

Depth of trench(es) 4.0 feet

Depth of stone required below
distribution pipe 2.0 feet

9% grade on

Amelia Miller 6/1/01
Signature Date

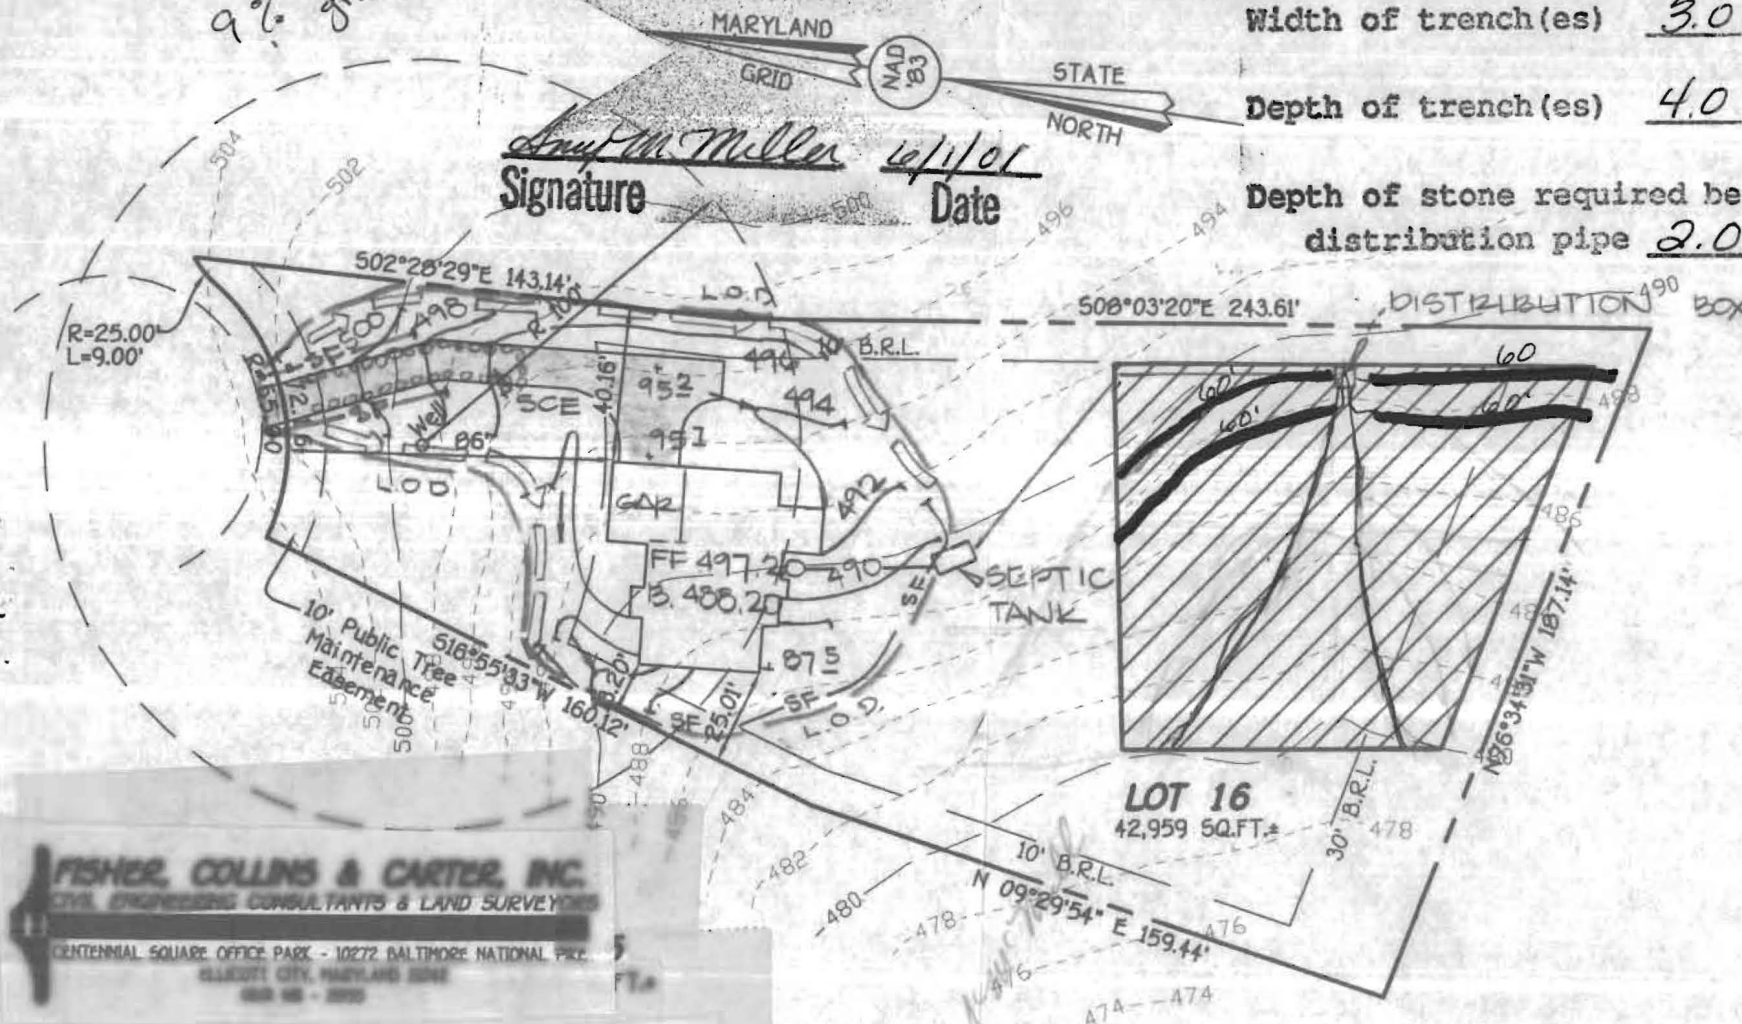

FISHER, COLLINS & CARTER, INC.
CIVIL ENGINEERING CONSULTANTS & LAND SURVEYORS
CENTENNIAL SQUARE OFFICE PARK - 10272 BALTIMORE NATIONAL PIKE
ELLSWORTH CITY, MARYLAND 21041
410-488-1000

GENERAL NOTES

1. SEPTIC EASEMENT SUBJECT TO HOWARD COUNTY HEALTH DEPARTMENT
2. PROPOSED 1500 GALLON SEPTIC TANK.
3. A. FIRST FLOOR ELEVATION: 497.20
B. BASEMENT ELEVATION: 488.20
C. INVERT OF SEPTIC SYSTEM AT HOUSE: 489.50
D. INVERT IN AT SEPTIC TANK: 488.30
E. INVERT OUT AT SEPTIC TANK: 488.30
F. PROPOSED GRADE OVER SEPTIC TANK: 489.70
G. INVERT AT DISTRIBUTION BOX: 487.0
H. EXISTING GRADE OVER DISTRIBUTION BOX: 489.00
4. LENGTH OF TRENCH TO BE DETERMINED AT TIME OF SEPTIC PERMIT ISSUANCE.
5. CONTRACTOR - BUILD TO VERIFY ELEVATIONS IN FIELD BEFORE BEGINNING ANY CONSTRUCTION.

G.P. 01-150

PLAN TO ACCOMPANY APPLICATION
FOR BUILDING PERMIT

WINDRIDGE FARMS

SECTION 2 AREA 2

owner/builder Hamilton Kead