

APPLICATION

A 24664

P _____

SEWAGE DISPOSAL TESTING

STATE OF MARYLAND - DEPARTMENT OF HEALTH AND MENTAL HYGIENE

HOWARD COUNTY HEALTH DEPARTMENT 4 B.R. 5 B.R. DISTRICT 3

ENVIRONMENTAL HEALTH SERVICES 1250 gal. septic 1500 gal. septic tank DATE 11/3/76

P. O. BOX 476, ELLICOTT CITY, MARYLAND 21043

TELEPHONE: 465-5000, EXT. 356

effective sidewall absorption area for bedroom to begin below the first 4 ft. of non-porous soil. Maximum depth permitted for drywell or trench is 10 ft. below original grade. Place the drywell 175 ft. from the 1147 ft long lot line and 120 ft from the 488.00 ft. long lot line. Start the 1st trench after a 5 foot earth buffer with the drywell and proceed to dig it on level ground. Start the 2nd trench parallel to the first trench and 14 ft away from the first trench. Connect the trenches in series with the drywell.

NOTE: No trench may exceed 100 ft. in length.

NOTE: Call for inspection of trench before gravel is installed.

NOTE: Maintain at least 75 ft. between water well and disposal area (drywell and trench)

NOTE: No drywell may exceed 15" in width

THE COUNTY HEALTH OFFICER

ELLICOTT CITY, MARYLAND

I, HEREBY, APPLY FOR THE NECESSARY TEST IN ORDER TO CONSTRUCT (OR RECONSTRUCT) A SEWAGE DISPOSAL SYSTEM.

PROPERTY OWNER L.A.M., Inc. Kenneth Strauss

ADDRESS 4645 Old Court Rd. Mrs Lillian Podell Pikesville, Md. Any questions call

43 Peble Drive, Balto., Md. 21225 789-4500 Browne Associates

PROPERTY LOCATION:

SUBDIVISION Berndell Estates LOT NO. 11

ROAD AND DESCRIPTION 910 River Rd. & Rt. 32

SIZE OF LOT 5.479 Acres TYPE BLDG. 3 or 4

IF NOT SINGLE RESIDENCE DESCRIBE Single Fmly Dwelling NUMBER OF BEDROOMS

THE SYSTEM INSTALLED UNDER THIS APPLICATION IS ACCEPTABLE ONLY UNTIL PUBLIC FACILITIES BECOME AVAILABLE.

SIGNATURE OF APPLICANT Mrs Lillian Podell BLDG. PERMIT SIGNED

APPROVED BY R. Monifield W. J. Skinner AND RETURNED 6/7/78

REJECTED BY _____ FOR Dw & Trench DATE 2/16/77

HOLD PENDING FURTHER TESTS _____ DATE _____


REASONS FOR REJECTION OR HOLDING _____

THIS IS NOT A PERMIT

Lot 11

0 - clay
3-5

1 - sandy
loam
(some clay)
13

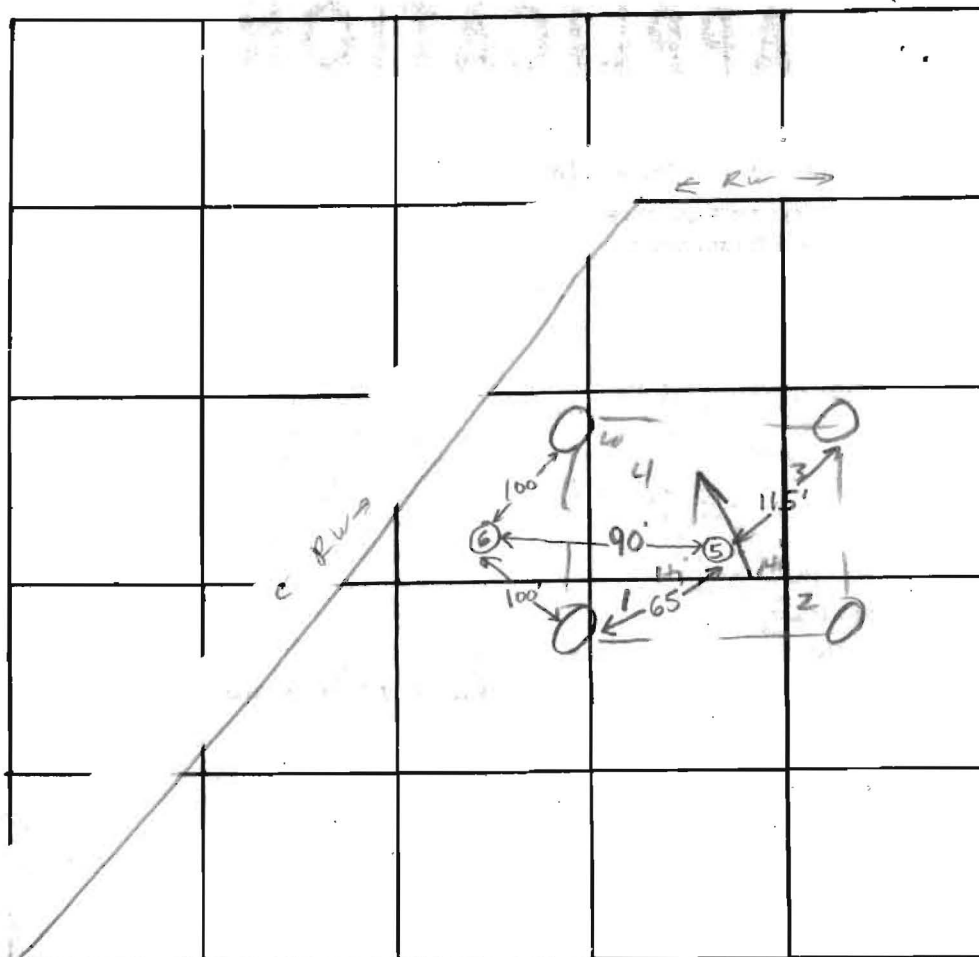

INDICATE NORTH. - NAME ADJOINING ROADWAY AS BASE LINE

DATE	TEST NO.	DEPTH	PRE-WET		TEST - 1" DROP		TIME
			START	STOP	START	STOP	
11/17/06	1	4	10 ²⁰	10 ²⁵	10 ²⁵	10 ⁵²	27
	1A	13	10 ²⁰	10 ²³	10 ²³	10 ³³	10
	2	13	4:15				
	3	5	10 ⁴⁸	10 ⁵⁹	10 ⁵⁹	11 ¹⁴	15
	3A	13	10 ⁴⁵	10 ⁵²	10 ⁵²	11 ⁰³	8
	4	4	10 ⁴⁵	10 ⁵⁰	10 ⁵⁰	11 ⁰³	10
	4A	13	10 ⁴⁵	10 ⁵⁰	10 ⁵⁰	10 ⁵⁸	8

REMARKS _____

TYPE OF SOIL _____

TESTED BY R.M. ALSO PRESENT: _____

APPLICATION

A 27282

P

SEWAGE DISPOSAL TESTING

STATE OF MARYLAND - DEPARTMENT OF HEALTH AND MENTAL HYGIENE

HOWARD COUNTY HEALTH DEPARTMENT
ENVIRONMENTAL HEALTH SERVICESP. O. BOX 476, ELLICOTT CITY, MARYLAND 21043
TELEPHONE: 465-5000, EXT. 356DISTRICT 3rdDATE 12/1/77TO: THE COUNTY HEALTH OFFICER
ELLICOTT CITY, MARYLAND

I, HEREBY, APPLY FOR THE NECESSARY TEST IN ORDER TO CONSTRUCT (OR RECONSTRUCT) A SEWAGE DISPOSAL SYSTEM.

PROPERTY OWNER L.A.M., Inc.4615 Old Court Rd.ADDRESS Mrs. Lillian Podell Pikesville, Md.Any questions call
PHONE Browne Associates

PROPERTY LOCATION:

SUBDIVISION Berndell EstatesLOT NO. 11ROAD AND DESCRIPTION River Rd. & Rt. 32SIZE OF LOT 5.479 AcresTYPE BLDG. 3 or 4

NUMBER OF BEDROOMS

IF NOT SINGLE RESIDENCE DESCRIBE

Single Fmly Dwelling

THE SYSTEM INSTALLED UNDER THIS APPLICATION IS ACCEPTABLE ONLY UNTIL PUBLIC FACILITIES BECOME AVAILABLE.

SIGNATURE OF APPLICANT Mrs. Lillian Podell

APPROVED BY _____ FOR _____ DATE _____

(KIND OF SYSTEM)

REJECTED BY _____ FOR _____ DATE _____

(KIND OF SYSTEM)

HOLD PENDING FURTHER TESTS _____ DATE _____

REASONS FOR REJECTION OR HOLDING _____

THIS IS NOT A PERMIT

See attached original application for sketch

INDICATE NORTH - NAME ADJOINING ROADWAY AS BASE LINE

DATE	TEST NO.	DEPTH	PRE-WET		TEST - 1" DROP		TIME
			START	STOP	START	STOP	
12/1/77	5	6'	10:00	—	—	10:07	7 min
	5A	14'	9:59	—	—	10:09	10 min
	6	5'	10:28	10:35	10:35	10:45	10 min
	6A	12 1/2'	Same soil; sandy loam as (5)				

inv. 4'

REMARKS

TYPE OF SOIL

sandy loam below top ~ 4-5' clayey soil

TESTED BY

F.S.

ALSO PRESENT:

Strauss & Lendrum
R. Hayes