PERMIT

MARYLAND STATE DEPARTMENT OF HEALTH

HOWARD COUNTY

INDEXED


ELLICOTT CITY 4-15-68

Richard Lowe	IS PERMIT	TED TO INSTALL ALTER X
DDRESS Ellicott City, Ilchester Rd.	21043	PHONE RI7-7598
SEWAGE DISPOSAL-SYSTEM LOCATED AT		Constitution of the second
UBDIVISION	_ROAD	LOT
ROPERTY OWNER Floyd Collins one	A + Dean	Lally
DDRESS 1704 Woodstock Rd. Woodsto	ck, Md.	Second house on left after pass Breezewood Farm.
PECIFICATIONS		Louse this side of P. a
DRAIN FIELDFEE	r, BOTTOM AREA	SQ. FT.
SEEPAGE PITS ABSORBENT SIDE	E-WALL AREA	SQ. FT.
SEPTIC TANK CAPACIT	YGAL	LONS
FOR GARBAGE GRINDER, INCREASE DI	SPOSAL AREA 22% &	TANK CAPACITY 50%.
OTHER 300 sq. ft. Drywell?		
	Later Williams	The Control of the Co
STATE OF THE STATE OF THE STATE OF	to device on	
PERMIT VOID AFTER THREE YEARS.	der en	
PLANS APPROVED BY	DATE	A LATERACK STREET, STREET, STREET,
LANS AFFROYED BI		

UNTIL INSPECTED AND APPROVED.

NEITHER THE HOWARD COUNTY COMMISSIONERS NOR THE HEALTH DEPARTMENT IS RESPONSIBLE FOR THE SUCCESSFUL OPERATION OF ANY SYSTEM.

NOTIFY THE HEALTH DEPARTMENT 48 HOURS BEFORE EXCAVATIONS ARE TO BE BACK FILLED.

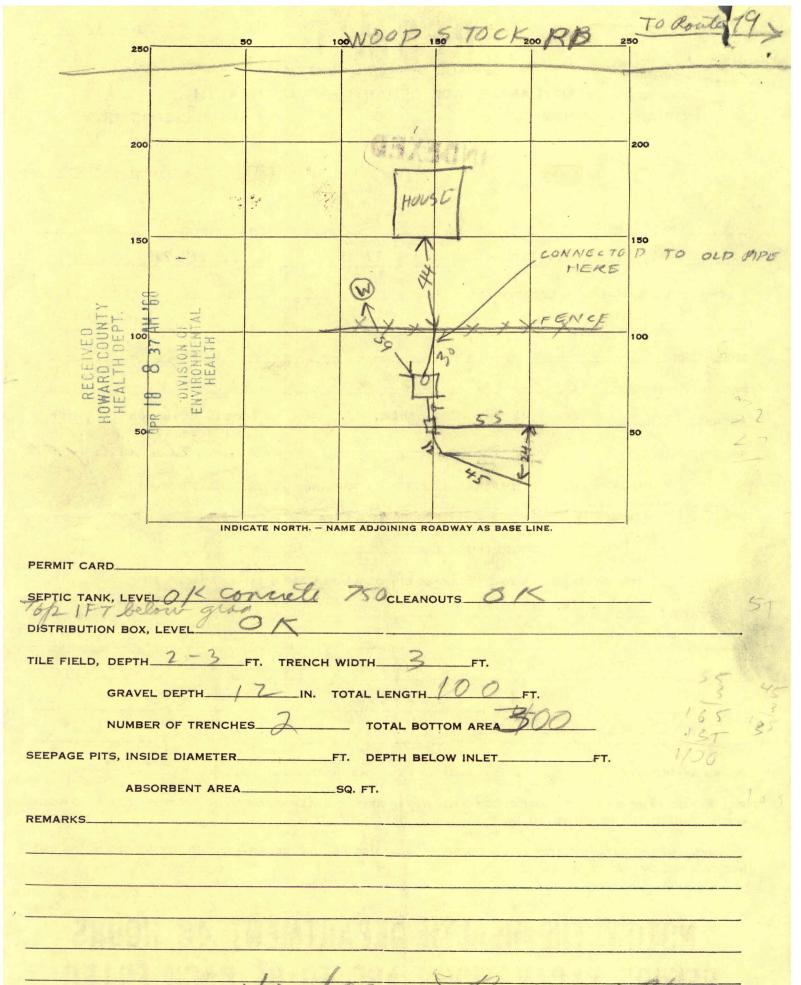

DATE SYSTEM APPROVED 41716 INSPECTOR SUPPLY 1908