Permits: 410-313-2455 Inspections: 410-313-1810 Automated Line: 410-313-3800 Howard County Building/Fire Permit Application Department of Inspections, Licenses & Permits 3430 Court House Drive

Ellicott City, MD 21043

1	
Dormit	Numbe
remm	Nullibe

/	20	
1		21
-	7	10
	10	4

Building Address: 10 /				Property Owner's Name:	# # 100 to		11.200
baylon,	MU	X1036		Address: 3675 PARK A			1.70
1.'		1-P-10-	68	City: 2011 of City State:	ND	Zip Code:	115
Suite/Apt. #	SDF	P/WP/BA#: 6/-10-	AF	Home Phone:	Work Phone	:440 - 750	9/21
Census Tract:		Subdivision:	DAKS	Applicant's Name & Mailing Addre			
Section:	Ar	ea: Lot:		Applicant's Name & Maining Addre	33, (11 other than	r stated merenn,	
Гах Мар: 🔍 🔍	Parcel:	90 Grid:	19				
Zoning: Ma	p Coordina	RIB 9B Lot Size:	45,477	Phone: 10-790-9002	Fax: 40-	150-900	13
Existing Use: VAC	MAIT	(0)		Email:			
Proposed Use:				Contractor Company:	TWALT	THME	5
Estimated Construction Cos	. Au	14 000		Contact Person:	MENIX	HHW	
				Address: 3675 FARICA			
Description of Work:		100 13	1 francis	City: City: State:	Zip C	ode: Oll	and why
RSTORY, FULL	460	MI, 9K, AL	8,	License No. : 699	- 122	7 C 70 - 75 -	und it s
111B FR+	-AL	AGE (4BK)	W	Phone: 4/10 7/50 9/10 2			1.4
Occupant or Tenant:	N	/A	В	Email:			
		DVec	□No	Engineer/Architect Company:	*		
Was tenant space previousl							
Contact Name:				Responsible Design Prof.:			~
Address:			* 1:	Address:		* .	
Citv:	2	State: Zip Code:		City:State:	Zip Co	ode:	
Phone:				Phone:			
Email:		V V		Email:			1
BUILDI	NG DESCRIP	PTION - COMMERCIAL			RIPTION – RESIDE		1
Building Characteri	stics	Utilities		Building Characteristics		Utilities	
Height:		Water Suppl	צ	☐ SF Dwelling ☐ SF Townhouse  Depth Width		Water Supply	,
No. of stories:		☐ Public		Depth Width  1 <sup>st</sup> floor:	Privat		
Gross area, sq. ft./floor:		☐ Private		2 <sup>nd</sup> floor:	- 1	Sewage Dispose	al .
		Sewage Dispo	<u>sal</u>	Basement:	□ Public	С	
Area of construction (sq. f	ft.):	☐ Public		☐ Finished Basement	□ Private		
		☐ Private		☐ Unfinished Basement	Electric:		□ No
Use group:		Electric: ☐ Yes	□ No	☐ Crawl Space ☐ Slab on Grade	Gas:	☐ Yes Heating System	□ No m
		Gas: ☐ Yes	□ No	No. of Bedrooms:	☐ Electi		<u></u>
Construction typ	e:	Heating Syste	<u>em</u>	Multi-family Dwelling	□ Oil		
☐ Reinforced Concrete		☐ Electric ☐ Oil		No. of efficiency units:	` Matu		
☐ Structural Steel	11	☐ Natural Gas ☐ Pro	pane Gas	No. of 1 BR units:	☐ Propa	ane Gas	
☐ Masonry	A 10 TO 10	Sprinkler Syste	em:_	No. of 2 BR units:			
☐ Wood Frame		□ N/A		No. of 3 BR units: Other Structure:			
☐ State Certified Modula	r	☐ Full		Dimensions:			
100	4	☐ Partial		Footings:			
	147	☐ Other Suppression		Roof:	-> V=		
		No. of Heads:		☐ State Certified Modular			
				☐ Manufactured Home			
THE PERIOD OF HOM	ADD COLINITY	WILLICH ARE ADDITIONED E THERETO	; (4) THAT HE/SHE Y	O MAKE THIS APPLICATION; (2) THAT THE INFORM WILL PERFORM NO WORK ON THE ABOVE REFEI OPERTY FOR THE PURPOSE OF INSPECTING THE WORLD THE	RENCED PROPERTY	NOT SPECIFICALLY L	DESCRIBED
OPERATIONS TRIA	117 B	MITYMIT	5				
Title/Company	. 3		- DIRECTOR C-	FINANCE OF HOWARD COUNTY			
			PLEASE WRITE N	FINANCE OF HOWARD COUNTY EATLY & LEGIBLY** CE USE ONLY-			
A OFFICE	DATE	SIGNATURE OF APPROVAL	DD7 SETDAG	K INFORMATION	Filing Fee	\$ 14-31	1 2 3
AGENCY	DATE	SIGNATURE OF APPROVAL	DPZ SETBAC	N INTONIVIATION	Permit Fee	\$	to the
			-ront'				


AGENCY	DATE	SIGNATURE OF APPROVAL
State Highways		
Building Officials		
PSZA (Zoning)		
PSZA ( Engineering )		
Health	11-16-11	Weed Sout
Fire Protection	100	1 / N

Is Sediment Control approval required for issuance? ☐ Yes ☐ No ☐ CONTINGENCY CONSTRUCTION START

 $\square$  ONE STOP SHOP

DPZ SETBACK INFORMATION		
Front:		5
Rear:	4	
Side:		
Side St.:		
All minimum setbacks met?	☐ Yes	□No
Is Entrance Permit Required?	☐ Yes	□No
Historic District?	☐ Yes	□No
Lot Coverage for New Town Z	one:	
SDP/Red-line approval date:		

Filing Fee	\$ /
Permit Fee	\$
Tech Fee	\$
Excise Tax	\$
PSFS	\$
Guaranty Fund	\$
Add'l per Fee	\$
Total Fees	\$
Sub- Total Paid	\$
Balance Due	\$

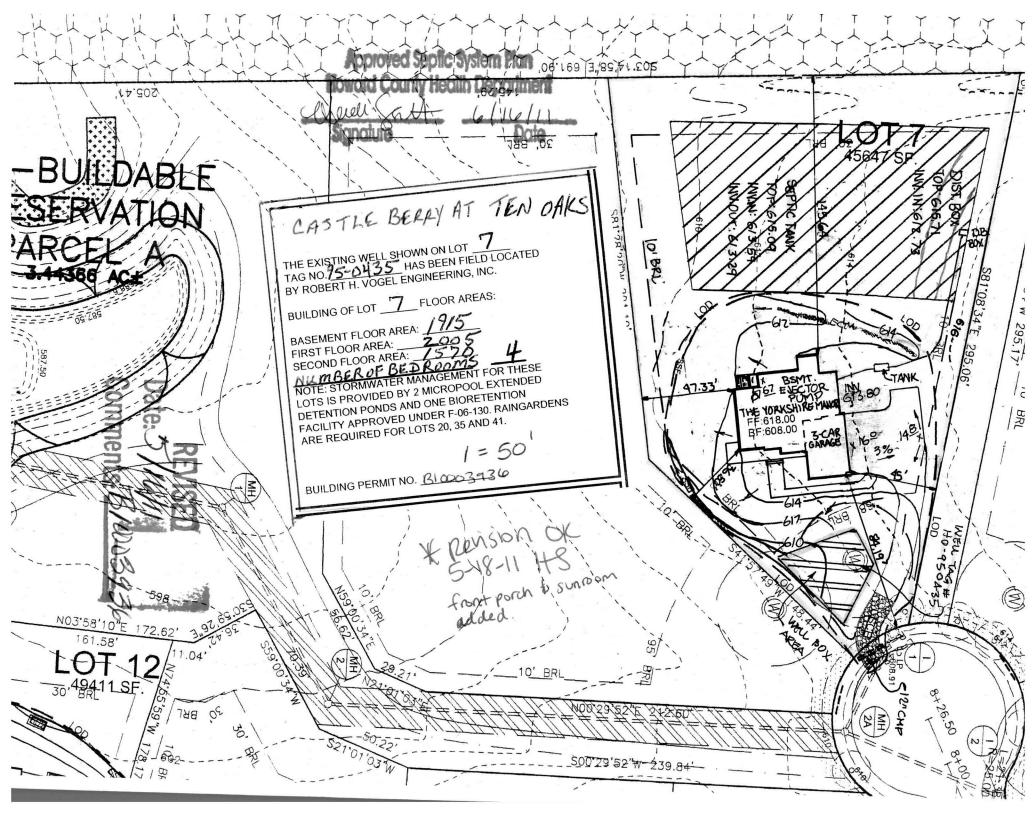

swam 1/10/11/00



dedicated to excellence and service

SHERRY L. MEWSHAW
Selections Director

Office: 410.750.9002 Fax: 410.750.9003 Email: sherry@trinityhomes.com TrinityHomes.com

Dear Avis Corbin,

May 13, 2011

RE: Building Permit # B10003936

Lot # 7 Castleberry at Ten Oaks

13721 Wye River Drive Dayton, MD 21036

Please approve the following changes to above permit. Front porch added.
9'8½" x 10'5" sunroom added.
2 sets of construction drawings are included.

Please call when approved.

Thank you,

Sherry Mewshaw Operations Trinity Quality Homes

CC: Zoning HECENTE